

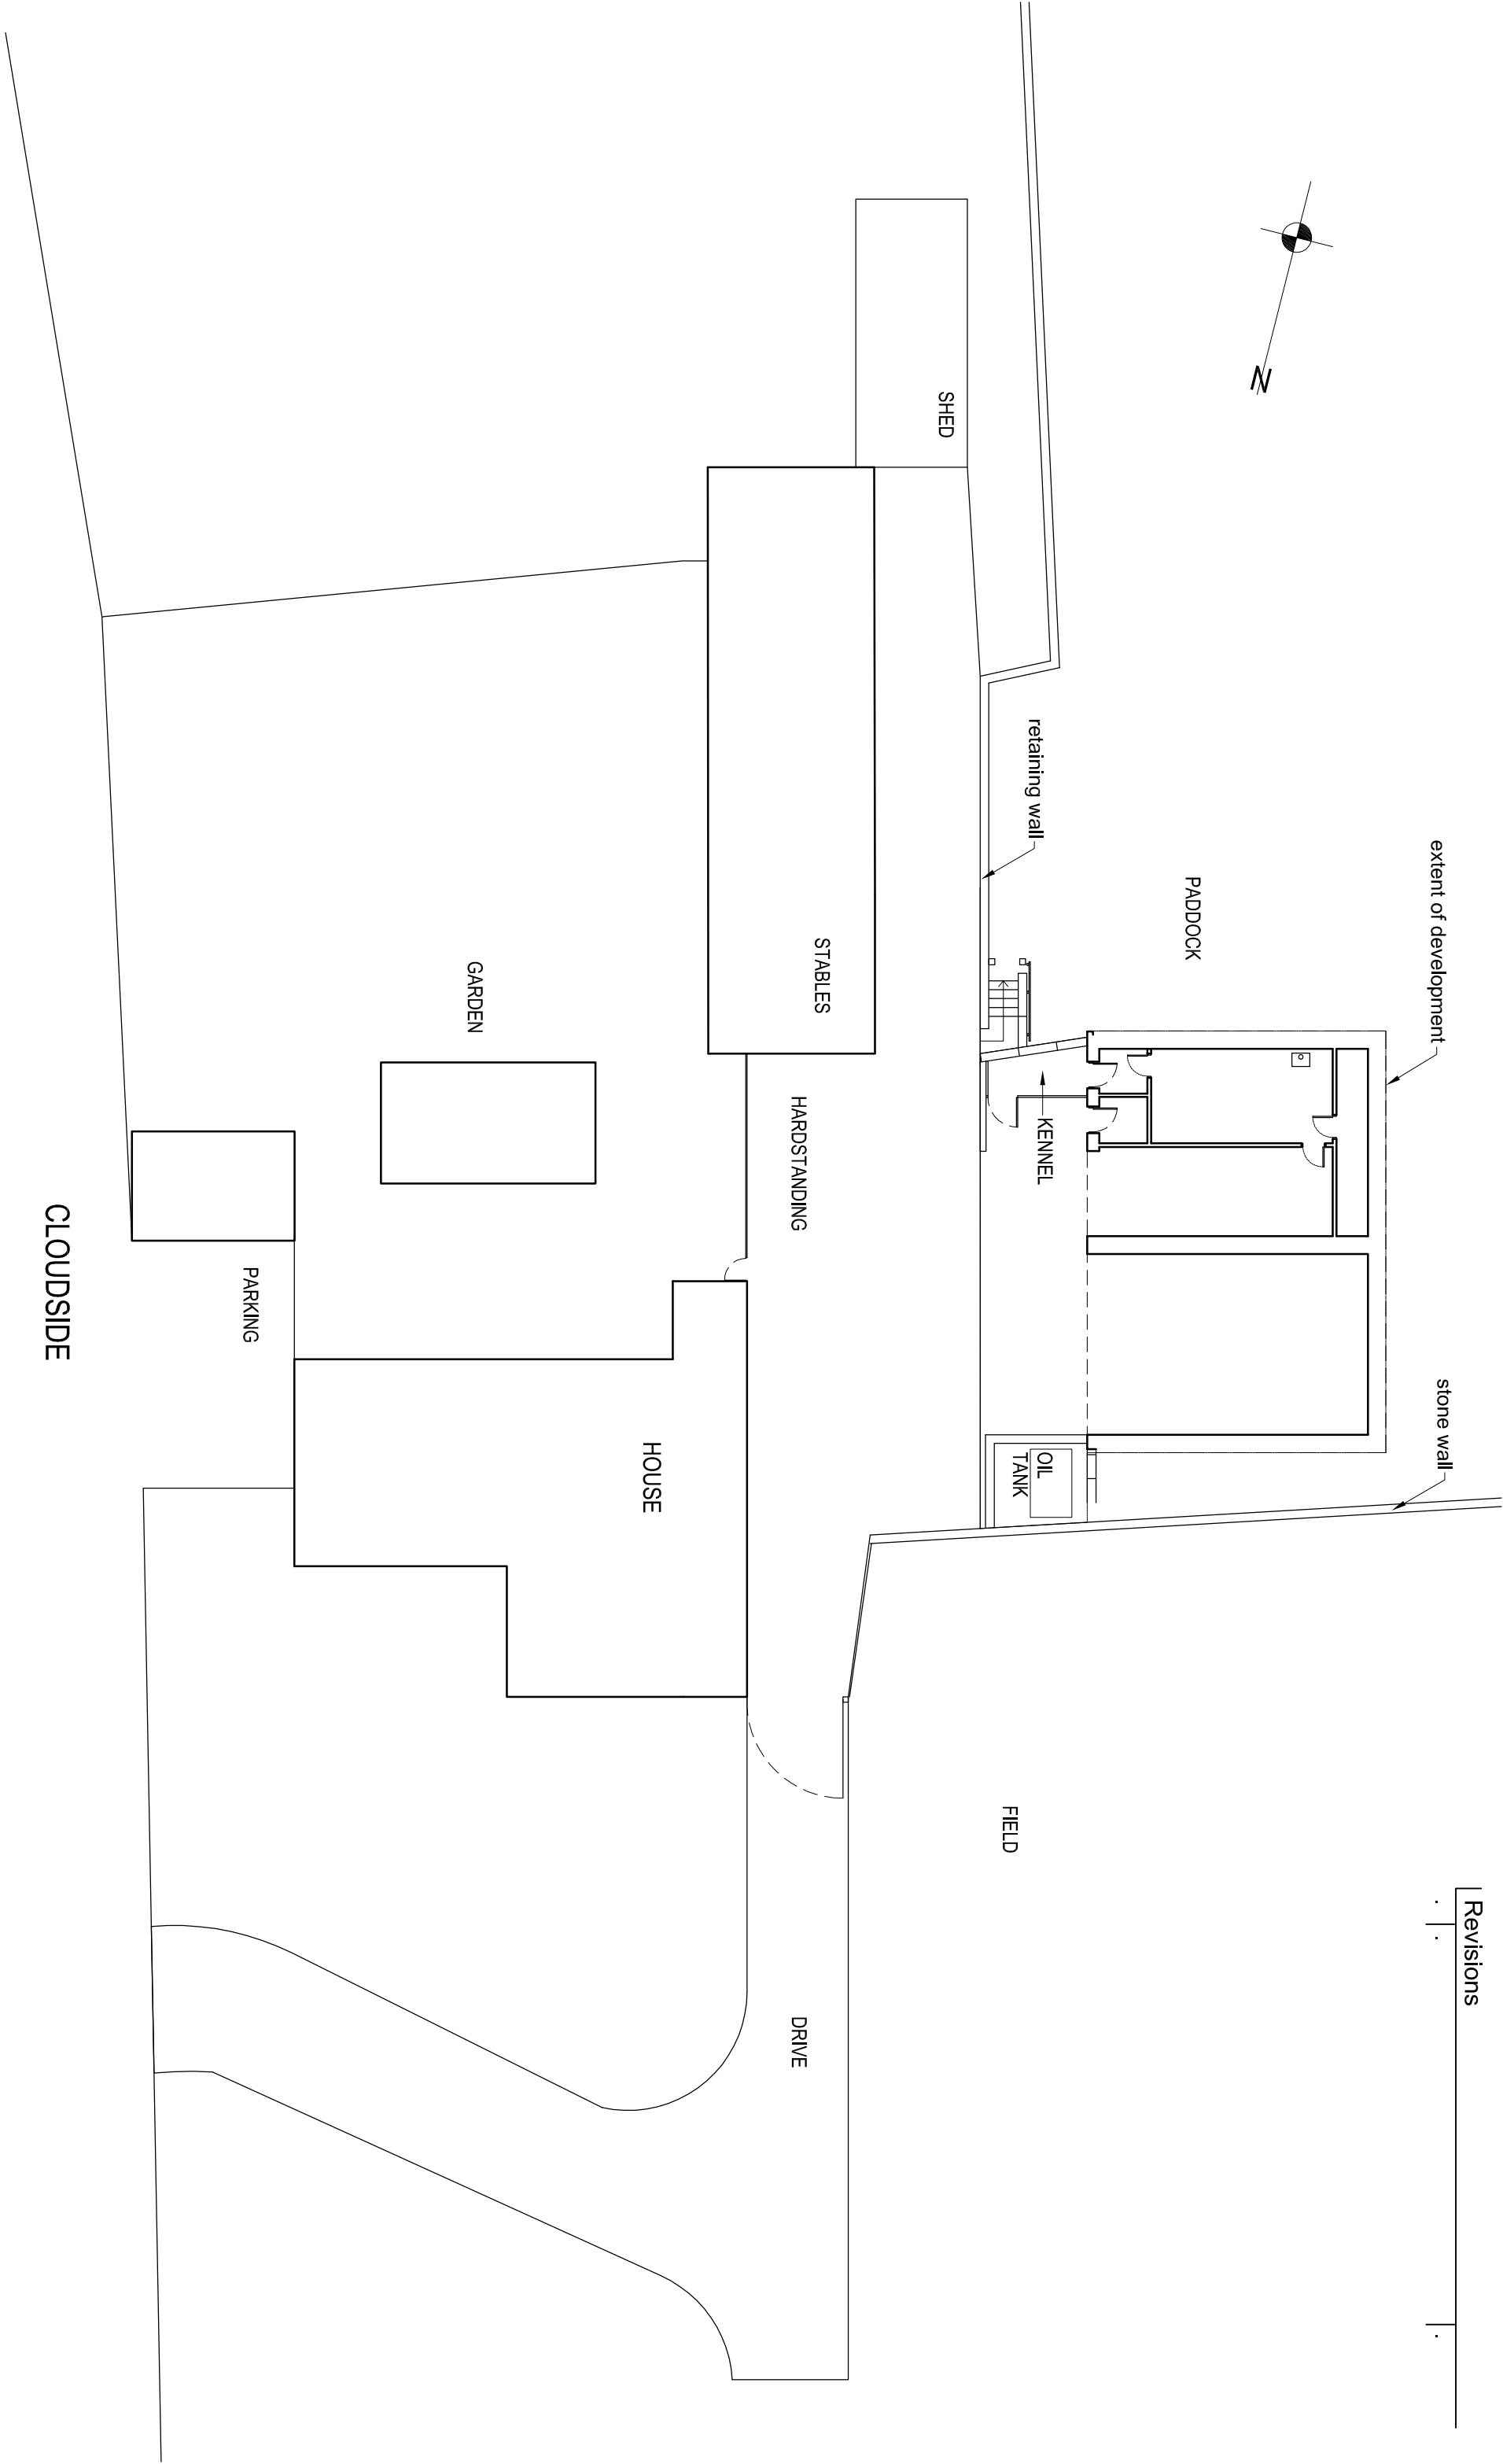


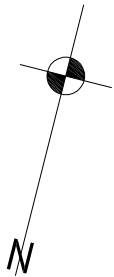

SITE/ BLOCK PLAN

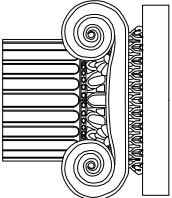

job Green Acres, Cloudside Garage Block		title Site/ Block Plan as Built	
date 04.10.16	scale 1/200 @ A3	dwg. no. G-01	rev. .
		Ian architects Building and Design Consultants Ryecroft Farm, Rushion Spencer, Macdestfield, SK11 0RP t 01260 546944 e ian@ianankers.co.uk w www.ianankers.co.uk	