


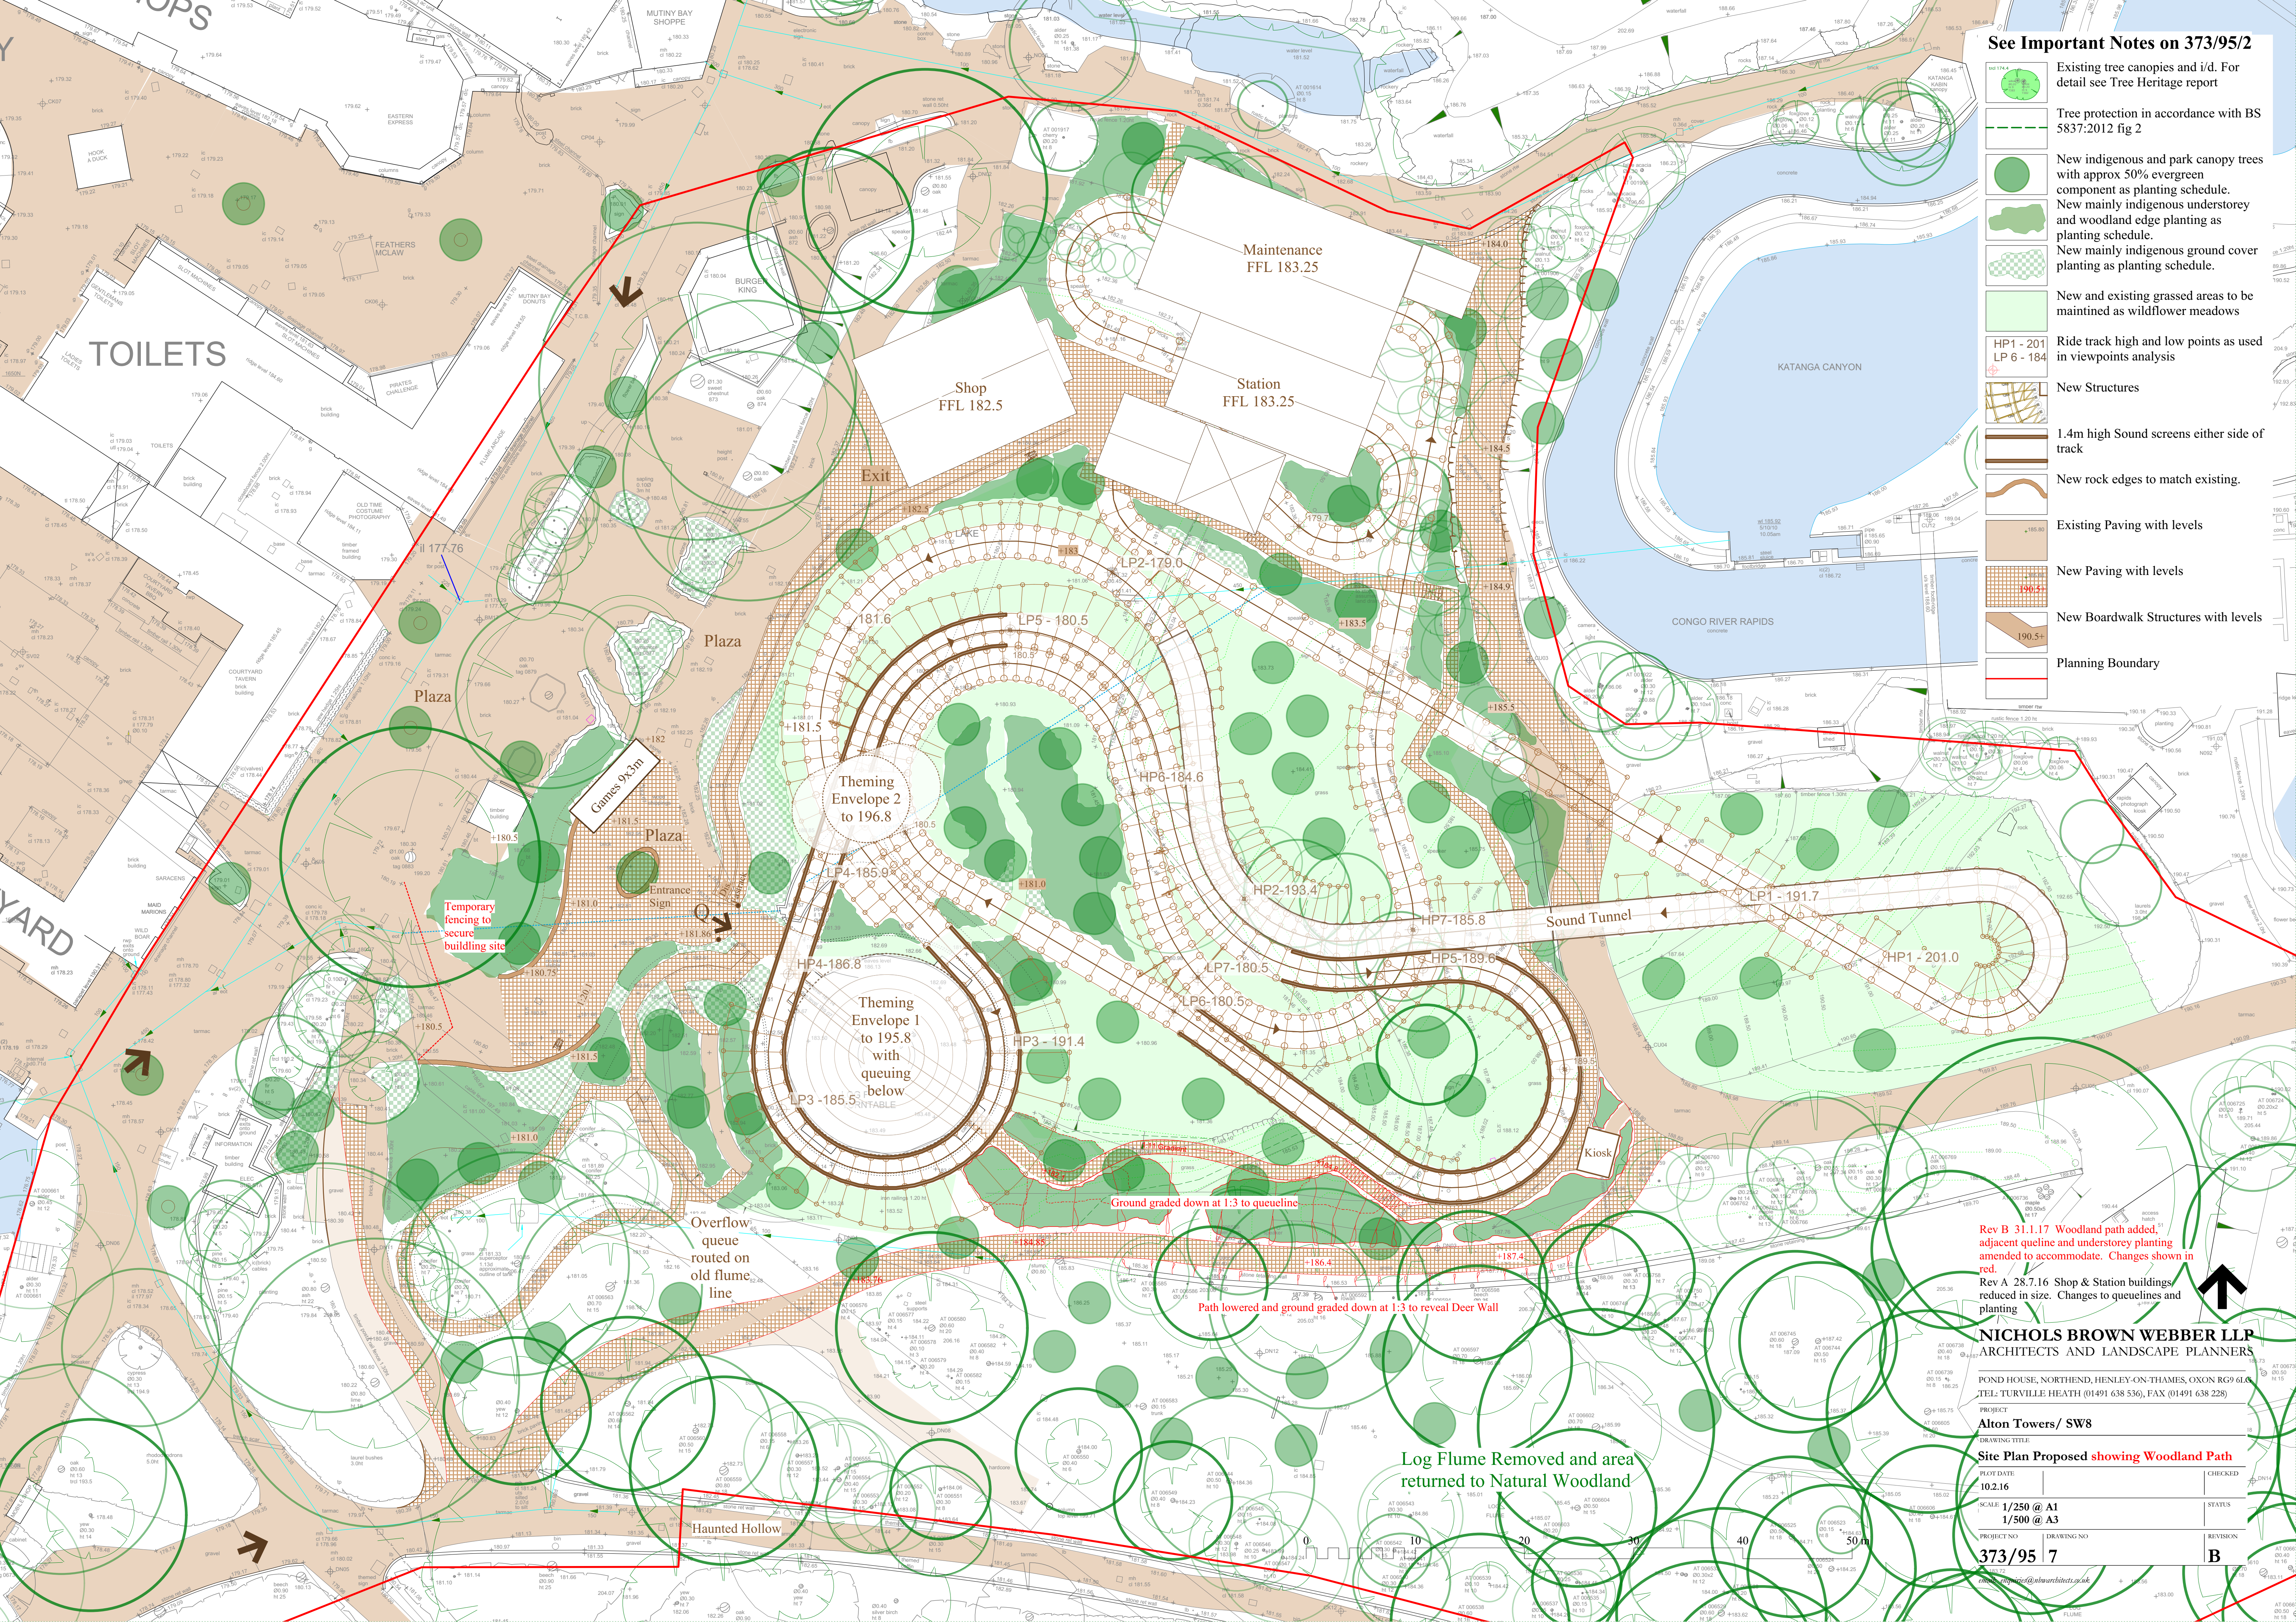

See Important Notes on 373/95/2

- Existing tree canopies and i/d. For detail see Tree Heritage report
- Tree protection in accordance with BS 5837:2012 fig 2
- New indigenous and park canopy trees with approx 50% evergreen component as planting schedule.
- New mainly indigenous understorey and woodland edge planting as planting schedule.
- New mainly indigenous ground cover planting as planting schedule.
- New and existing grassed areas to be maintained as wildflower meadows
- Ride track high and low points as used in viewpoints analysis
- New Structures
- 1.4m high Sound screens either side of track
- New rock edges to match existing.
- Existing Paving with levels
- New Paving with levels
- New Boardwalk Structures with levels
- Planning Boundary

Rev B 31.1.17 Woodland path added, adjacent queueline and understorey planting amended to accommodate. Changes shown in red.

Rev A 28.7.16 Shop & Station buildings reduced in size. Changes to queuelines and planting

NICHOLS BROWN WEBBER LLP
ARCHITECTS AND LANDSCAPE PLANNERS

POND HOUSE, NORTHEAST, HENLEY-ON-THAMES, OXON RG9 6LG
TEL: TURVILLE HEATH (01491 638 536), FAX (01491 638 228)

PROJECT
Alton Towers/ SW8
DRAWING TITLE
Site Plan Proposed showing Woodland Path

PLOT DATE
10.2.16
SCALE
**1/250 @ A1
1/500 @ A3**

PROJECT NO
373/95
DRAWING NO
7
REVISION
B

STATUS
CHECKED