




This drawing is the copyright of Roberts Limbrick Ltd and should not be reproduced in whole or in part or used in any manner whatsoever without their written permission.
Use only figured dimensions and report any discrepancies or omissions to the Architect immediately.

rev.	date	description
-	-	-

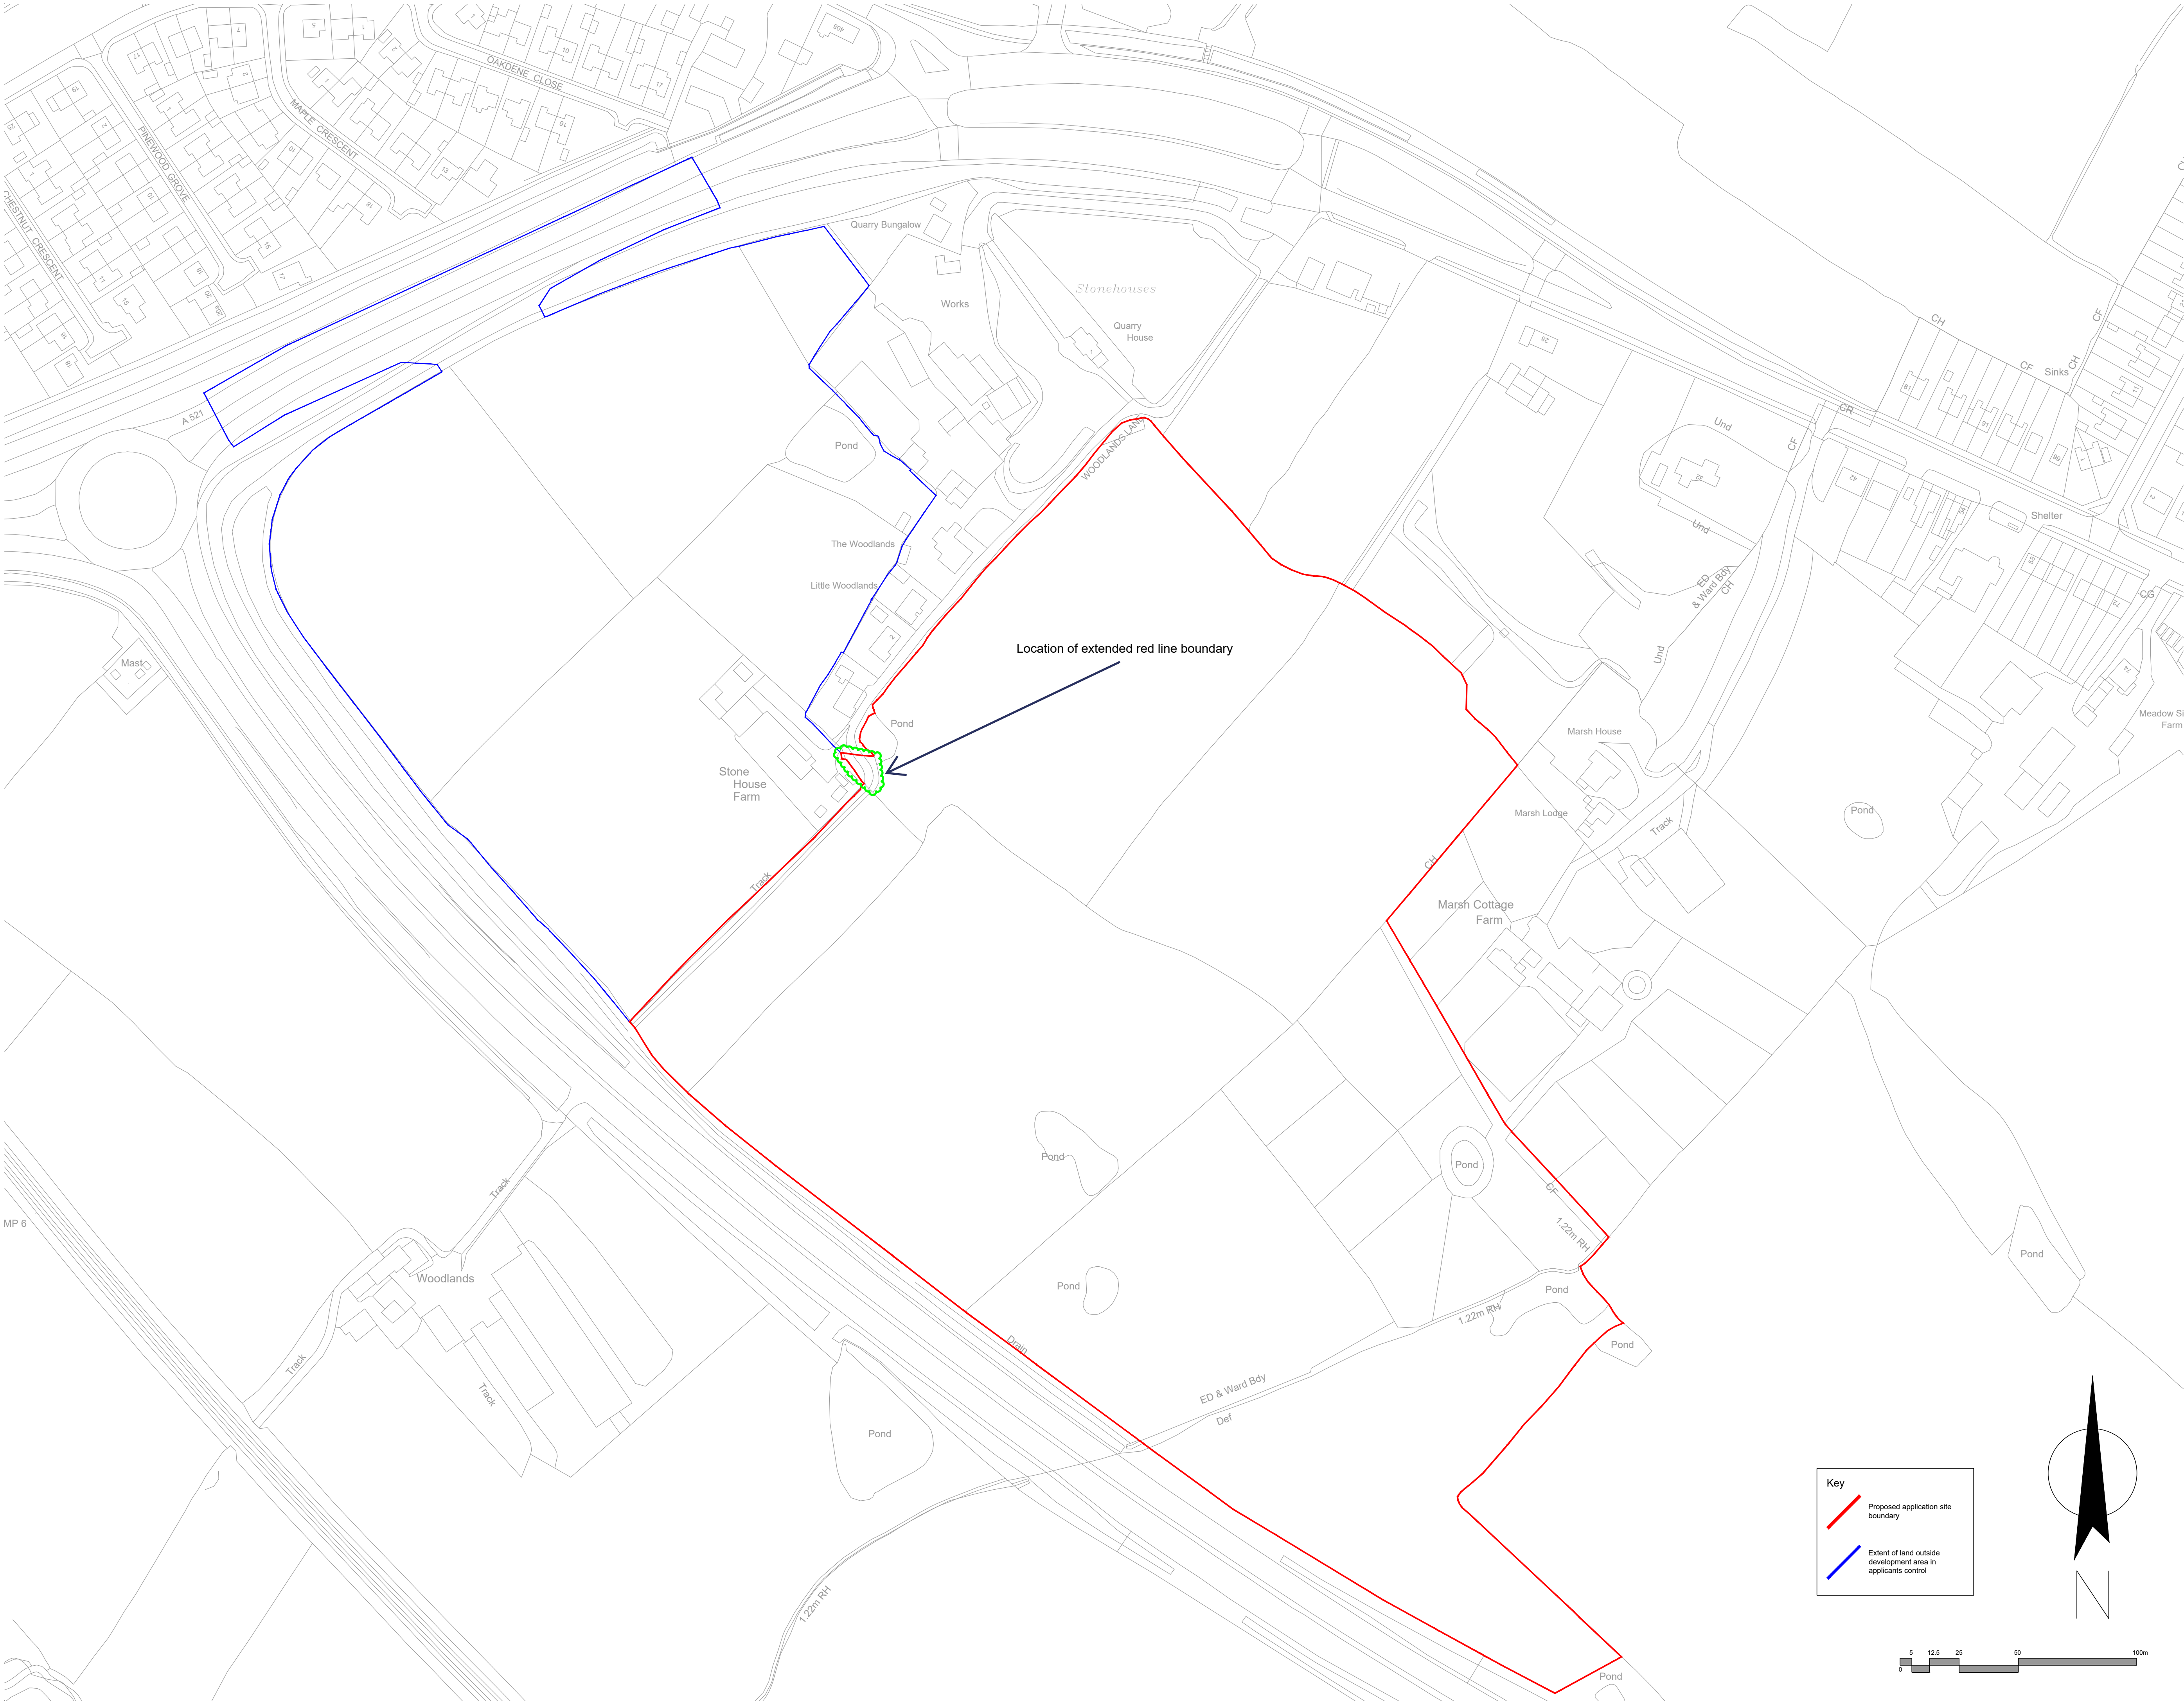

project
RESIDENTIAL DEVELOPMENT
PHASE 2
BLYTHE VALE
-



drawing
SITE LOCATION PLAN
-
EXTENDED RED LINE TO
INCLUDE BEDSON LAND

status
PRELIMINARY

ROBERTS LIMBRICK LTD
The Carriage Building, Bruton Way,
Gloucester, GL1 1DG
The Estates Office, 25 - 26 Gold Tops,
Newport, NP20 4PG
T. 03333 405 500
mail@robertslimbrick.com
www.robertslimbrick.com

Registered Office - England No. 06658029

scale	1/1250 @ A1	originator code	8722
date	Jan' 21	author	-

drawing number	rev.
R9074-RLA-21-XX-DR-A-1001	-
region originator year level type code number	

Key

Proposed application site boundary

Extent of land outside development area in applicants control

