
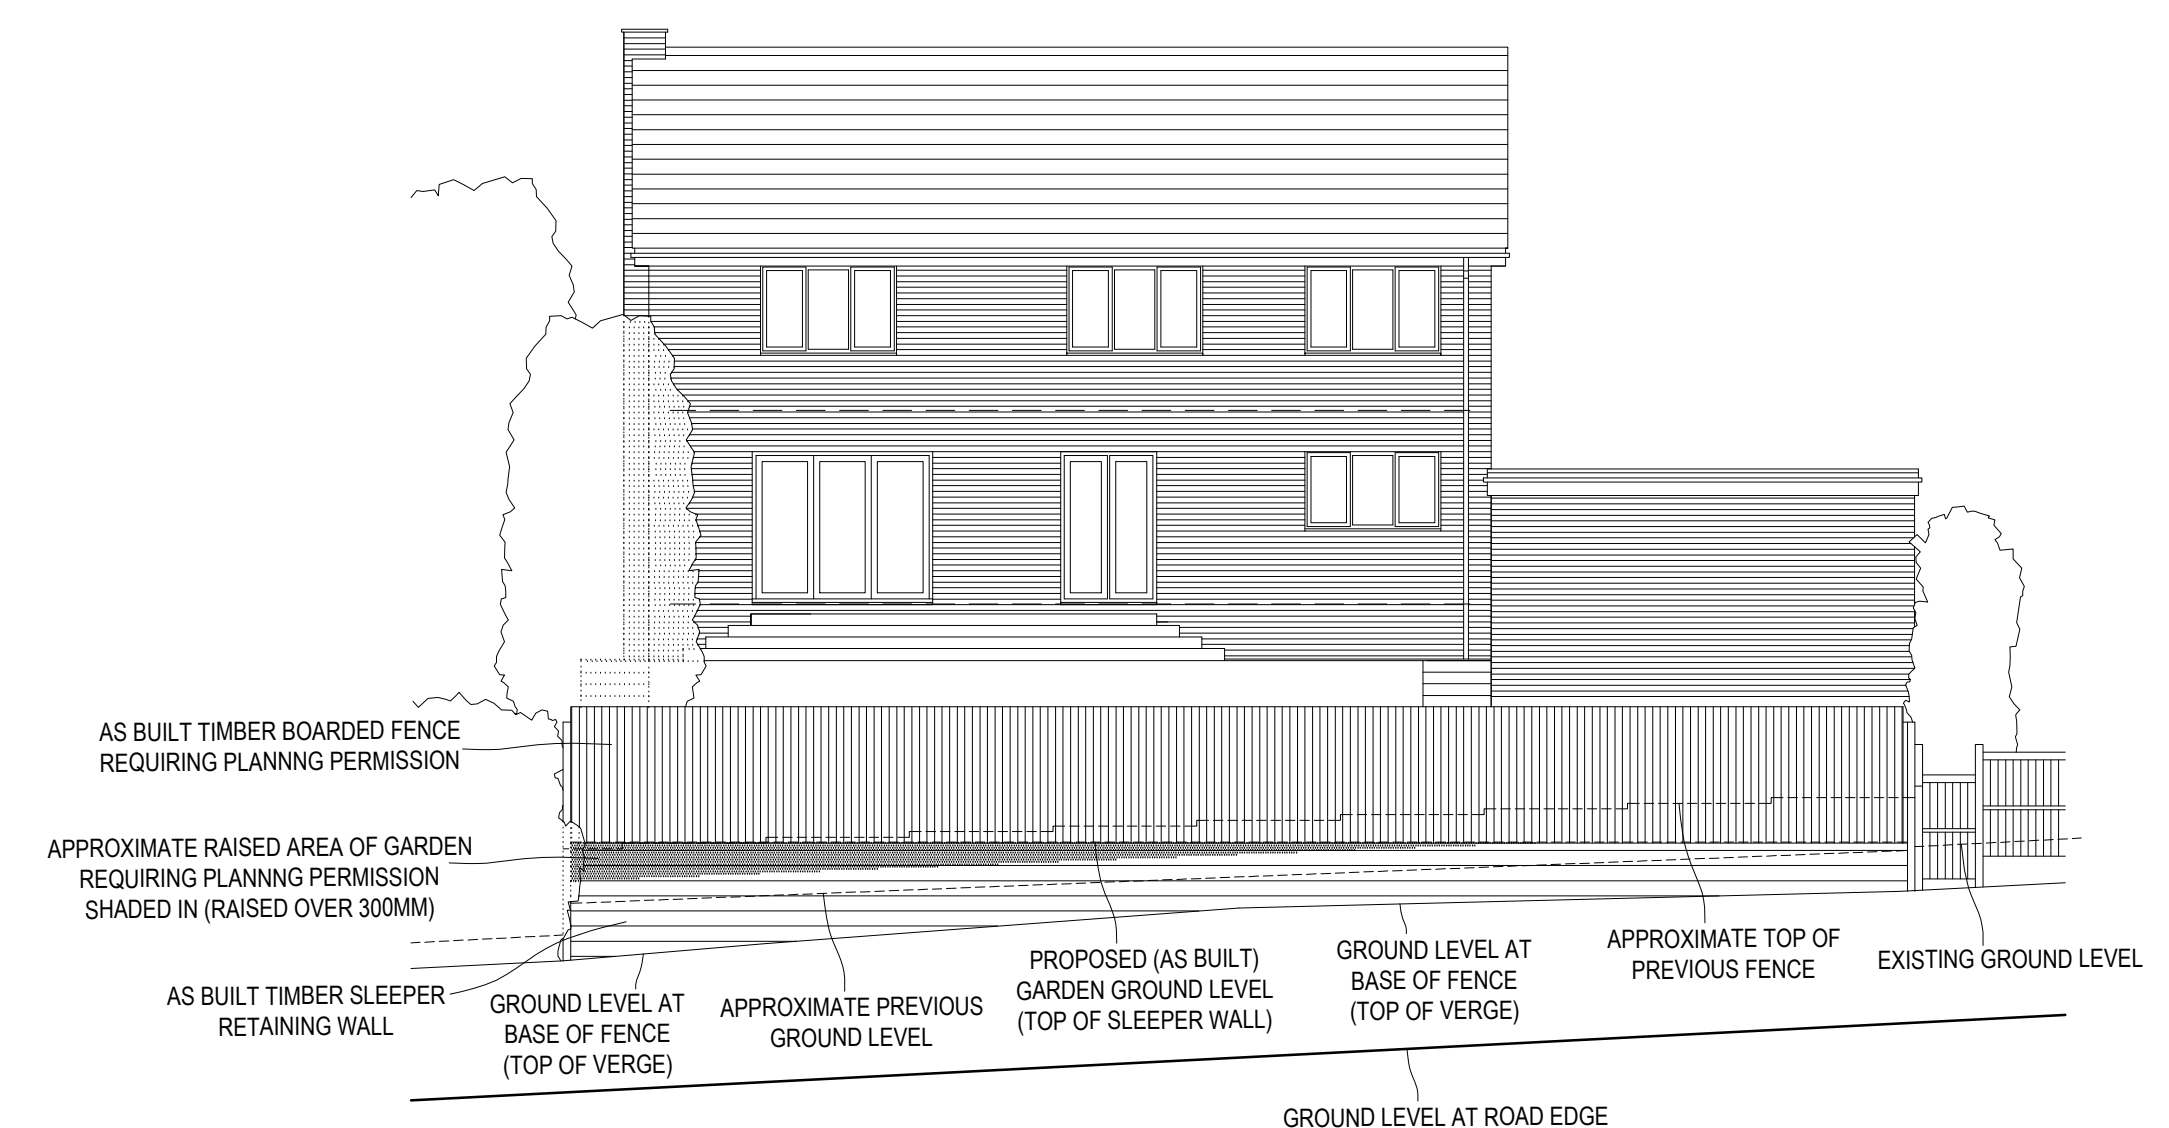
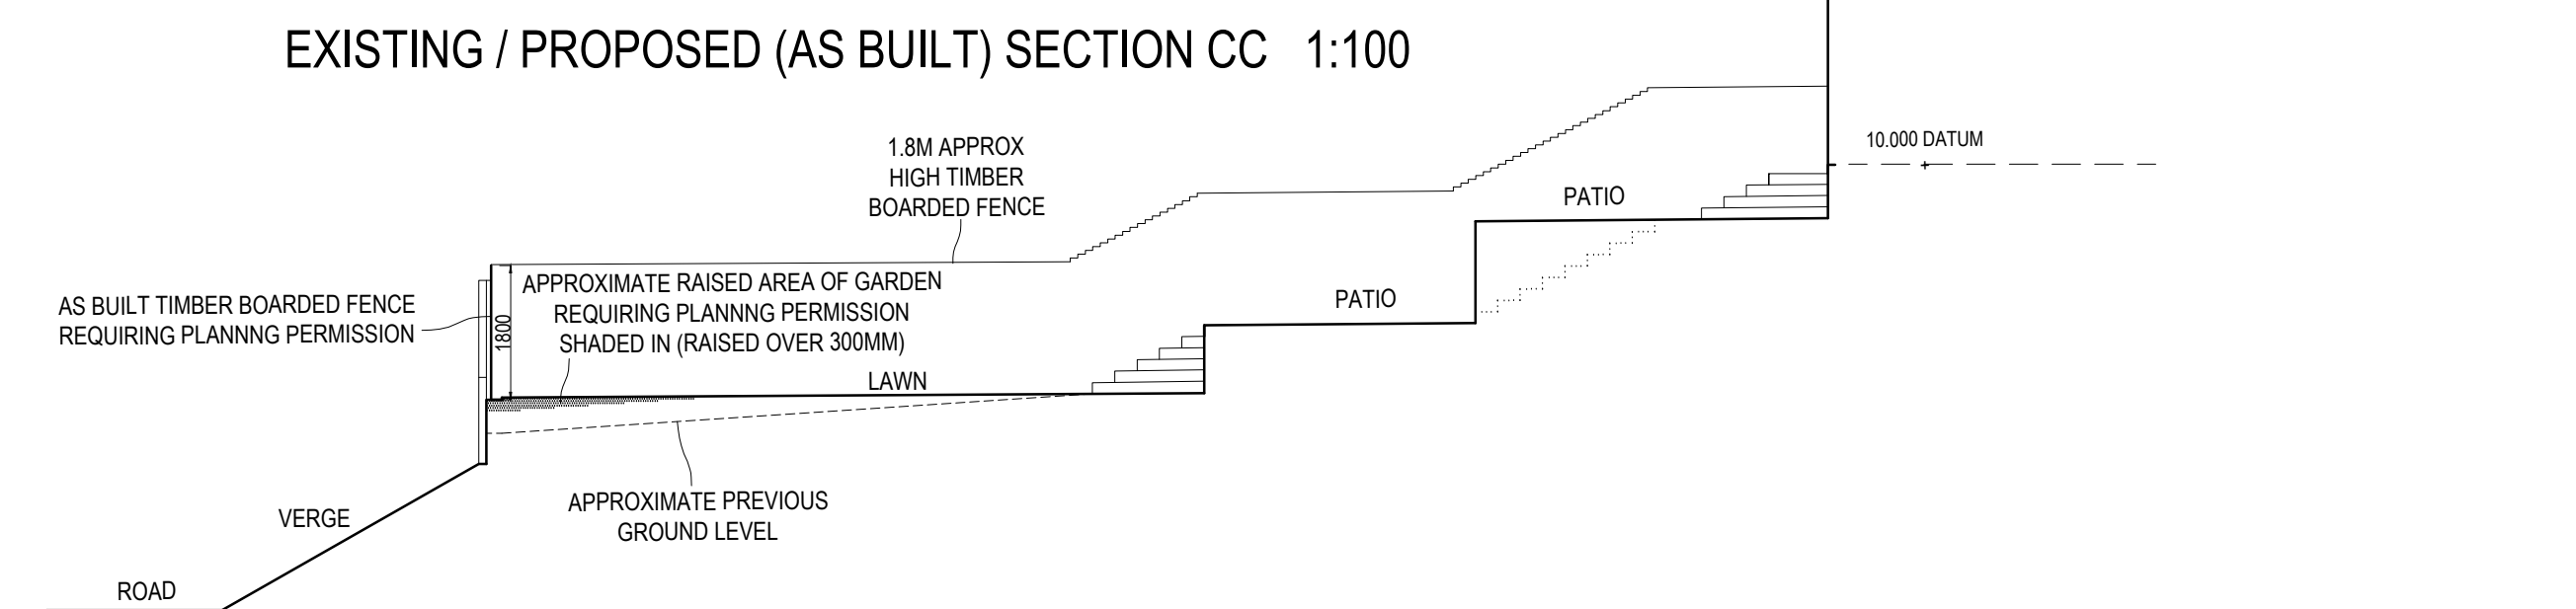
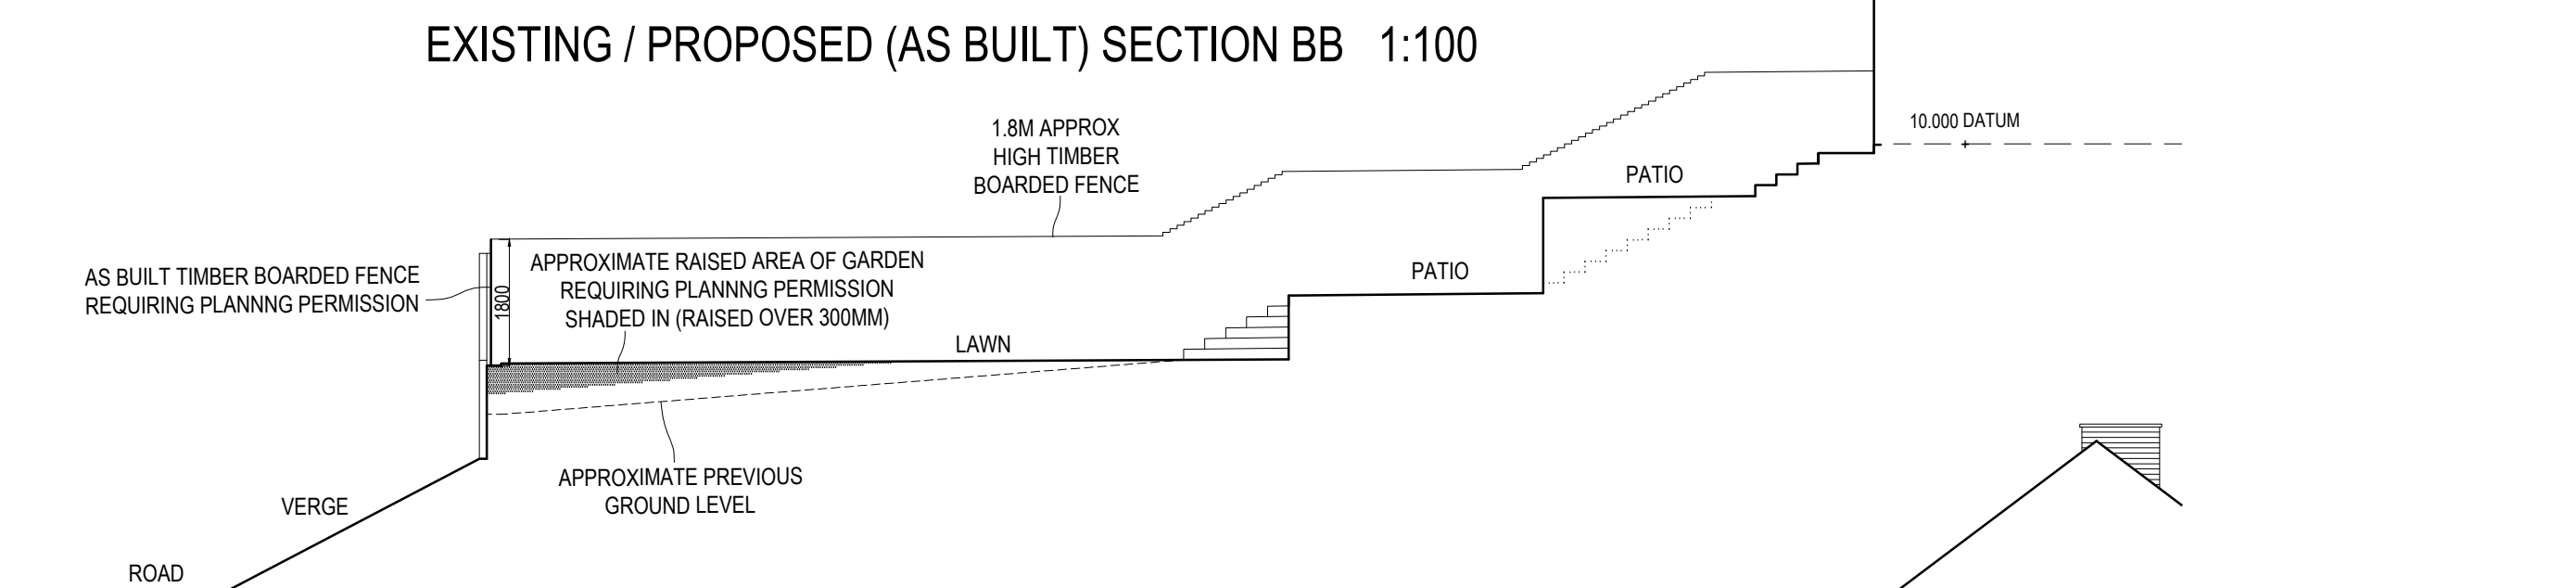
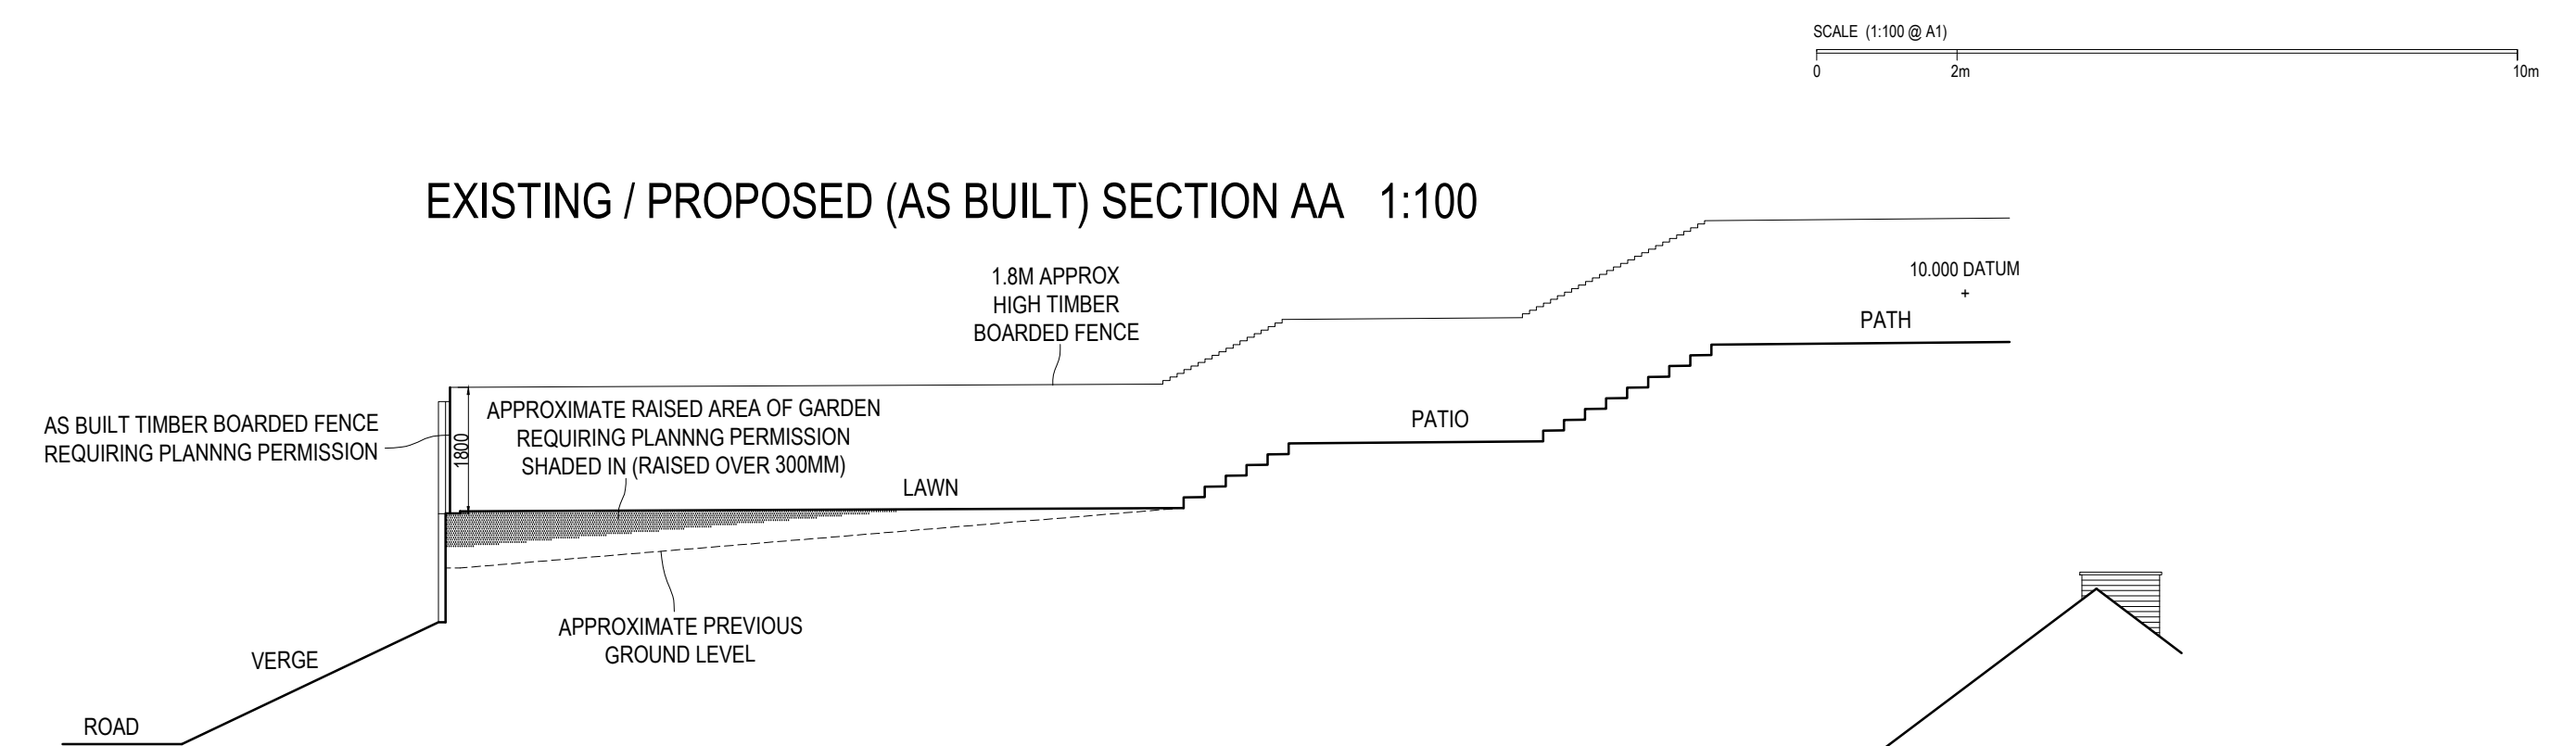


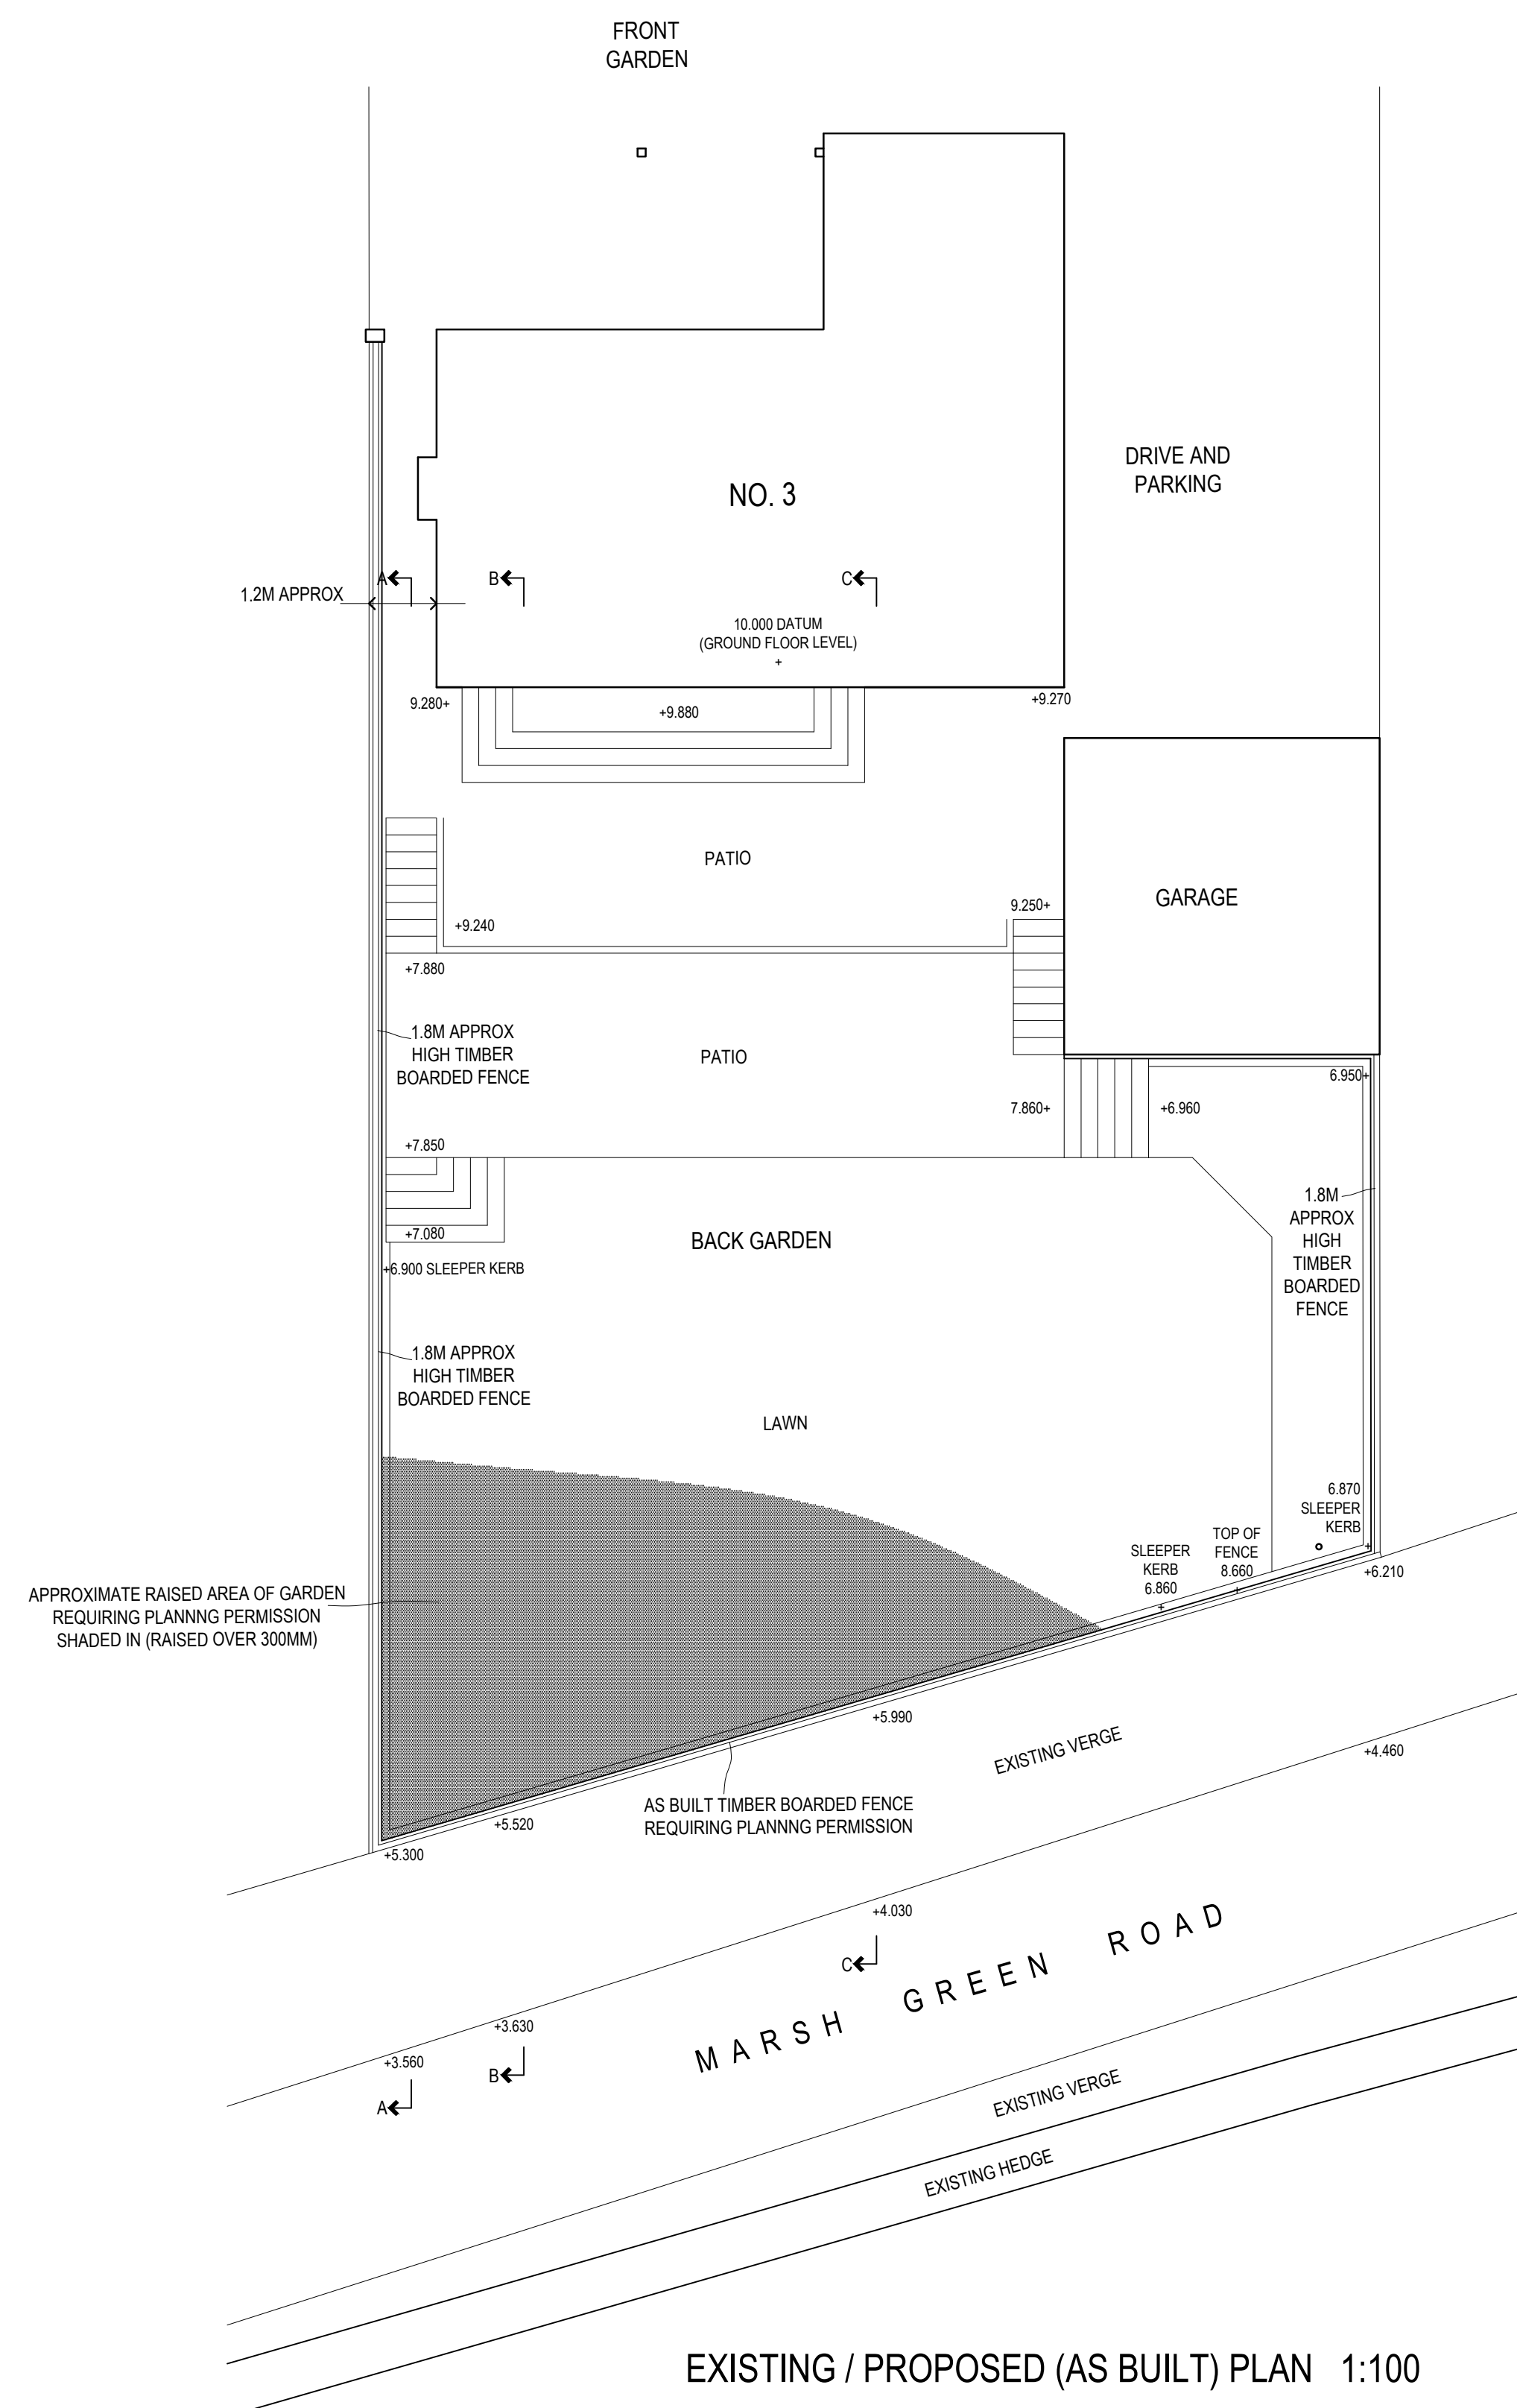

©COPYRIGHT DAVID BAILEY ARCHITECT LTD

THE AS BUILT WORKS SHOWN WERE STARTED AROUND MID-MAY 2020 AND COMPLETED AROUND MID-JUNE 2020. THE APPLICANT DIDN'T REALISE THAT THE WORKS REQUIRED PLANNING PERMISSION. IN MARCH 2022, THE APPLICANT CONTACT DAVID BAILEY ARCHITECT LTD AND COMMISSIONED THEM TO PREPARE AND SUBMIT A RETROSPECTIVE PLANNING APPLICATION FOR THE AS BUILT WORKS.

DAVID BAILEY ARCHITECT LTD
Gillow Fold Farm, 26 Mow Lane, Gillow Heath,
Biddulph, Staffordshire, ST8 6QQ
Tel: 01782 516355 E-mail: davidbailey.architect@btinternet.com

SCALE: 1:100 @A1

TITLE: SITE PLAN, ELEVATIONS AND
SECTIONS -
EXISTING / PROPOSED (AS BUILT)

PROJECT: 3 MARSH GREEN CLOSE, BIDDULPH,
STAFFORDSHIRE. ST8 6TA

DATE: MAR 2

DRAWN BY: DB

DRAWING NUMBER: 00820-001