




WINDOWS

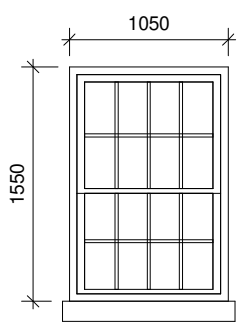


TYPE 1
T01

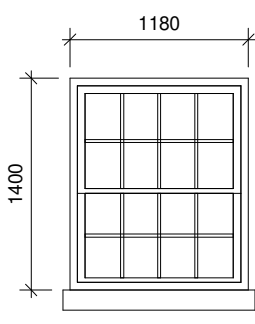


TYPE 2
T02

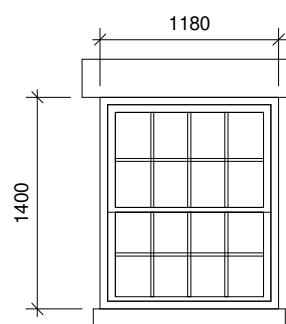


TYPE 3
T03

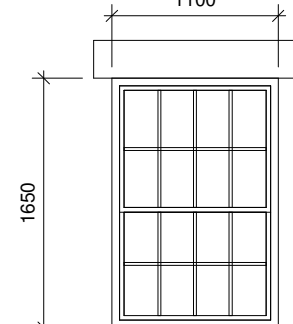


TYPE 4
T04

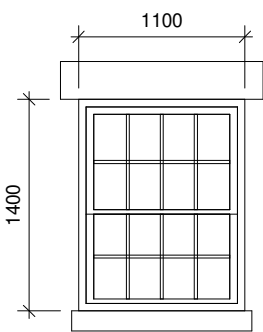


TYPE 5
T05

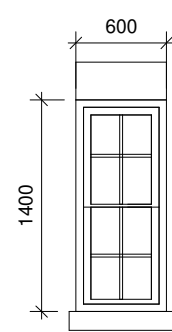


TYPE 6
T06

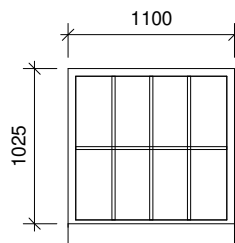

TYPE 7
T07

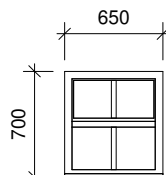

TYPE 8
T08

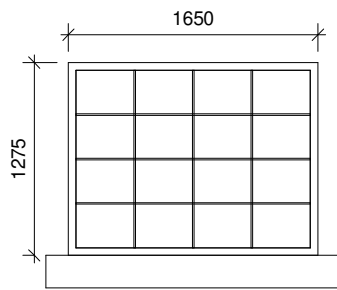

TYPE 9
T09

WINDOW SCHEDULE			
Window Number	Window Type	Width	Height

W-001	T04	1100	1650
W-002	T04	1100	1650
W-003	T04	1100	1650
W-054	T04	1100	1650

WINDOW SCHEDULE			
Window Number	Window Type	Width	Height

W-055	T04	1100	1650
W-056	T04	1100	1650
W-057	T04	1100	1650
W-058	T04	1100	1650
W-059	T04	1100	1650
W-060	T04	1100	1650
W-061	T04	1100	1650
W-062	T04	1100	1650
W-063	T04	1100	1650
W-064	T04	1100	1650
W-065	T04	1100	1650
W-066	T04	1100	1650
W-067	T04	1100	1650
W-068	T04	1100	1650
W-069	T04	1100	1650
W-070	T04	1100	1650
W-071	T04	1100	1650
W-072	T04	1100	1650
W-073	T04	1100	1650
W-074	T04	1100	1650
W-075	T04	1100	1650
W-076	T04	1100	1650
W-077	T04	1100	1650
W-078	T04	1100	1650
W-079	T04	1100	1650
W-080	T04	1100	1650
W-081	T05	1100	1400
W-082	T05	1100	1400
W-083	T05	1100	1400
W-084	T05	1100	1400
W-085	T05	1100	1400
W-086	T05	1100	1400
W-087	T05	1100	1400
W-088	T04	1100	1650
W-089	T05	1100	1400
W-090	T05	1100	1400
W-091	T05	1100	1400
W-092	T05	1100	1400
W-093	T05	1100	1400
W-094	T05	1100	1400
W-095	T05	1100	1400
W-096	T05	1100	1400
W-097	T05	1100	1400
W-098	T05	1100	1400
W-099	T05	1100	1400
W-100	T05	1100	1400
W-101	T05	1100	1400
W-102	T05	1100	1400
W-103	T05	1100	1400
W-104	T05	1100	1400
W-105	T05	1100	1400
W-106	T05	1100	1400
W-107	T05	1100	1400
W-108	T05	1100	1400

WINDOW SCHEDULE			
Window Number	Window Type	Width	Height


W-109	T05	1100	1400
W-110	T05	1100	1400
W-111	T03	1180	1400
W-112	T03	1180	1400
W-113	T03	1180	1400
W-114	T02	1180	1400
W-115	T03	1180	1400
W-116	T03	1180	1400
W-117	T03	1180	1400
W-118	T02	1180	1400
W-119	T03	1180	1400
W-120	T03	1180	1400
W-121	T03	1180	1400
W-122	T02	1180	1400
W-123	T03	1180	1400
W-124	T03	1180	1400
W-125	T03	1180	1400
W-126	T02	1180	1400
W-127	T03	1180	1400
W-128	T03	1180	1400
W-129	T03	1180	1400
W-130	T02	1180	1400
W-131	T03	1180	1400
W-132	T03	1180	1400
W-133	T03	1180	1400
W-134	T02	1180	1400
W-135	T03	1180	1400
W-136	T03	1180	1400
W-137	T02	1180	1400
W-138	T06	600	1400
W-139	T06	600	1400
W-140	T06	600	1400
W-141	T06	600	1400
W-142	T01	1050	1550
W-143	T01	1050	1550
W-144	T01	1050	1550
W-145	T01	1050	1550
W-146	T01	1050	1550
W-147	T01	1050	1550
W-148	T01	1050	1550
W-149	T01	1050	1550
W-150	T01	1050	1550
W-151	T01	1050	1550
W-152	T01	1050	1550
W-153	T04	1100	1650
W-154	T04	1100	1650
W-155	T04	1100	1650
W-156	T04	1100	1650
W-157	T04	1100	1650
W-158	T04	1100	1650
W-159	T04	1100	1650
W-160	T04	1100	1650
W-161	T04	1100	1650
W-162	T04	1100	1650

WINDOW SCHEDULE			
Window Number	Window Type	Width	Height


W-163	T04	1100	1650
W-164	T04	1100	1650
W-165	T04	1100	1650
W-166	T04	1100	1650
W-167	T04	1100	1650
W-168	T04	1100	1650
W-169	T04	1100	1650
W-170	T04	1100	1650
W-171	T04	1100	1650
W-172	T04	1100	1650
W-173	T04	1100	1650
W-174	T04	1100	1650
W-175	T04	1100	1650
W-176	T08	650	700
W-177	T03	1180	1400
W-178	T07	1100	1050
W-179	T09	1650	1275
W-180	T09	1650	1275
W-181	T05	1100	1400
W-182	T05	1100	1400
W-183	T05	1100	1400
W-184	T05	1100	1400
W-185	T04	1100	1650
W-186	T04	1100	1650
W-187	T04	1100	1650
W-188	T04	1100	1650
W-189	T04	1100	1650
W-190	T04	1100	1650
W-191	T04	1100	1650
W-192	T04	1100	1650
W-193	T04	1100	1650
W-194	T04	1100	1650
W-195	T04	1100	1650
W-196	T04	1100	1650
W-197	T04	1100	1650
W-198	T04	1100	1650
W-199	T04	1100	1650
W-200	T04	1100	1650
W-201	T04	1100	1650
W-202	T04	1100	1650
W-203	T04	1100	1650
W-204	T04	1100	1650
W-205	T04	1100	1650
W-206	T04	1100	1650
W-207	T04	1100	1650
W-208	T04	1100	1650
W-209	T04	1100	1650
W-210	T04	1100	1650
W-211	T04	1100	1650
W-212	T04	1100	1650
W-213	T05	1100	1400
W-214	T05	1100	1400

Grand total: 214


DOORS

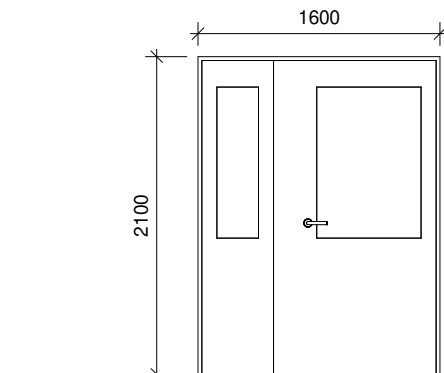


TYPE 1
T01

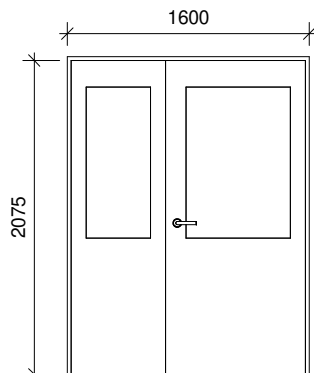


TYPE 2
T02

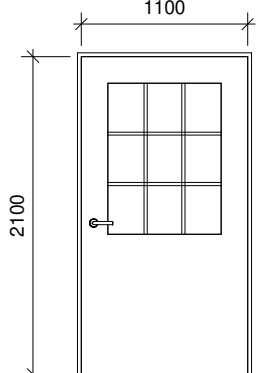


TYPE 3
T03

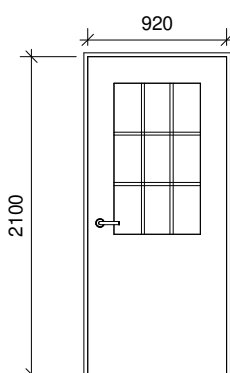


TYPE 4
T04

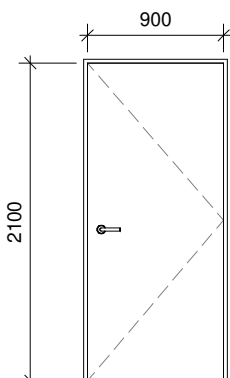

TYPE 5
T05

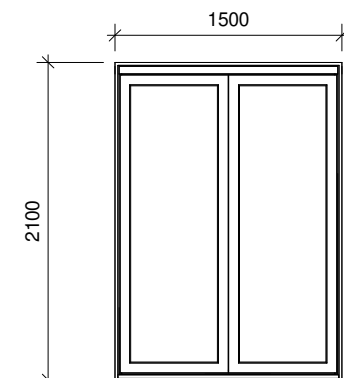

TYPE 6
T06

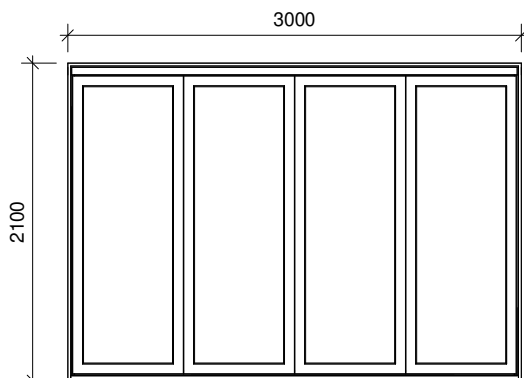

TYPE 7
T07

DOOR SCHEDULE			
Door Number	Door Type	Width	Height

D-01	T04	920	2100
D-02	T02	1600	2100
D-03	T06	1500	2100
D-04	T01	1600	2100
D-05	T04	920	2100
D-06	T05	900	2100
D-07	T03	1100	2100
D-08	T07	3000	2100
D-09	T05	900	2100

Grand total: 9

Notes

- Copyright of this drawing remains the property of BM3 Architecture Limited
- Contractors and consultants are to advise BM3 Architecture Limited of any discrepancies

Client

midland

heart

Stage

AS-BUILT

Revision Schedule

No.	Description	Date	By
-----	-------------	------	----

Project

WELLINGTON MILL

Drawing

EXISTING SCHEDULES

Drawing No.

0005

Drawn by

JC

Checked

AG

Dated

20/09/22

Revision

Status (PAS1192)

BM3 Job Number

71628

Birmingham Office

29 Parkford Street, Digbeth, Birmingham, B5 5QH

T: 0121 633 0000 F: 0121 633 0300 E: design@bm3.co.uk