

Notes

- Copyright of this drawing remains the property of BM3 Architecture Limited
- Contractors and consultants are to advise BM3 Architecture Limited of any discrepancies

Client


midland heart

Stage

AS-BUILT

Revision Schedule

No.	Description	Date	By
-----	-------------	------	----

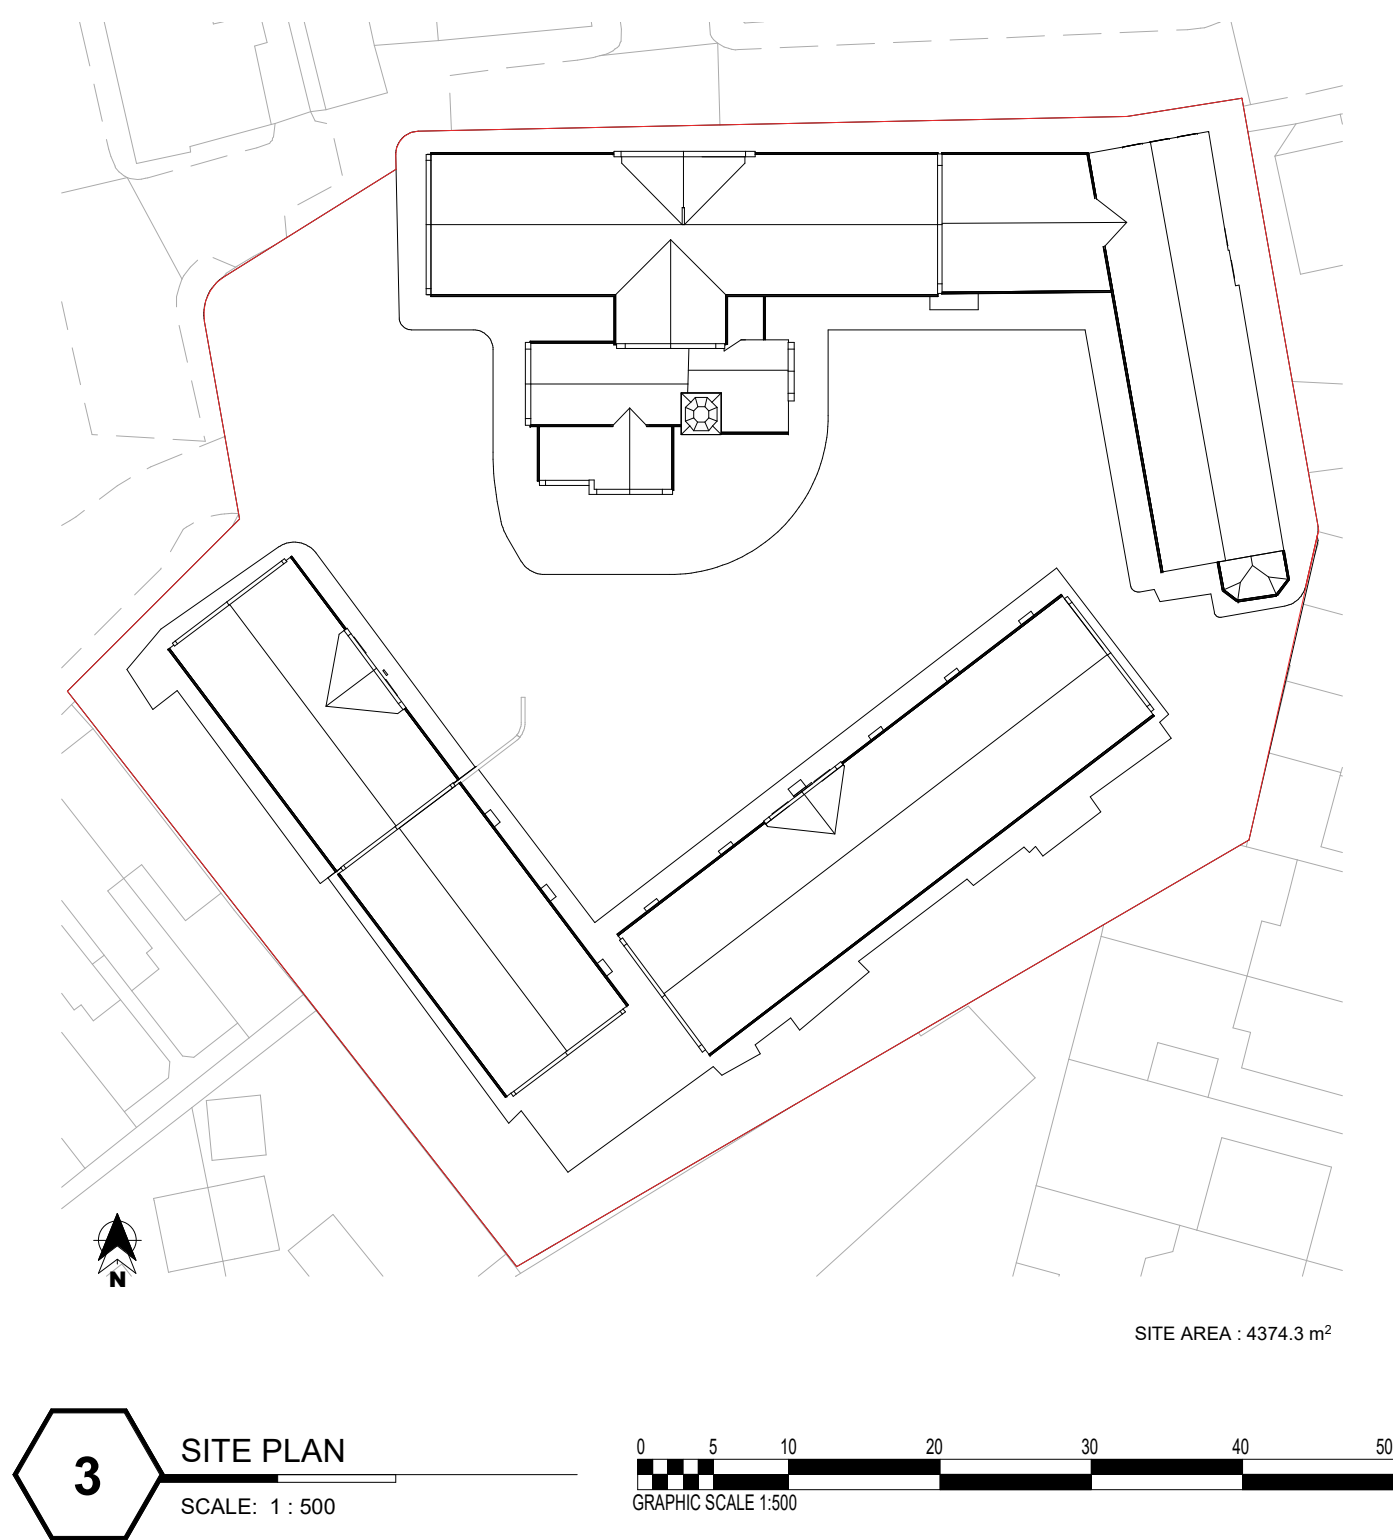

Project

WELLINGTON MILL

Drawing

SITE PLAN

Drawing No.

0006

Drawn by

JC

Checked

AG

Dated

07/12/22

Revision

Status (PAS1192)

BM3 Job Number

71628