
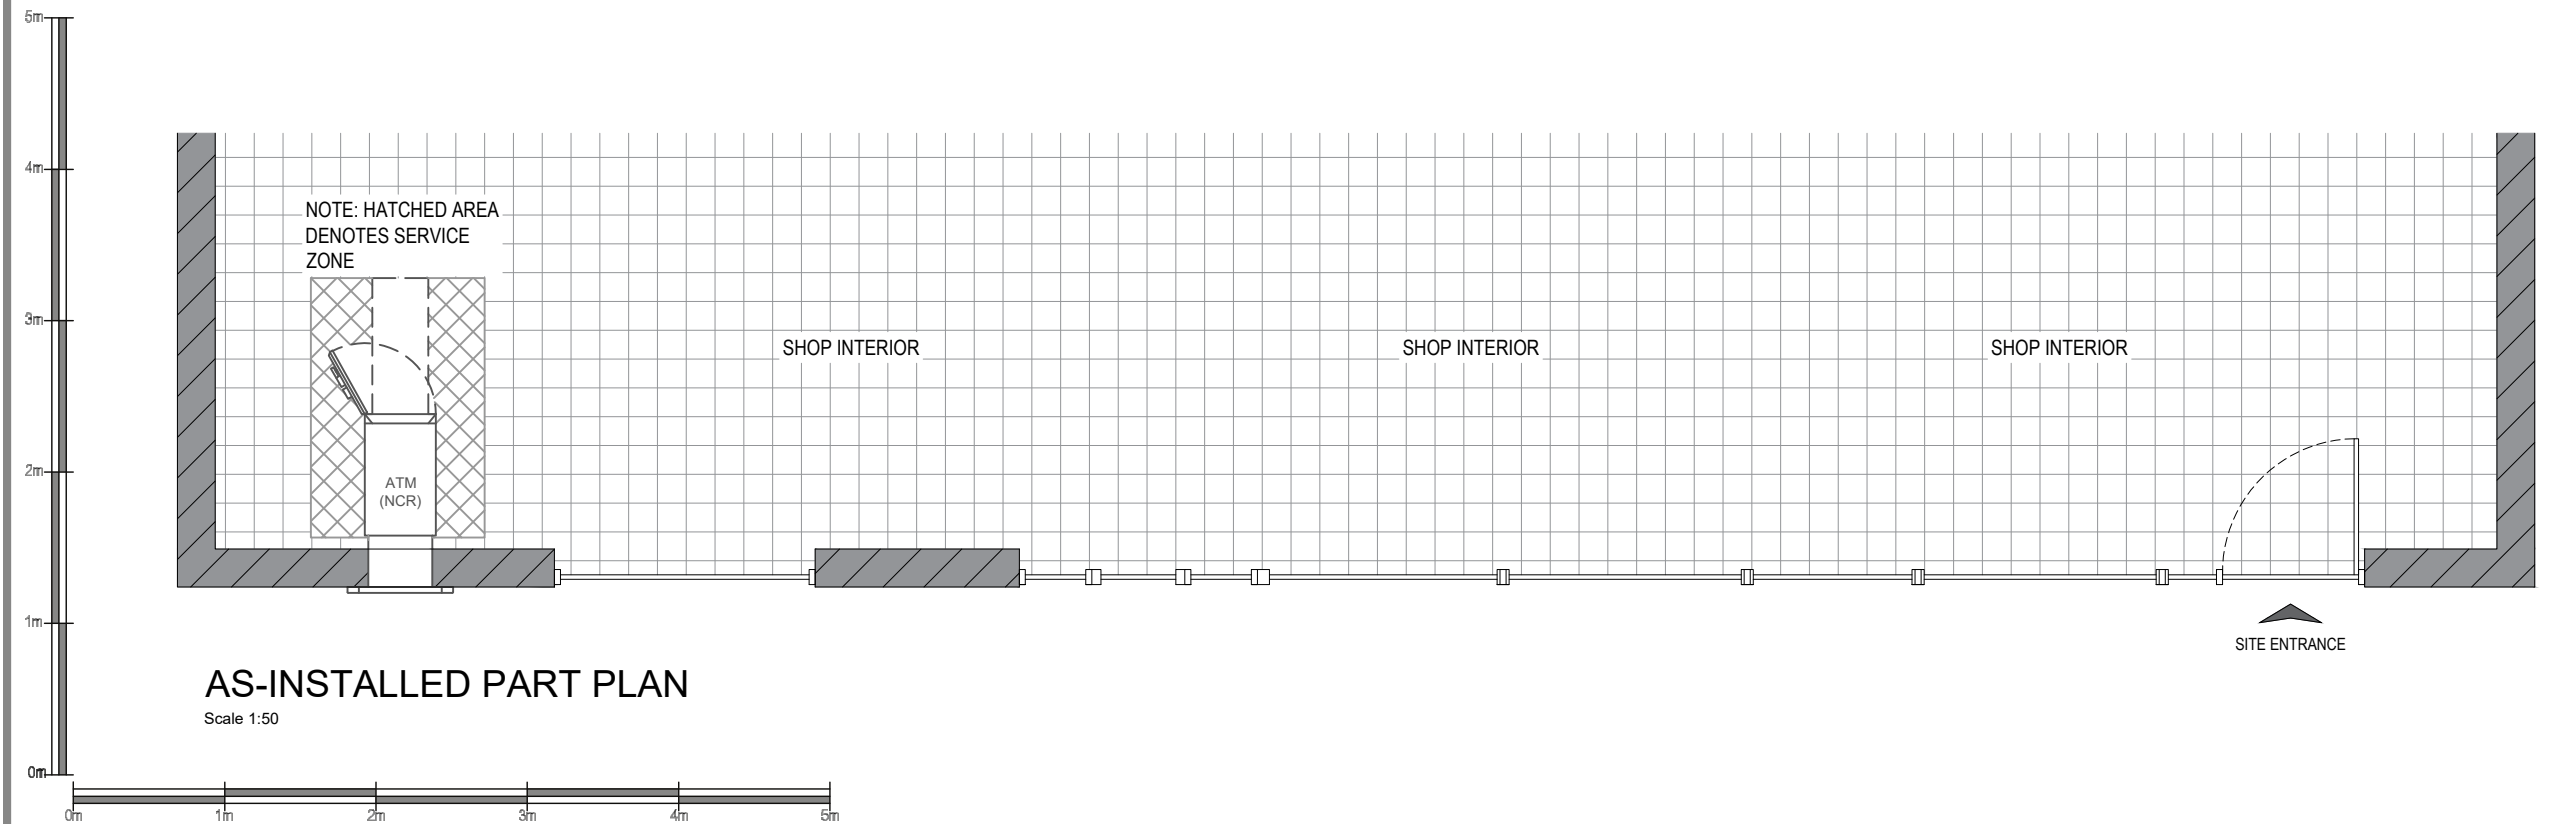


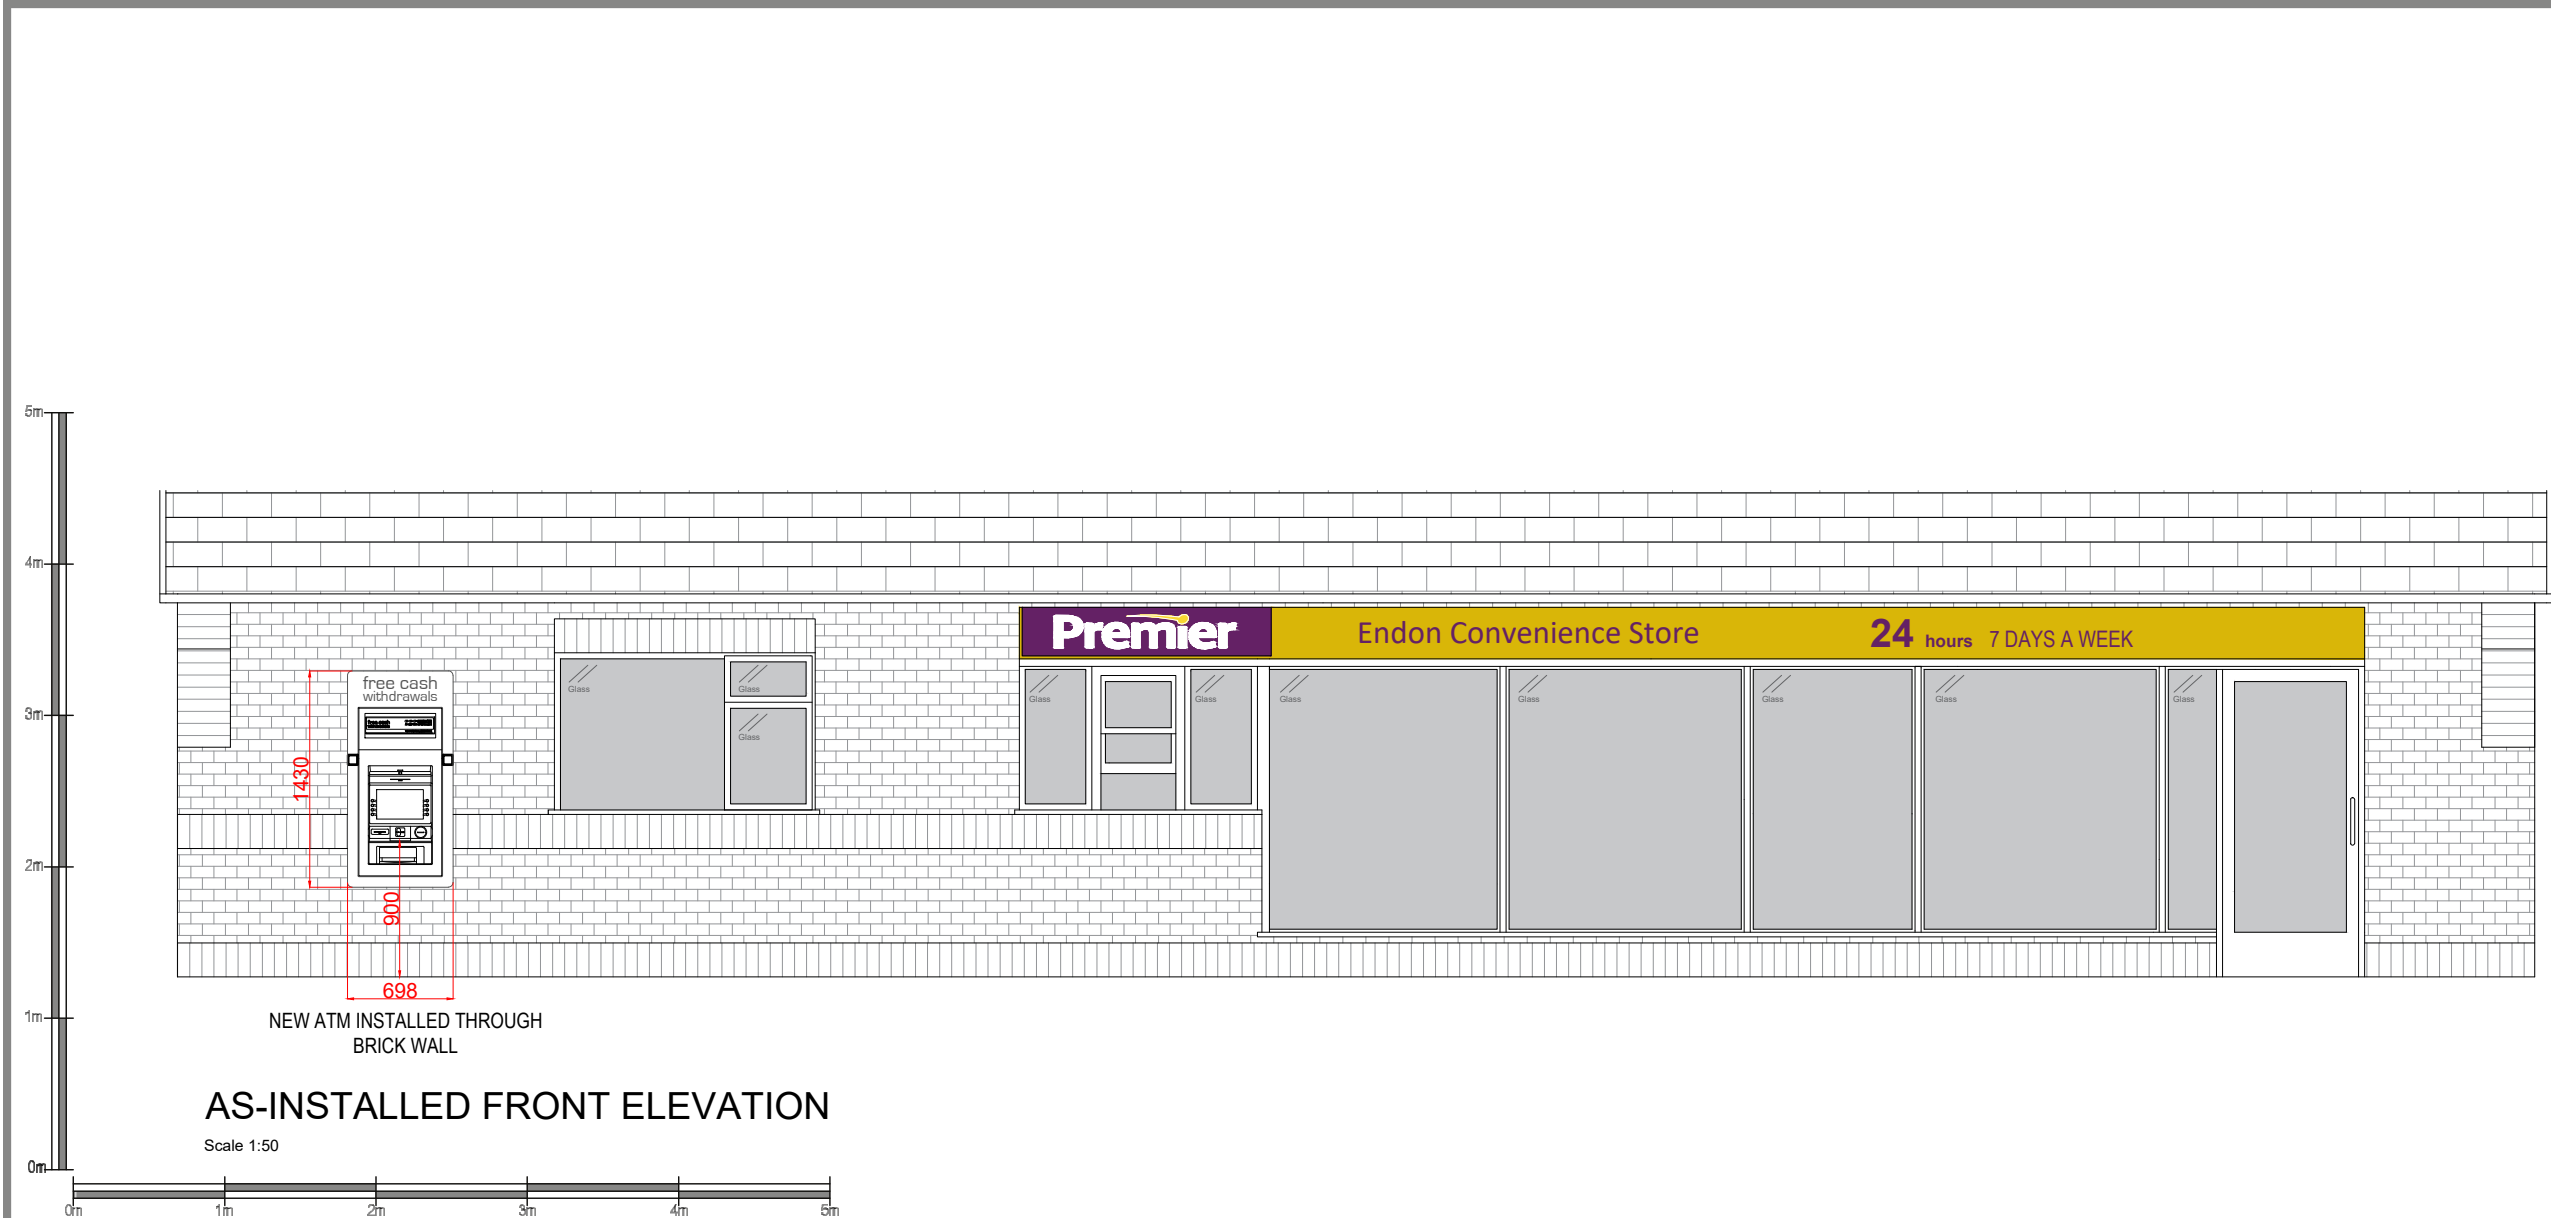

Date: Comments: By:

GENERAL NOTES:
1) All dimensions in millimeters unless otherwise stated.

Site:
Endon Service Station,
Leek road,
Endon,
ST9 9BA

Drawing Title:
As-Installed Plan and Elevation

Ref: T020785_AI	Date: 22/02/2022	Rev:
Scale: 1:50	Paper: A3	Date Rev: