


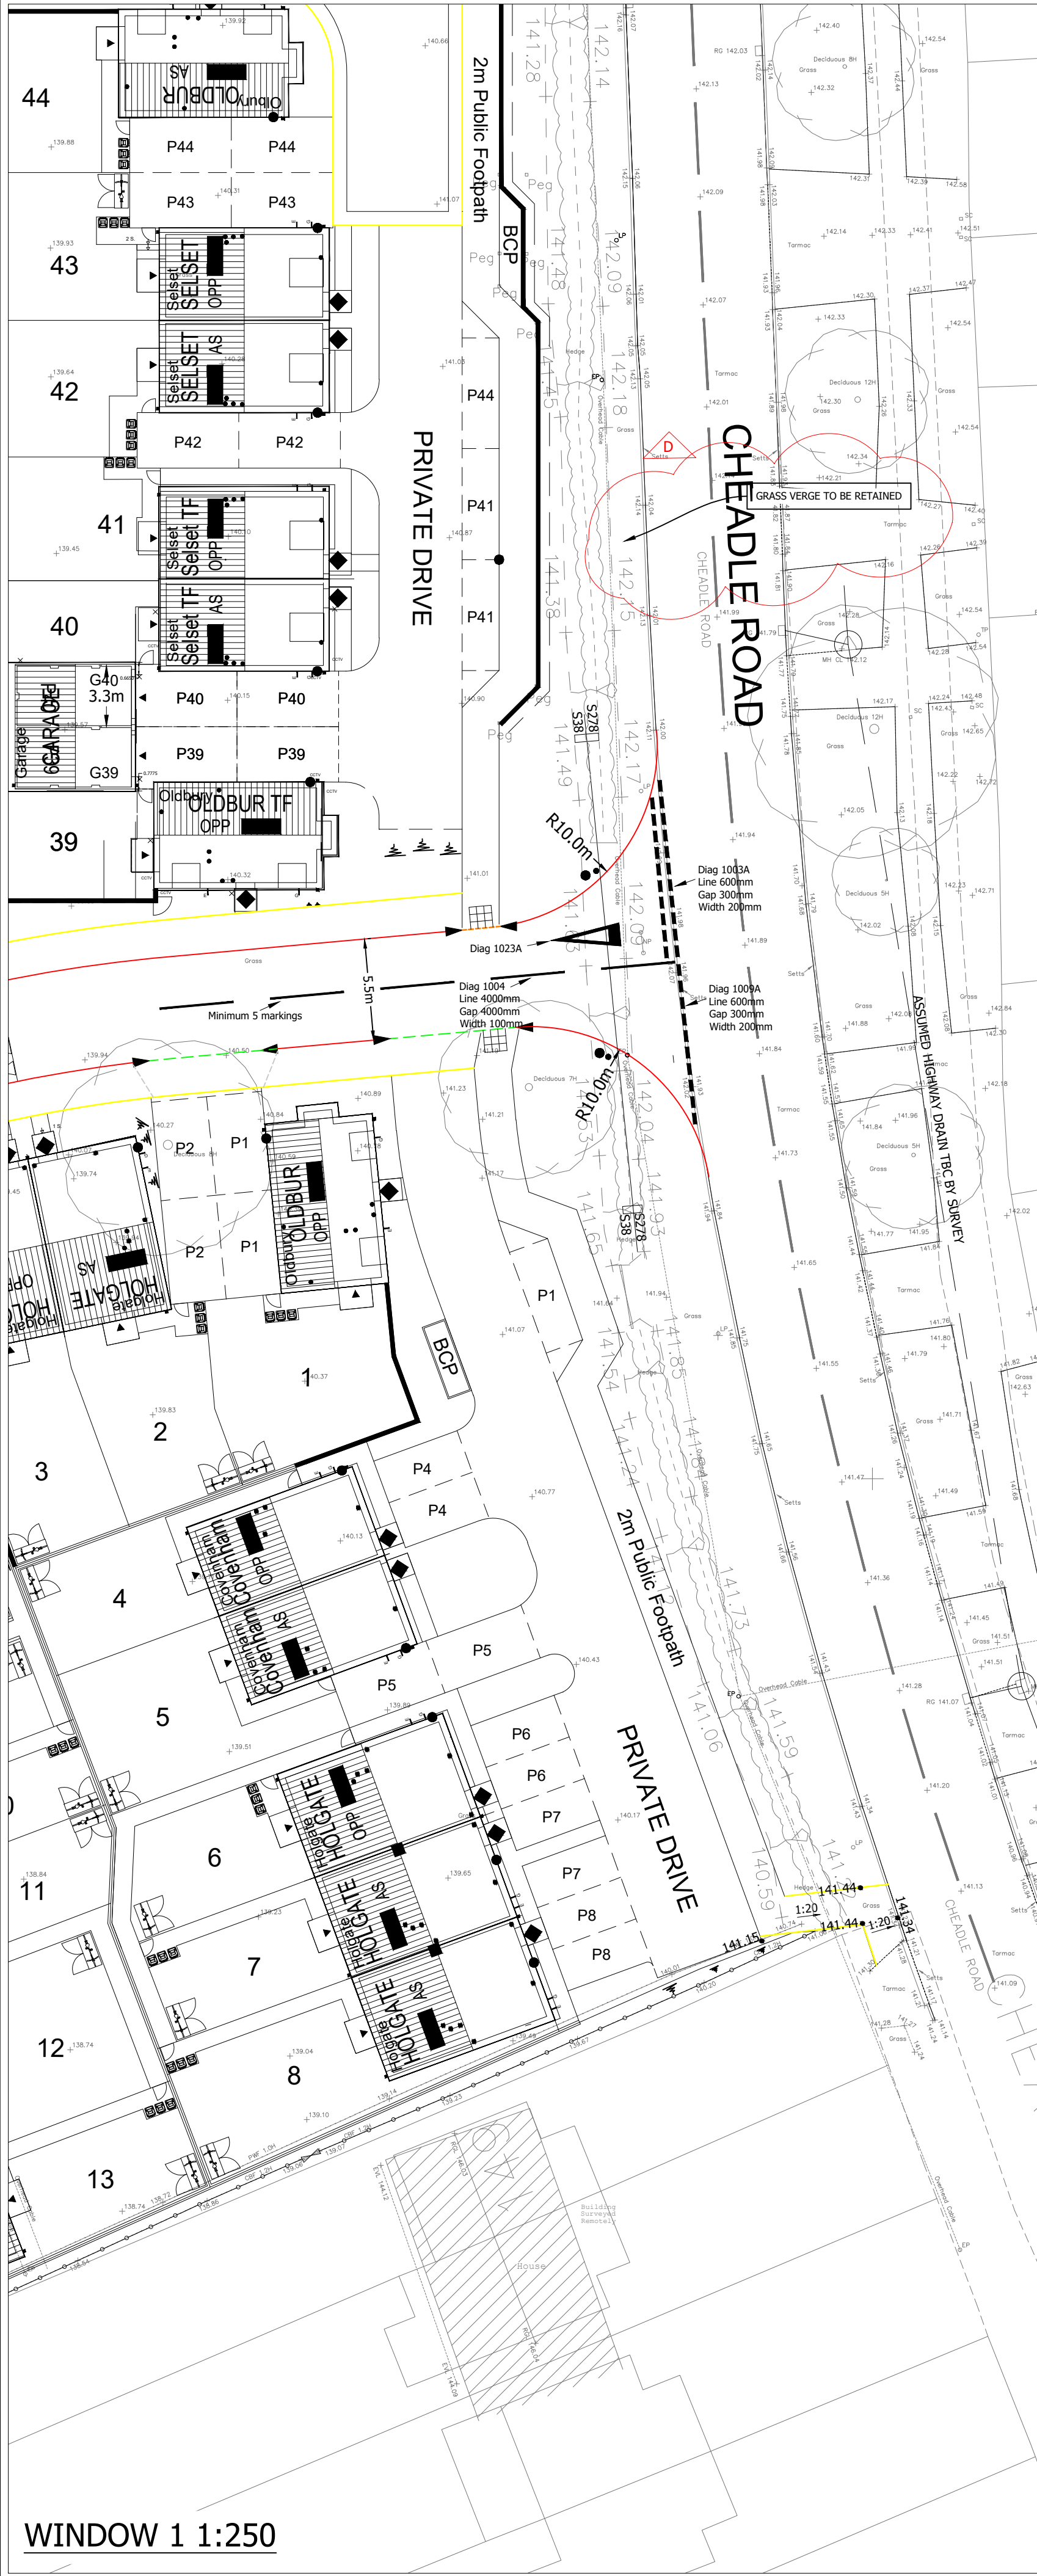

1. ALL DIMENSIONS ARE IN METRES UNLESS OTHERWISE NOTED.
2. THIS DRAWING IS TO BE READ IN CONJUNCTION WITH ALL OTHER RELEVANT DRAWINGS RELATING TO THIS PROJECT.
3. ALL DIMENSIONS SHOULD BE CHECKED ON SITE PRIOR TO CONSTRUCTION, ANY DISCREPANCIES SHOULD BE IMMEDIATELY NOTIFIED IN WRITING TO TRAVIS BAKER LIMITED.
4. THE CONTRACTOR SHALL PRIOR TO CONSTRUCTION CHECK AND VERIFY THAT THE DETAILS SHOWN ON THIS DRAWING ARE FULLY COMPATIBLE WITH ANY AS CONSTRUCTED DIMENSIONS OR LEVELS. ANY DISCREPANCIES TO BE REPORTED IMMEDIATELY IN WRITING TO TRAVIS BAKER LIMITED.
5. THIS DRAWING HAS BEEN PREPARED FOR THE EXCLUSIVE USE OF THE COMMISSIONING PARTY AND UNLESS AGREED IN WRITING BY TRAVIS BAKER LIMITED NO OTHER PARTY MAY USE OR RELY ON ITS CONTENTS. NO LIABILITY IS ACCEPTED BY TRAVIS BAKER LIMITED FOR ANY USE OF THIS DRAWING OTHER THAN FOR THE PURPOSE FOR WHICH IT WAS ORIGINALLY PREPARED.
6. IT SHOULD BE NOTED THAT THIS DRAWING MAY INCLUDE DATA PROVIDED BY THIRD PARTIES. NO LIABILITY IS ACCEPTED BY TRAVIS BAKER LIMITED AS TO THE ACCURACY OF THIS DATA.
7. THIS DRAWING SHALL NOT BE REPRODUCED IN ANY WAY WITHOUT THE WRITTEN PERMISSION OF TRAVIS BAKER LIMITED.

- KEY
- 125mm x 255mm HALF BATTERED KERB
 - 50mm x 150mm BACK EDGING KERB
 - 125mm x 150mm BULL NOSED KERB WITH 25mm UPSTAND WITH TRANSITIONS AT DROPPED CROSSINGS
 - 125mm x 150mm BULL NOSED KERB WITH 0-6mm UPSTAND WITH TRANSITIONS AT PEDESTRIAN CROSSINGS

CHANGES MADE IN THE LATEST REVISION

REV	DESCRIPTION	DATE	BY	AUTH
D	BREACH LANE FOOTPATH LINK & PEDESTRIAN CROSSING AT NORTHERN PATH ADDED	02.02.24	LK	TW
C	UPDATED TO SHOW SOUTHERN FOOTPATH LINK	04.01.24	LK	TW
B	REMOVED DO NOT SCALE NOTE	29.11.23	LK	TW
A	REINSTATED FULL HEIGHT KERB AT EXISTING ENTRANCE	13.11.23	LK	TW



travis baker

Travis Baker
39 Stoney Street
Lace Market
Nottingham
NG1 1LX

Transport Planning
Flood Risk and Drainage
Geo-Environmental
Civil and Structural Engineering

Nottingham Telephone:
0115 896 6655
info@travisbaker.co.uk
www.travisbaker.co.uk

CLIENT
KEEPMOAT HOMES

PROJECT
CHEADLE ROAD, UPPER TEAN

TITLE
S278 GENERAL ARRANGEMENT

DRAWN LK	AUTHORISED TW	SCALE VARIES@A1	DATE 01.11.23
-------------	------------------	--------------------	------------------

PROJECT NO. 22032	DRAWING NO. 502	REV D
----------------------	--------------------	----------

STATUS.
PRELIMINARY

COPYRIGHT TRAVIS BAKER LIMITED. ALL RIGHTS RESERVED.