





South Elevation

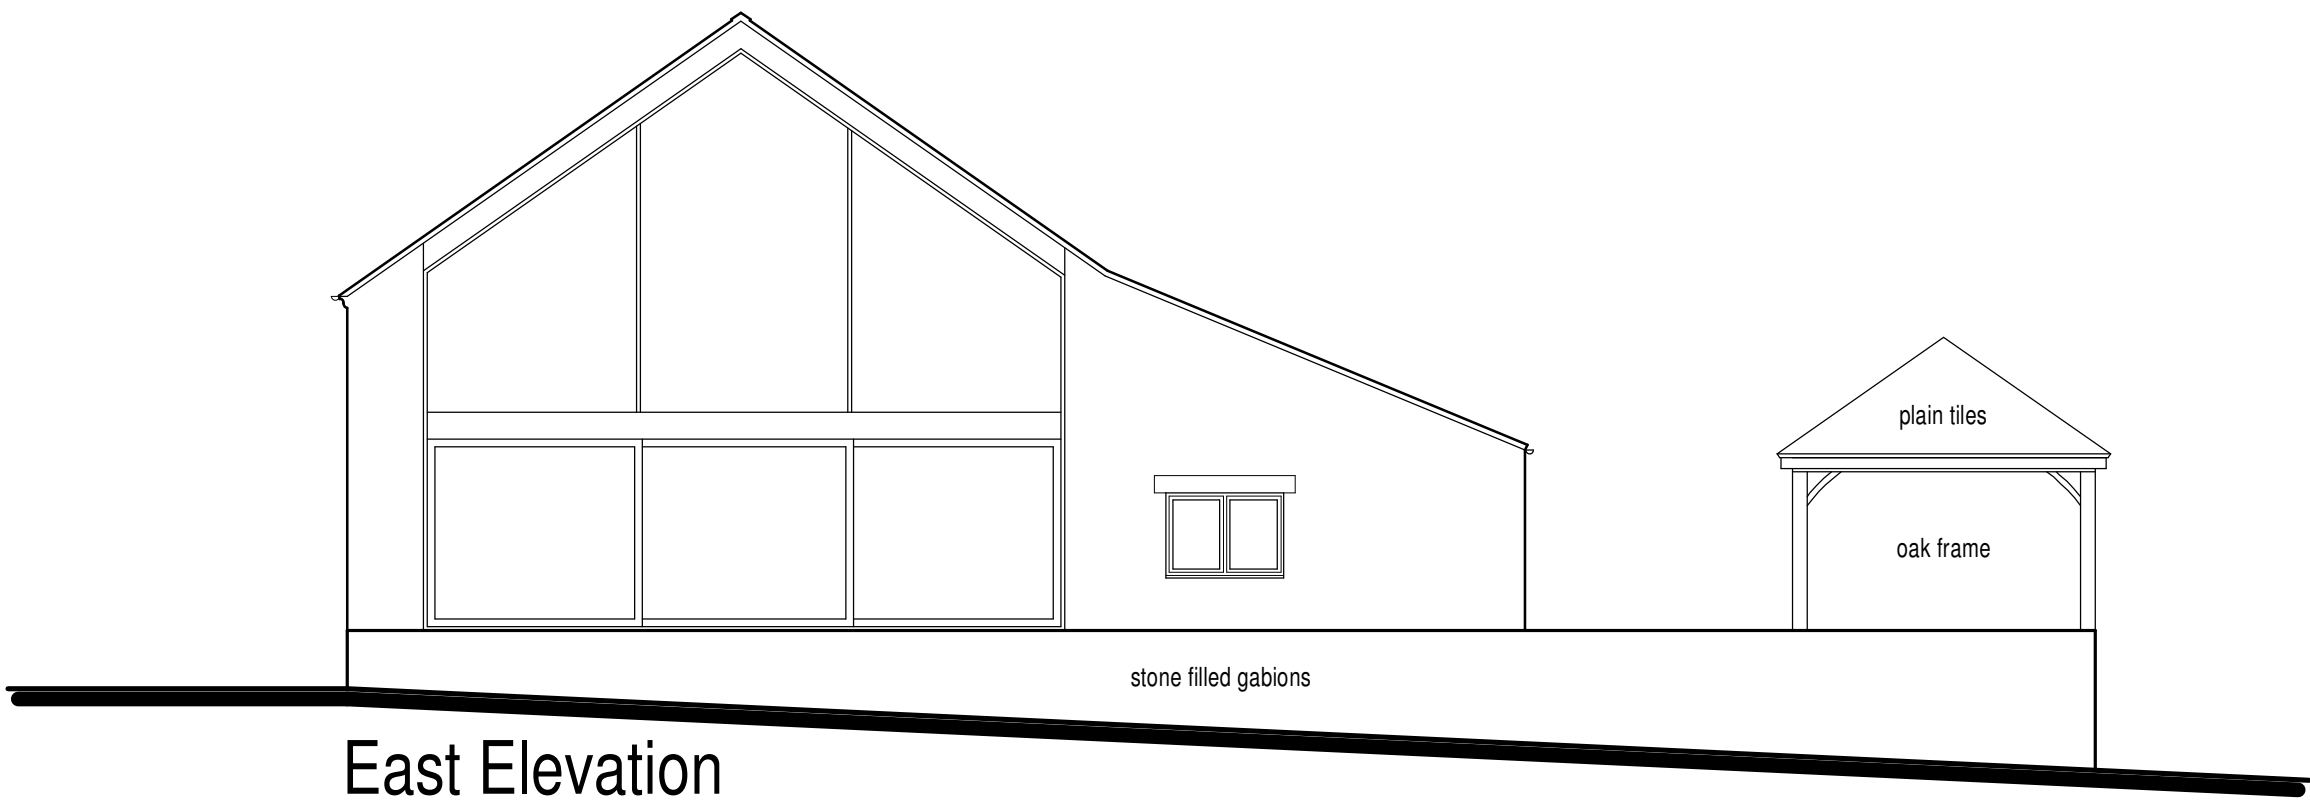


East Elevation




North Elevation

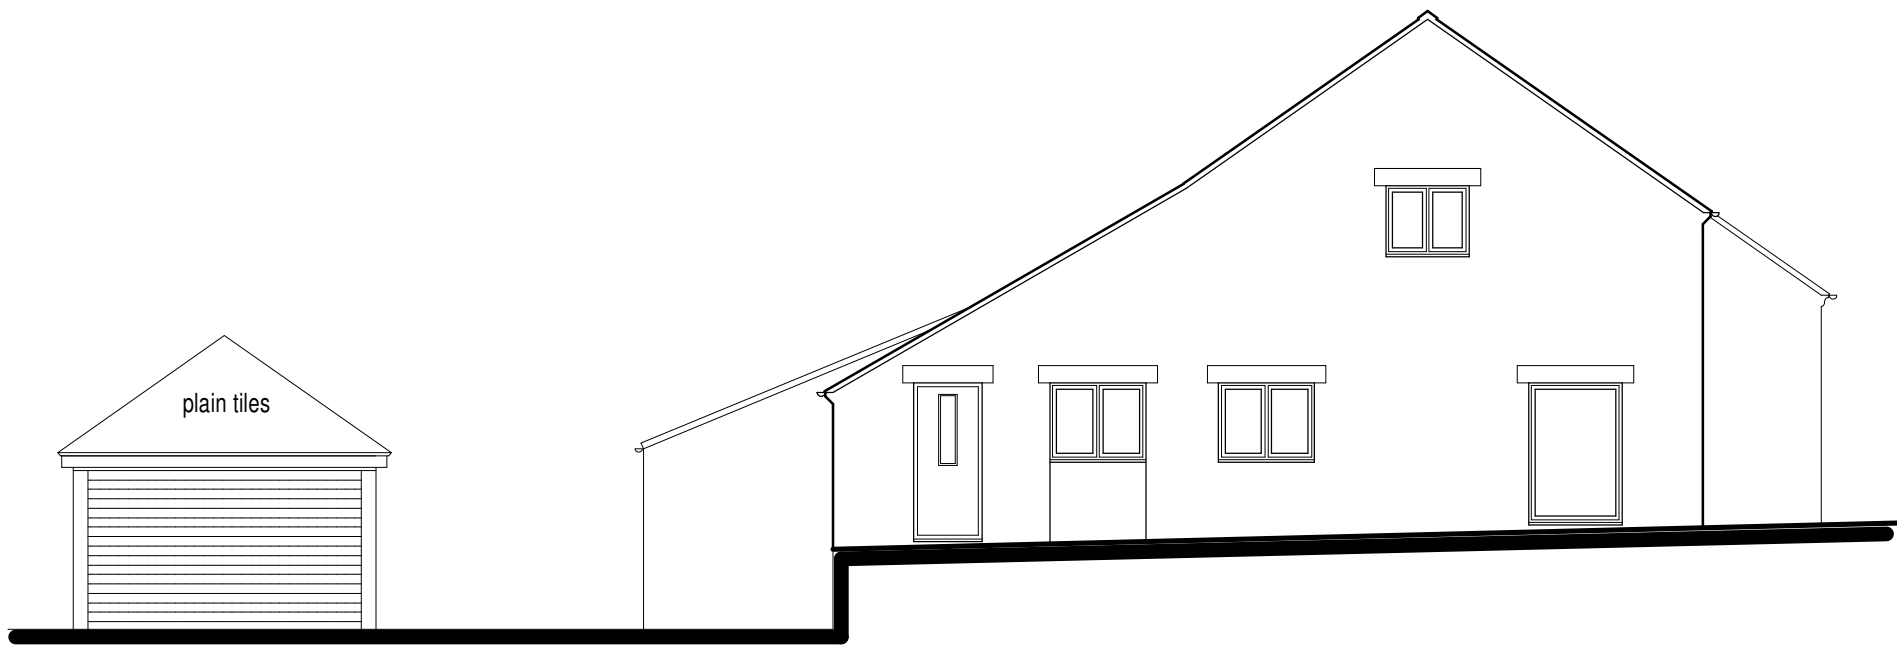

West Elevation

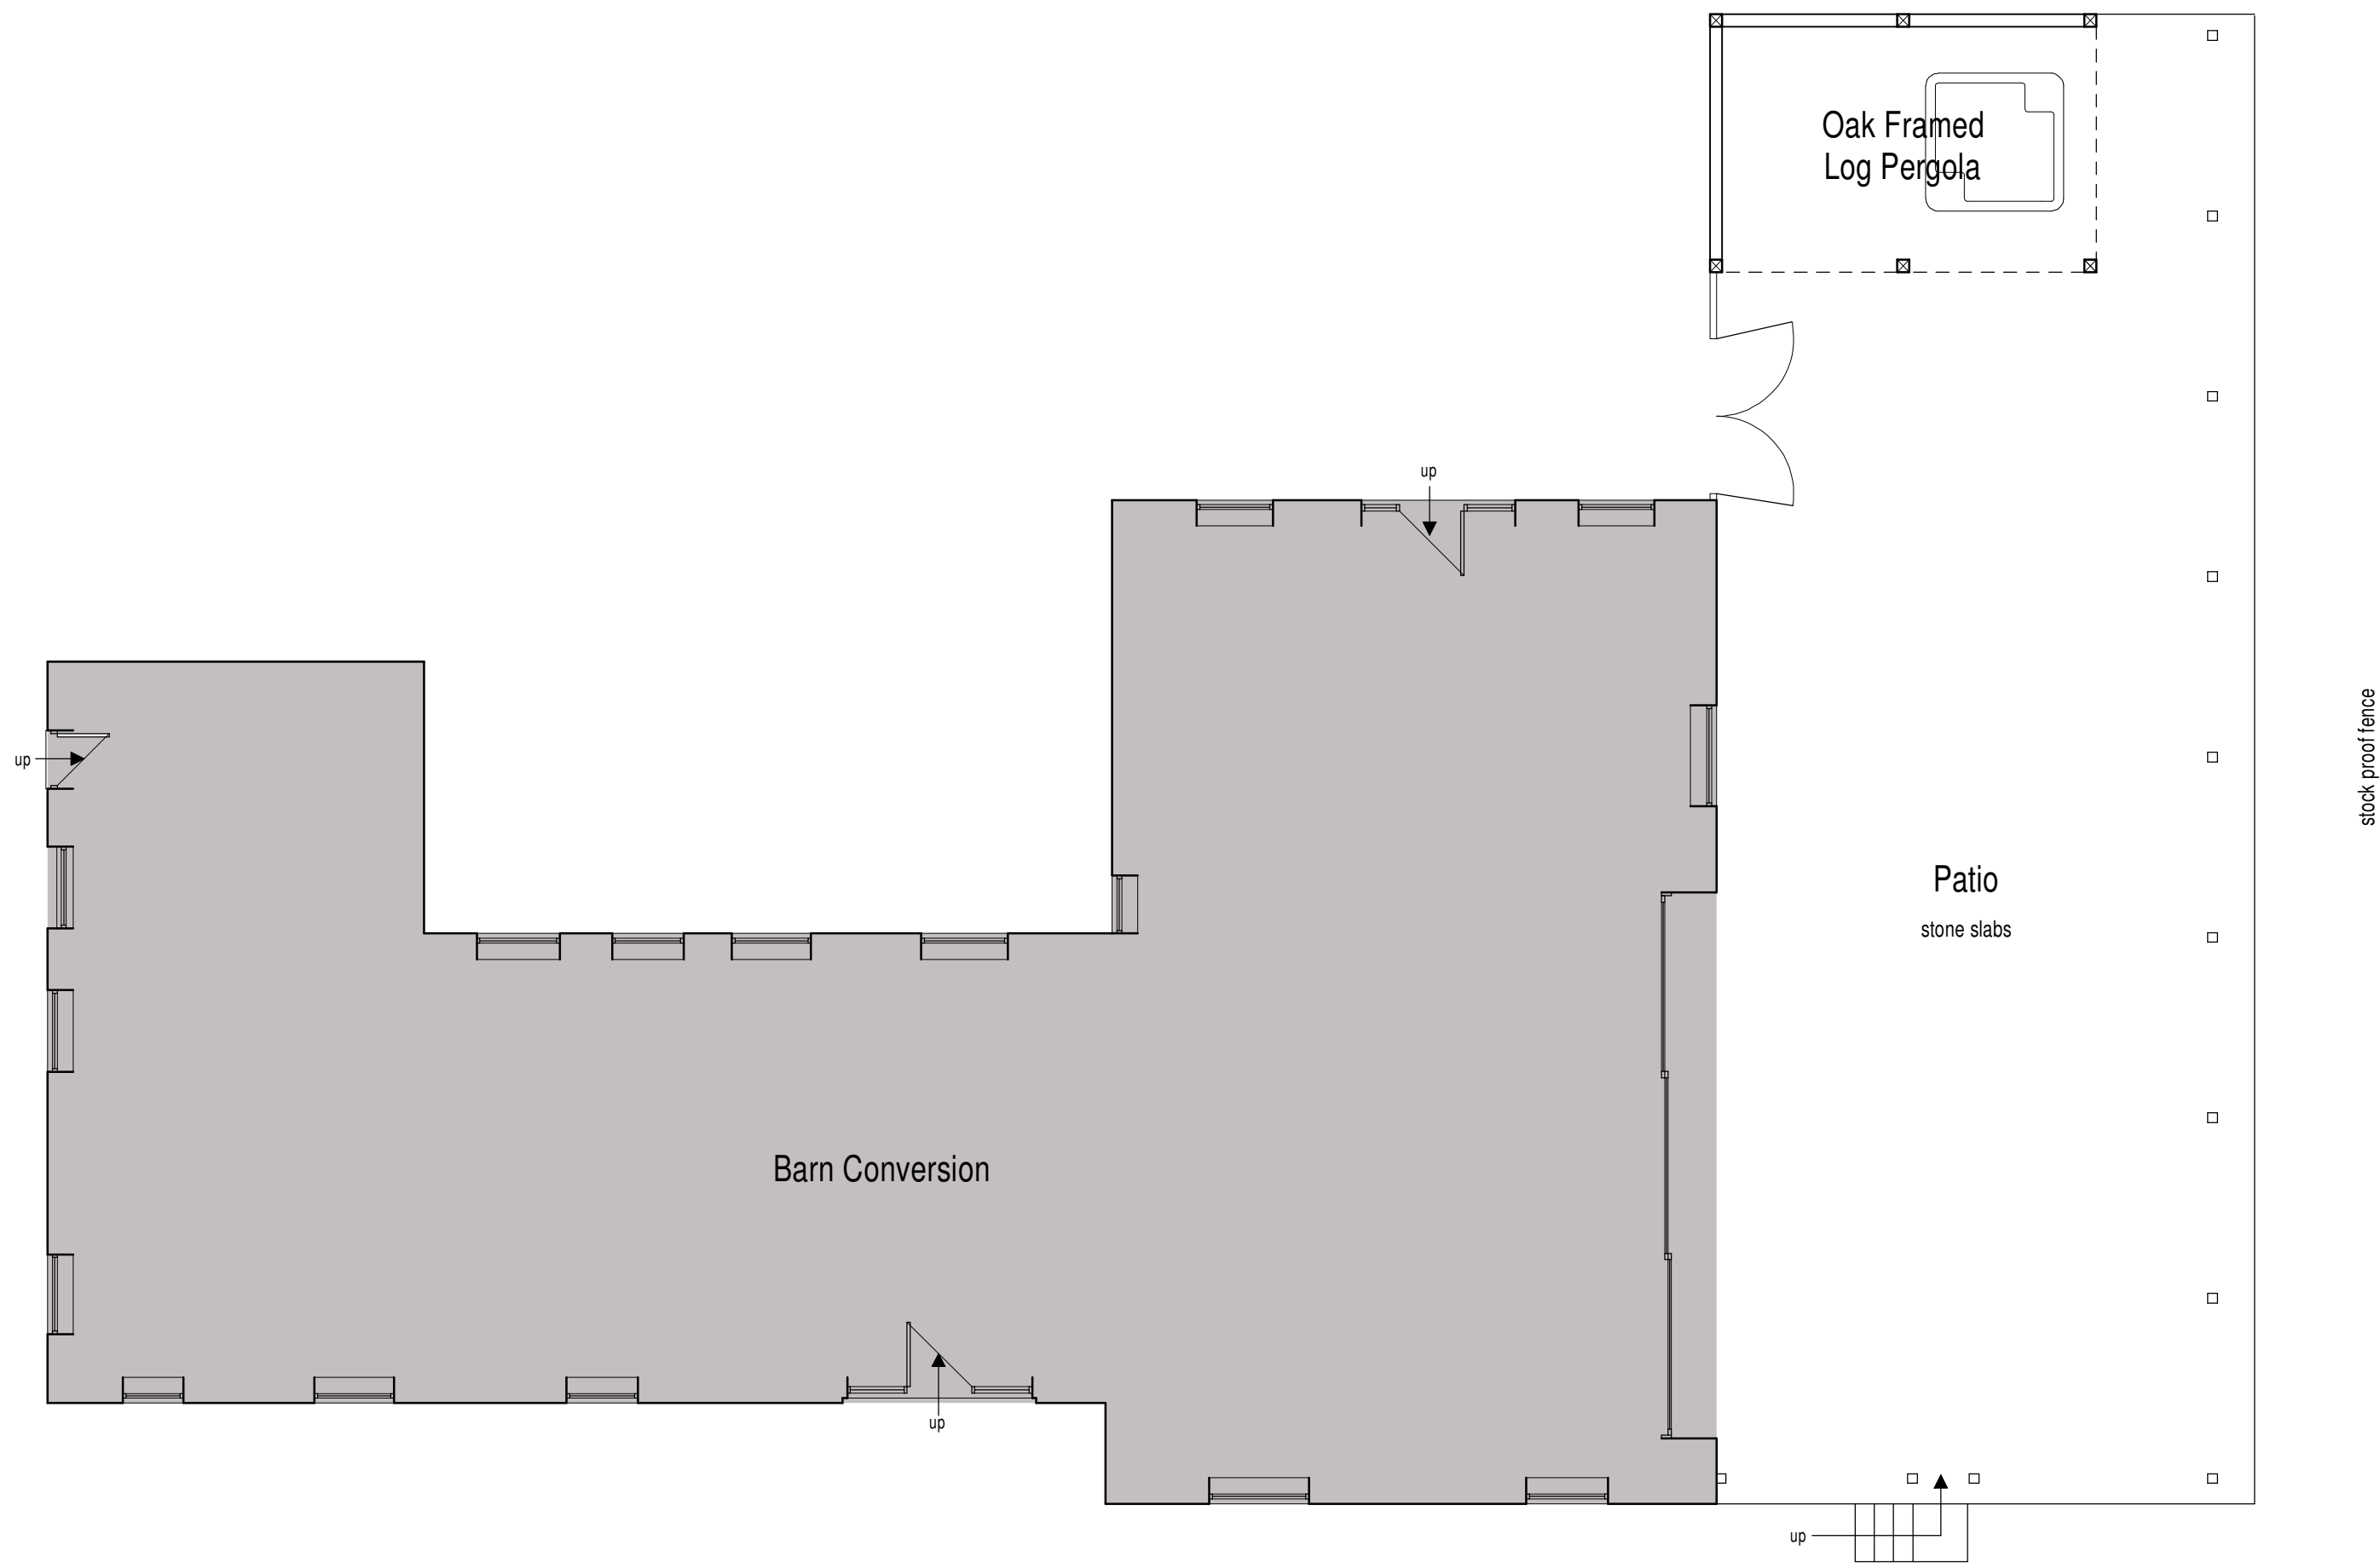

Ground Floor Plan

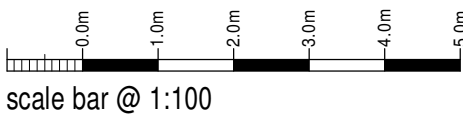

Mr & Mrs Gibson

Retrospective Application for Raised
Patio and Pergola,
Sprinks Farm,
Horton, Leek,
Staffordshire,
ST13 8QE

Raised Patio and Pergola
As Built -
Floor Plans and Elevations

Date	Sheet	Scale
November 2023	A1	1:100
Dwg No.	Rev.	Drawn
2023-2851-13	-	NAW



10 Cawdry Buildings, Fountain Street, Leek, ST13 6JP
Telephone: 01538 386002
E-mail: info@sammonsltd.co.uk
Web: www.sammonsltd.co.uk

This drawing is copyright.
All dimensions must be checked prior to commencement.