




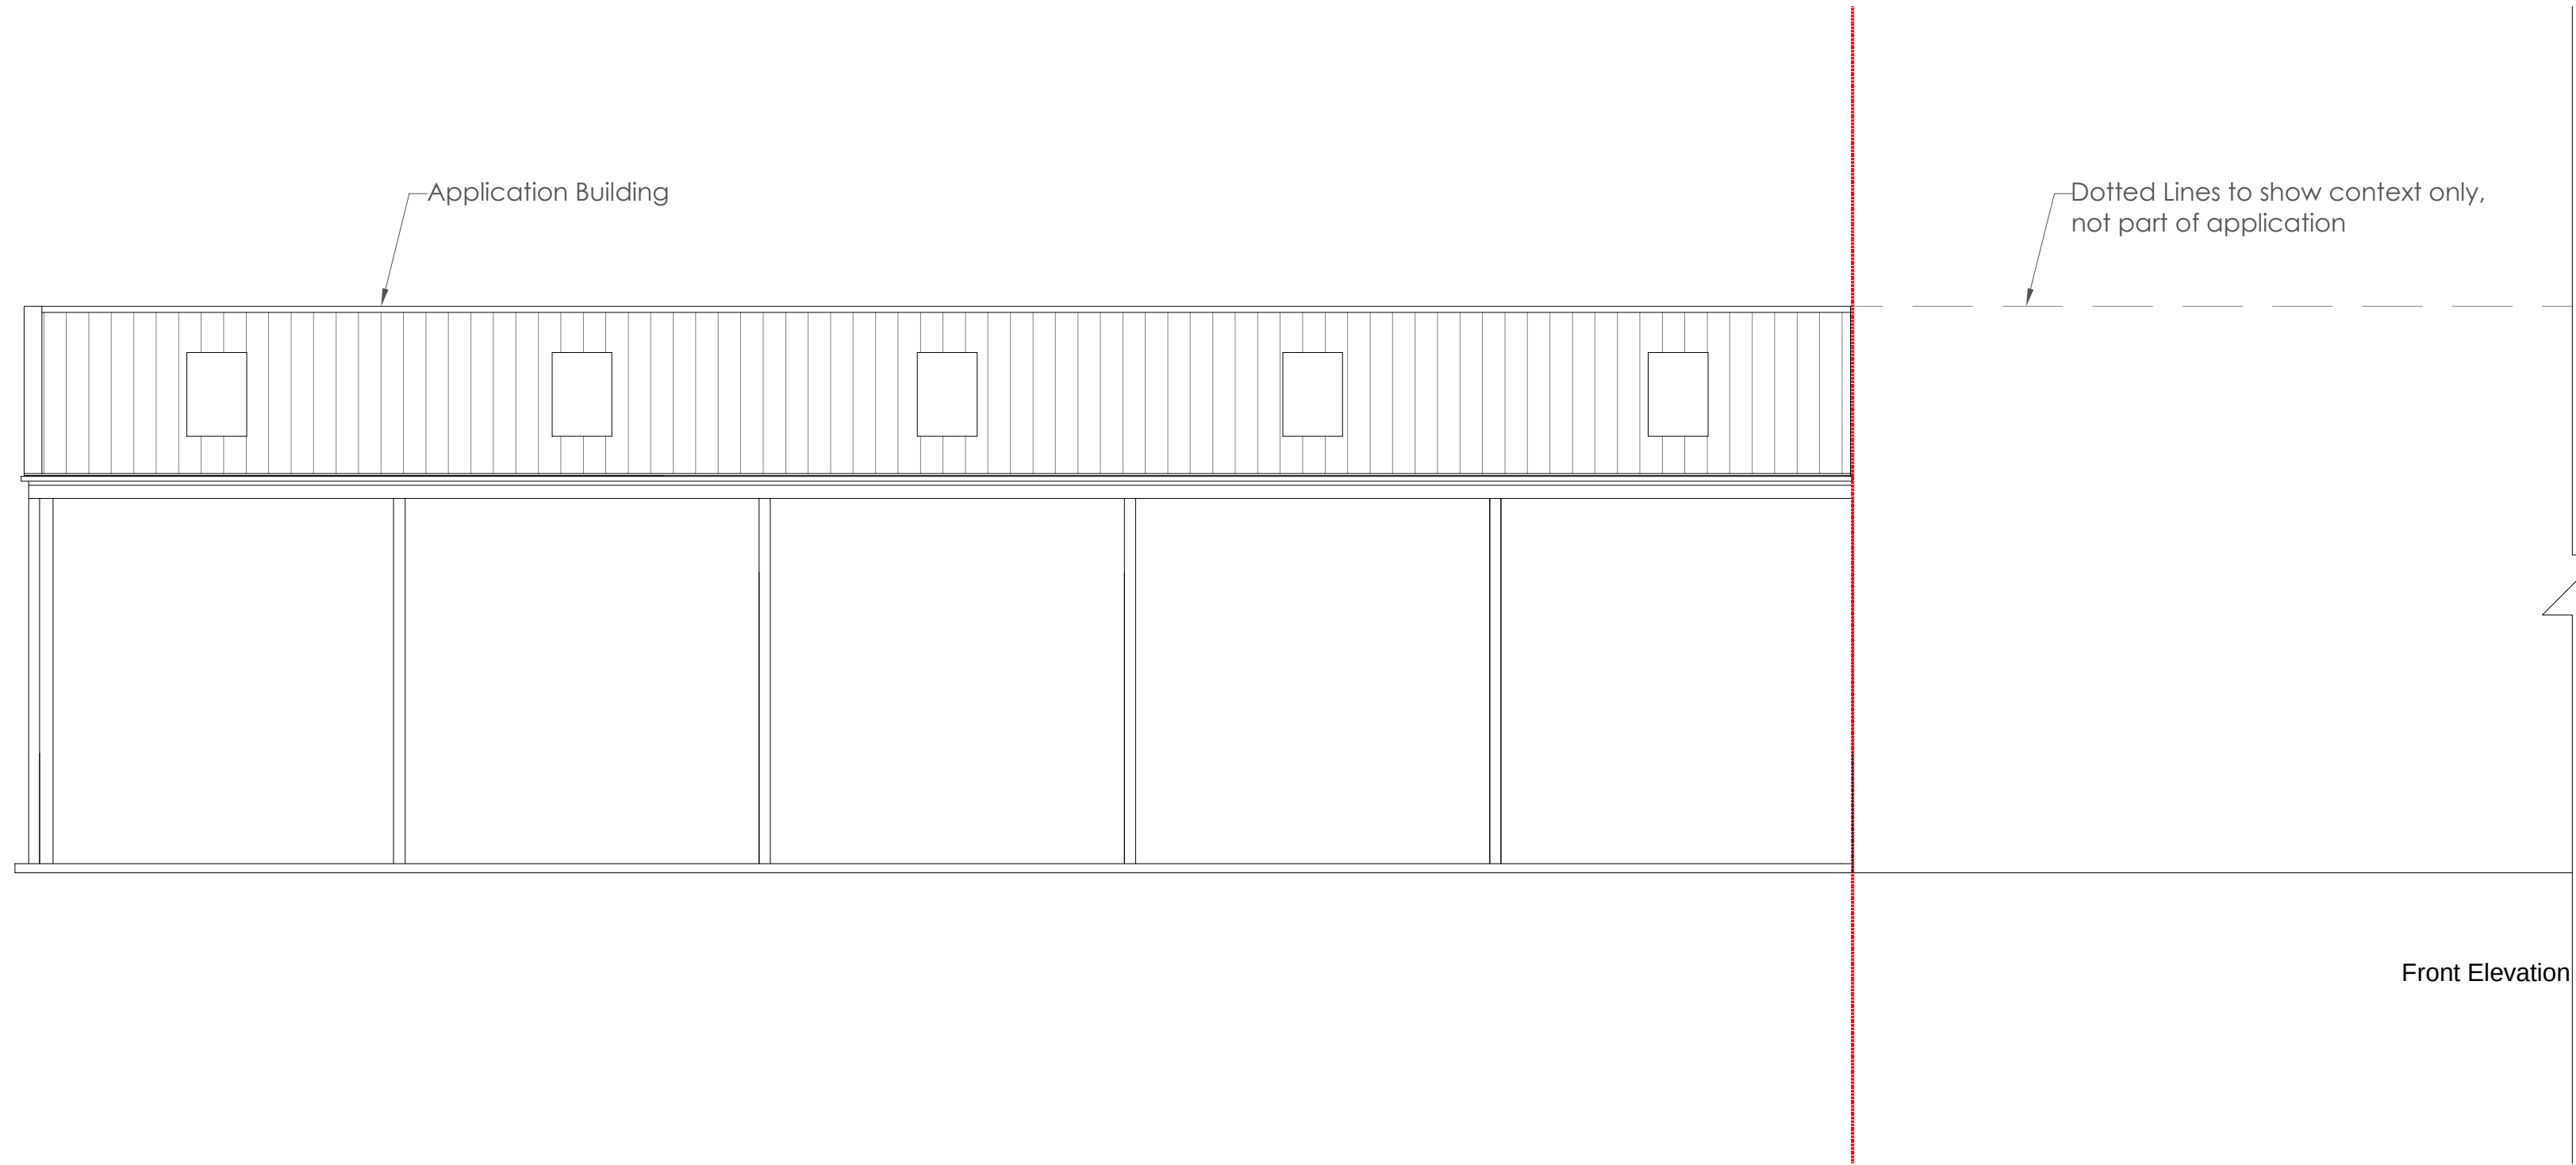


Front Elevation

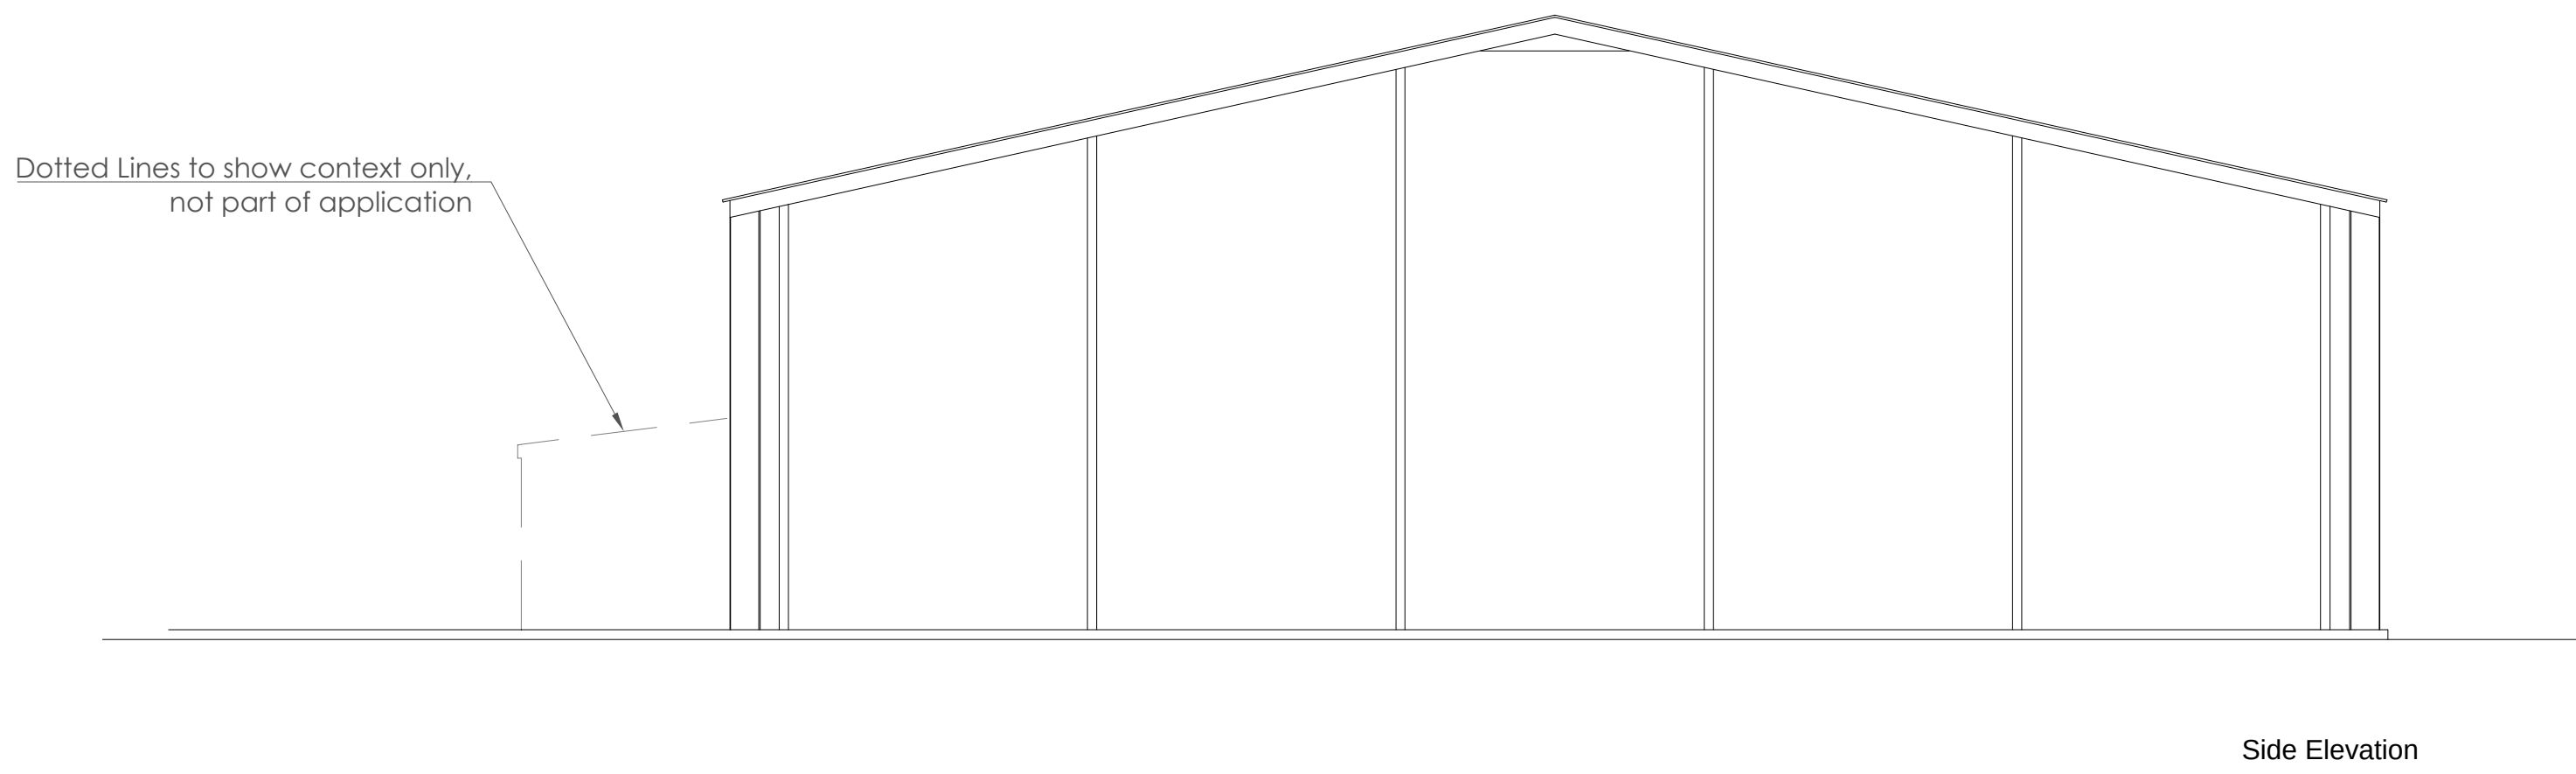

Side Elevation

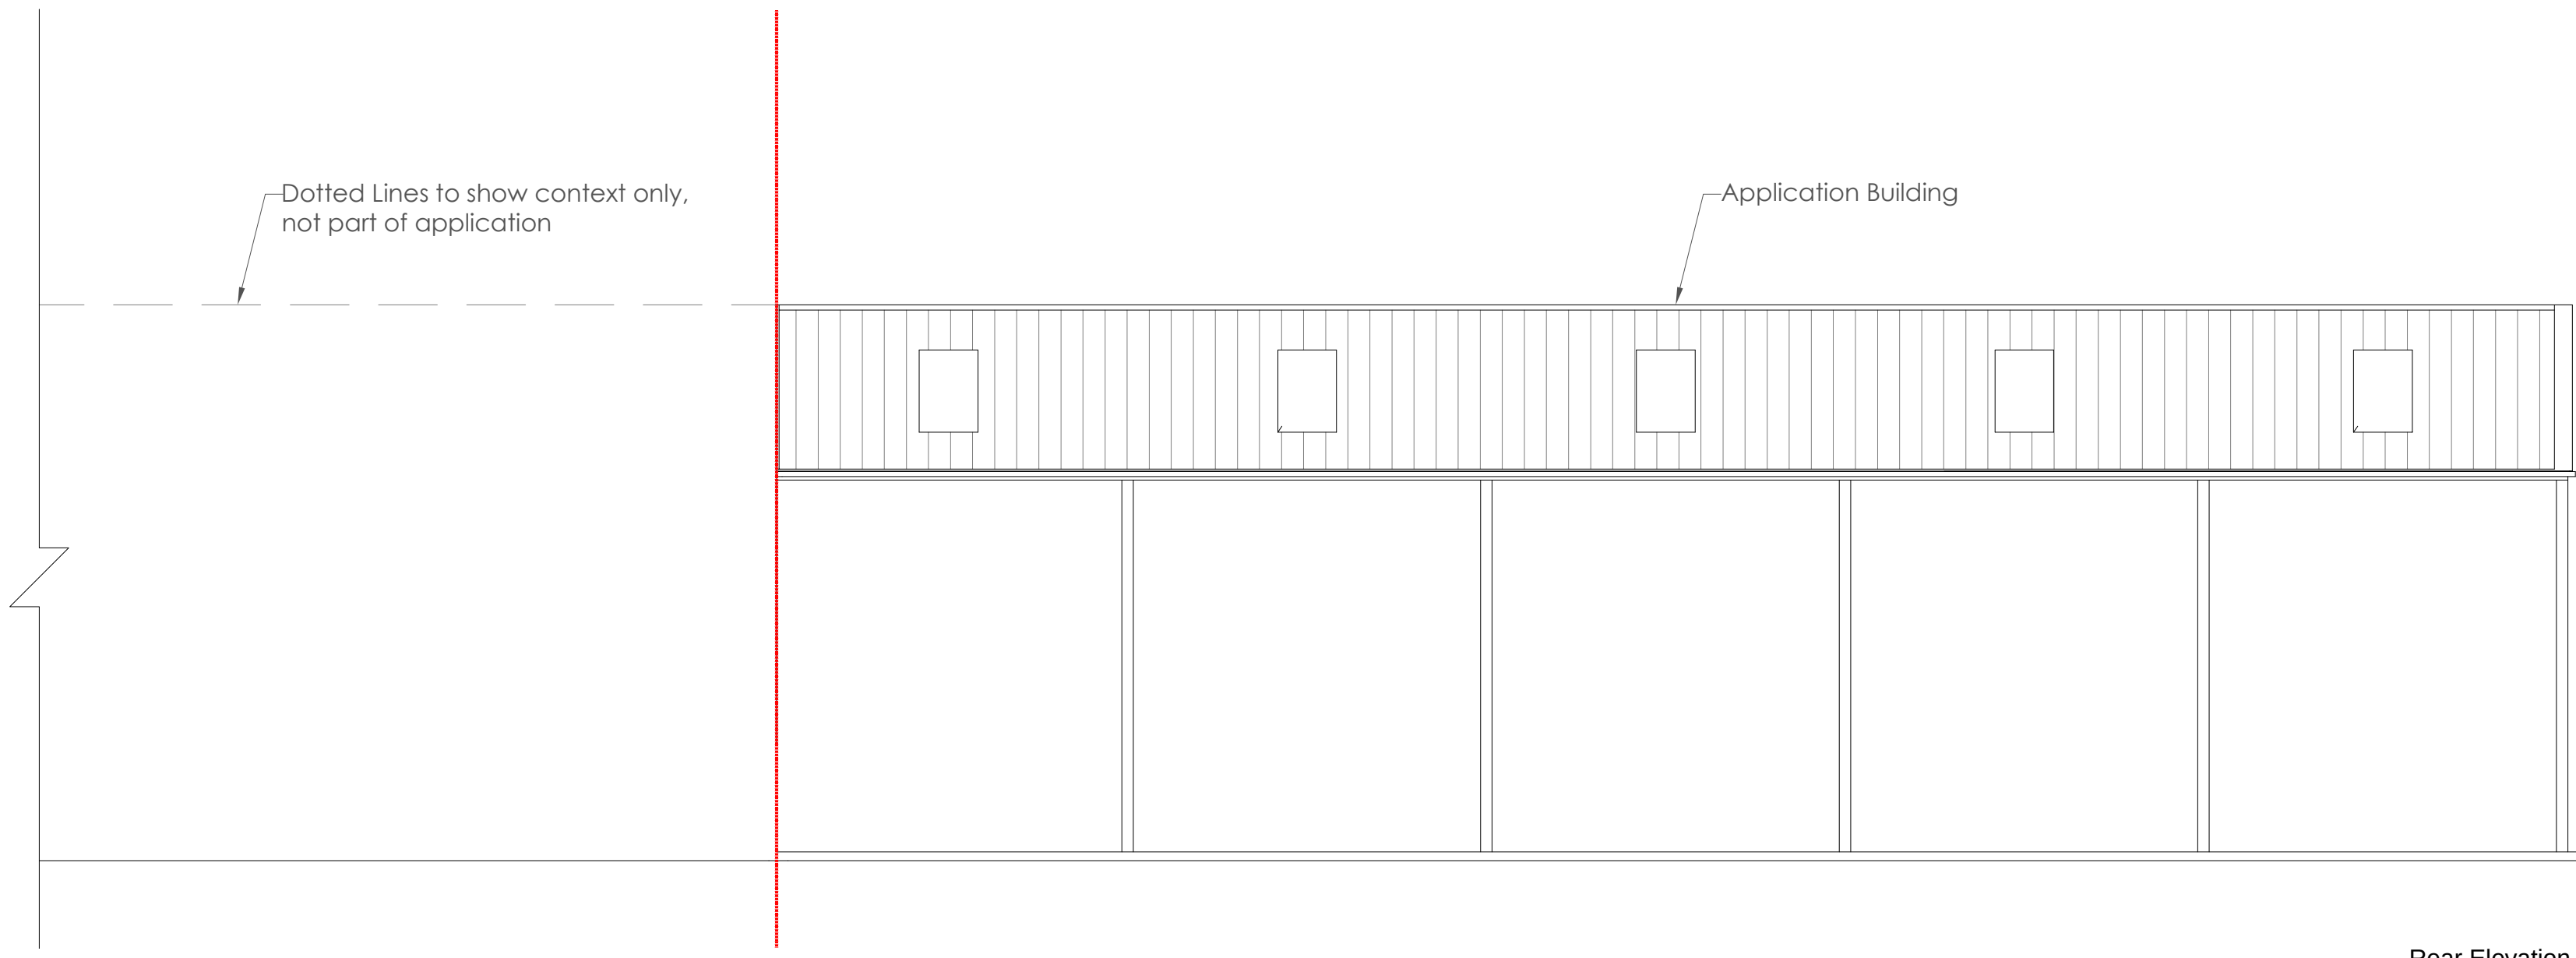

Rear Elevation

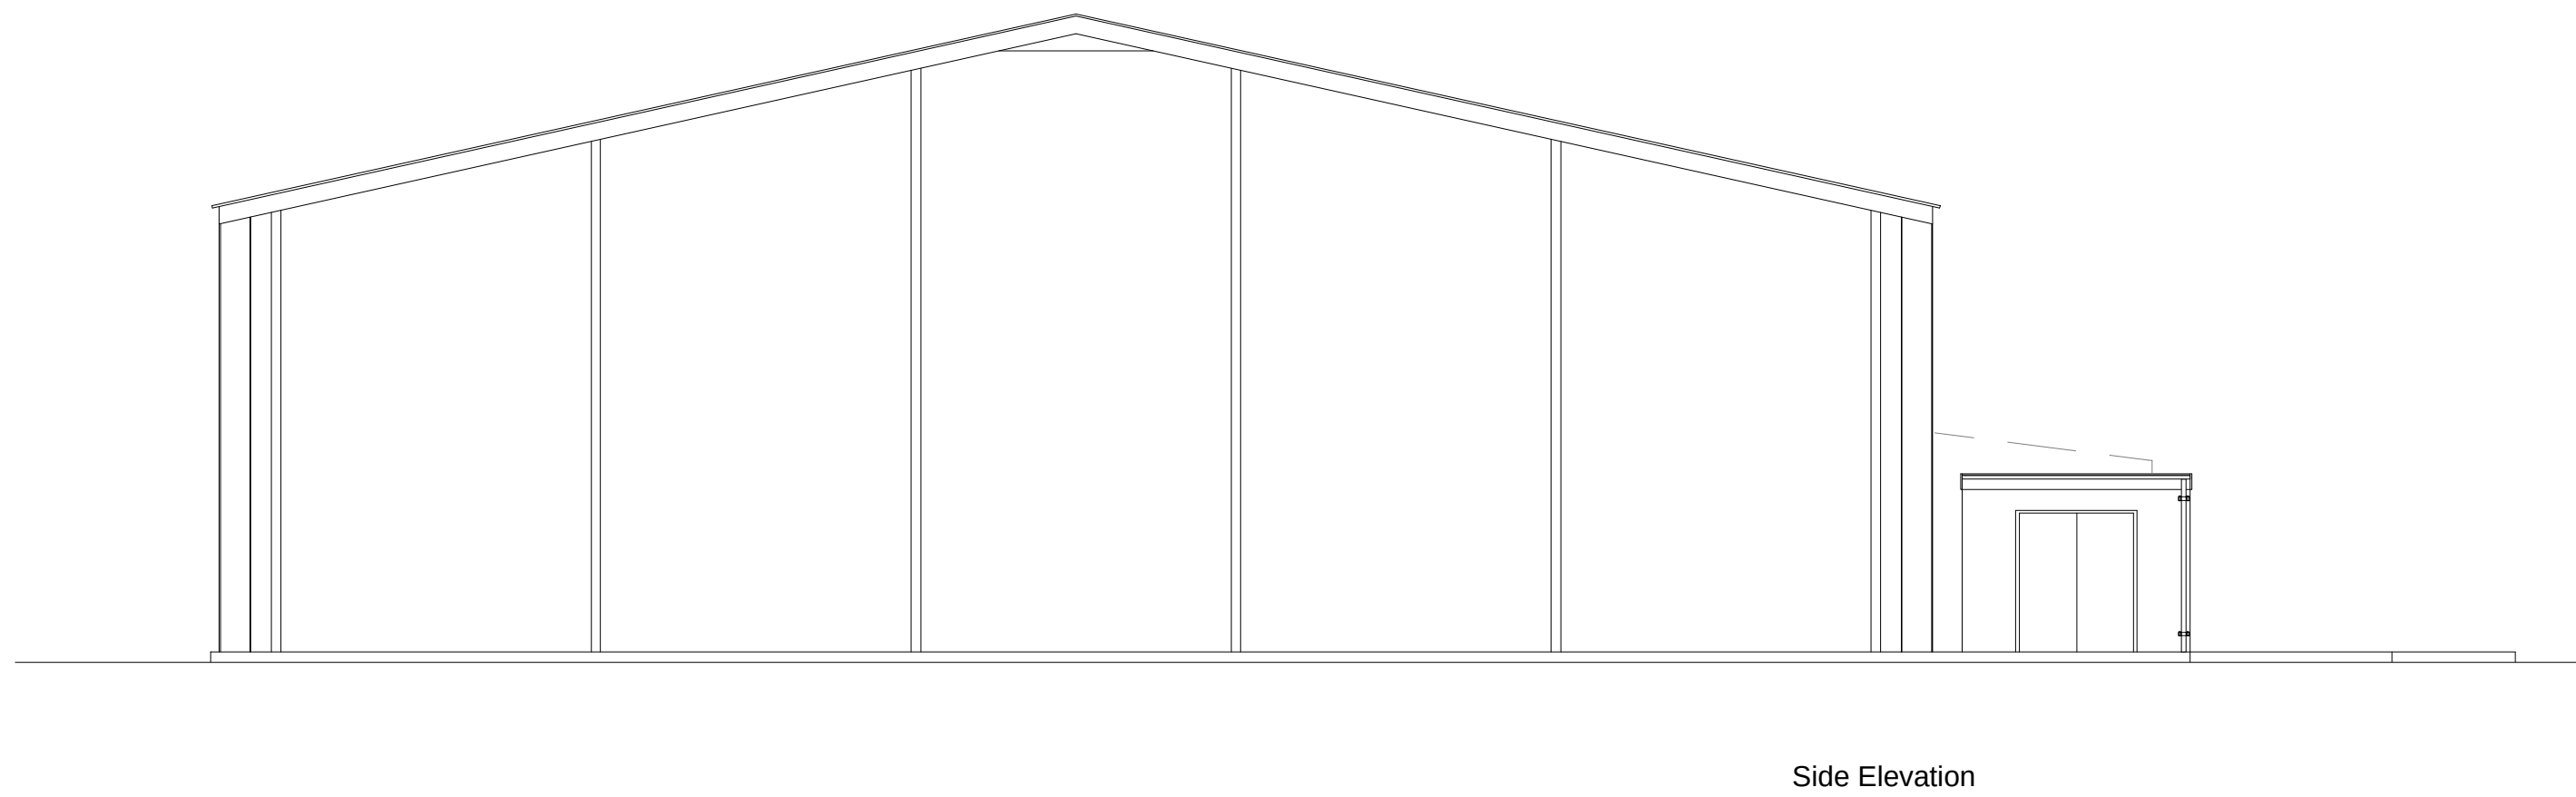

Side Elevation



Ground Floor Plan

Application:
Sylvesters Farm
Extension and COU

Drawing title:
As Built Plans

Scale:
1:100 @ A0

Drawing number:
1302/1230080/003.1

Date:
24 October 2023

Drawn by:
SK