




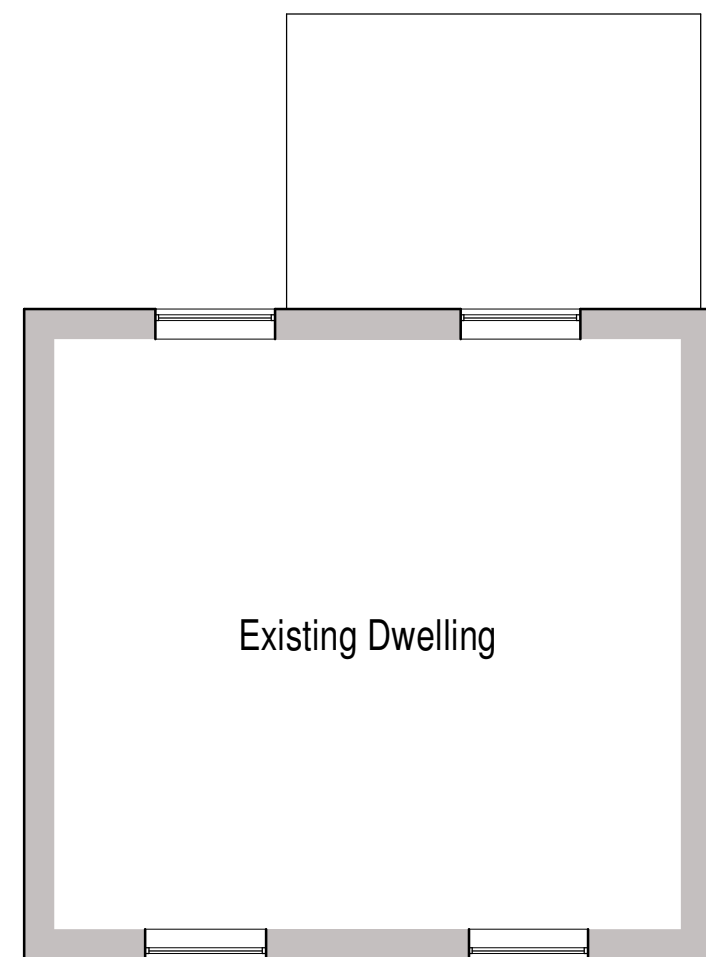

First Floor Plan

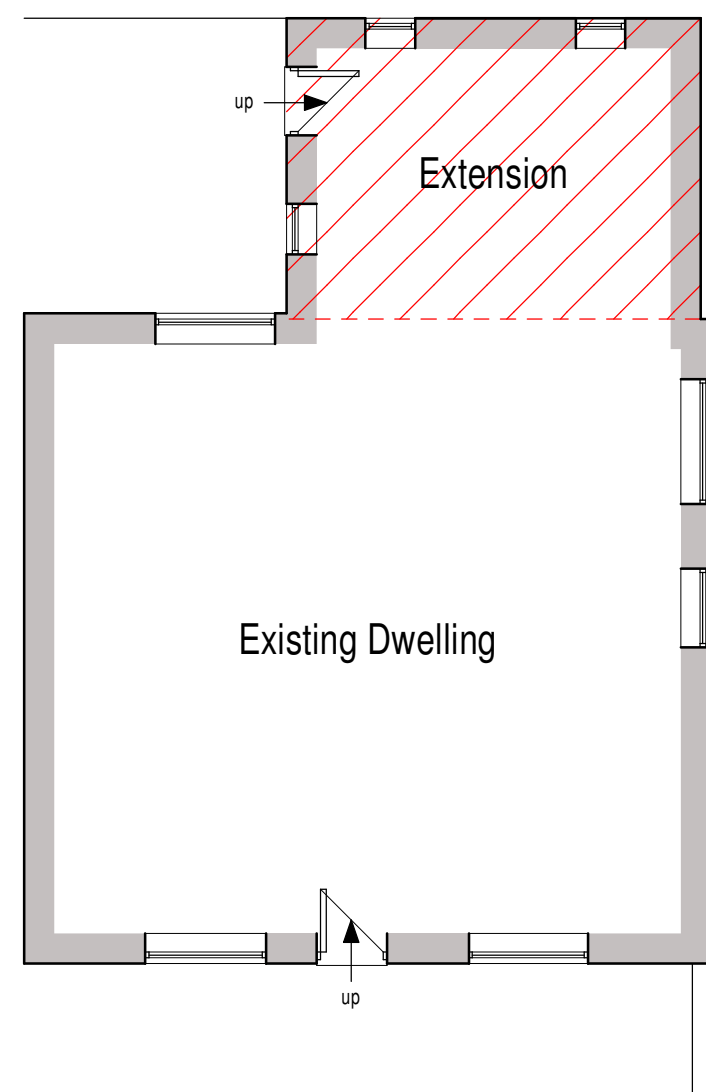


Ground Floor Plan

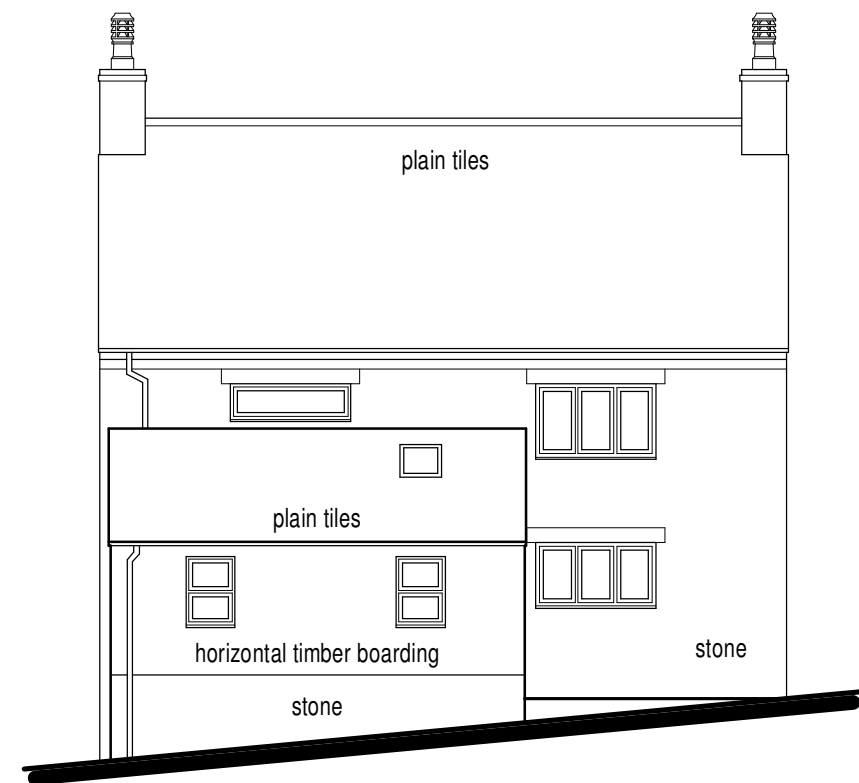

North Elevation




South Elevation

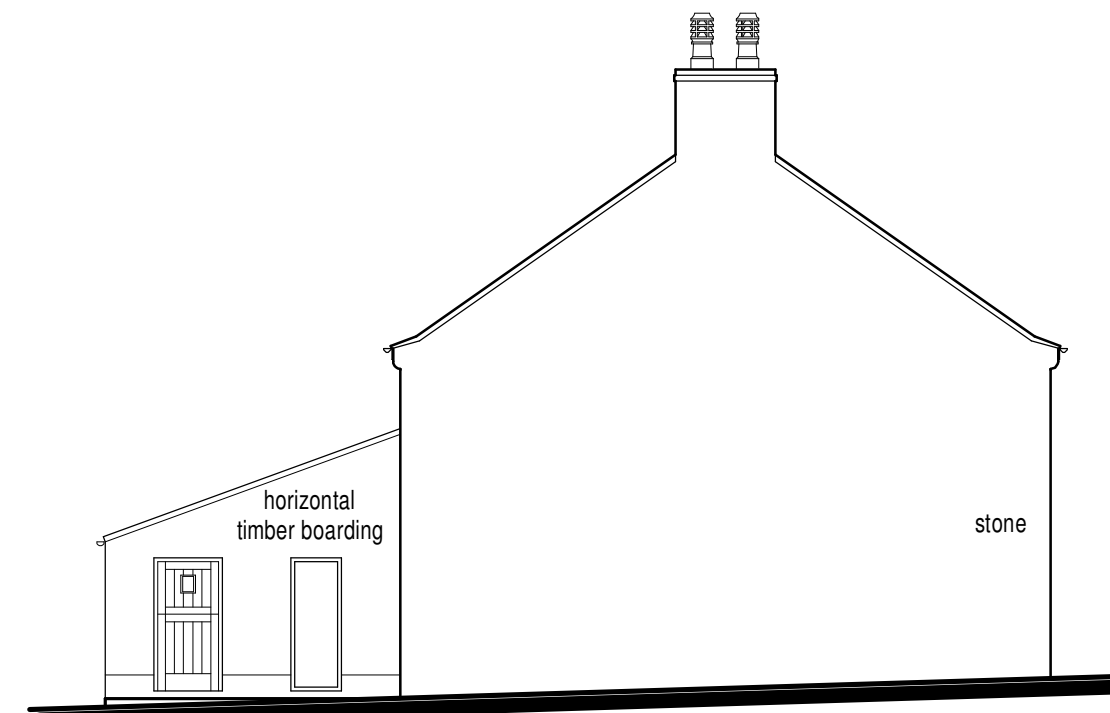

West Elevation



East Elevation

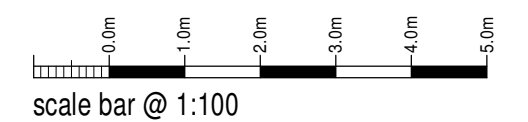

Mr & Mrs Gibson

Retrospective Application for
Rear Extension to Farmhouse,
Sprinks Farm,
Horton, Leek,
Staffordshire,
ST13 8QE

Farmhouse
As Built -
Floor Plans and Elevations

Date	Sheet	Scale
November 2023	A2	1:100
Org No.	Rev.	Drawn
2023-2851-03	-	NAW



10 Cawdry Buildings, Fountain Street, Leek. ST13 6JP
Telephone: 01538 386002
E-mail: info@sammonsltd.co.uk
Web: www.sammonsltd.co.uk

This drawing is copyright.
All dimensions must be checked prior to commencement.