



Copyright of this drawing is vested in the Architect and it must not be copied or reproduced without consent. Figured dimensions only are to be taken from this drawing. All contractors must visit the site and be responsible for taking and checking all dimensions relative to their work. Hewitt&Carr Architects Ltd are to be advised of any variation between drawings and site conditions. **CLIENTS ARE ADVISED TO CLARIFY DIMENSIONS WITH THE ARCHITECT PRIOR TO SETTING OUT AND NOT TO SCALE FROM THE DRAWING**


Rev	Drawn	Comments	Date
-----	-------	----------	------

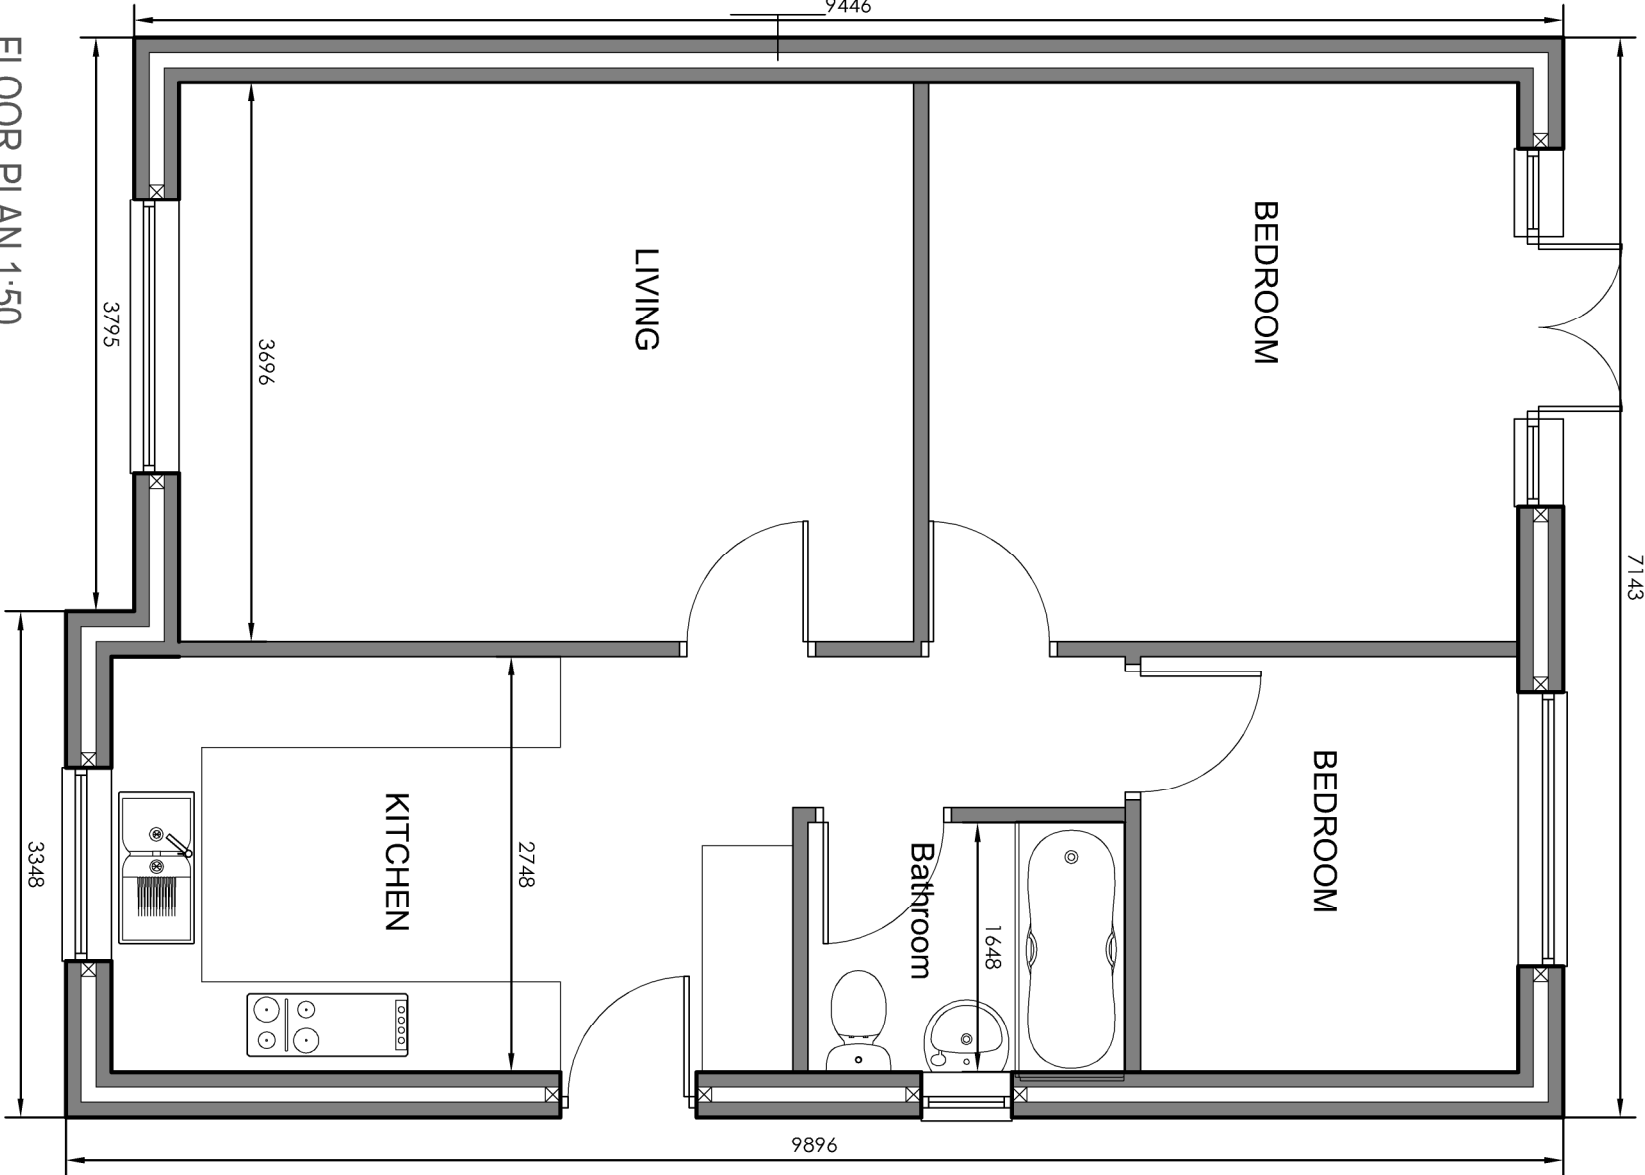


FLOOR PLAN 1:50

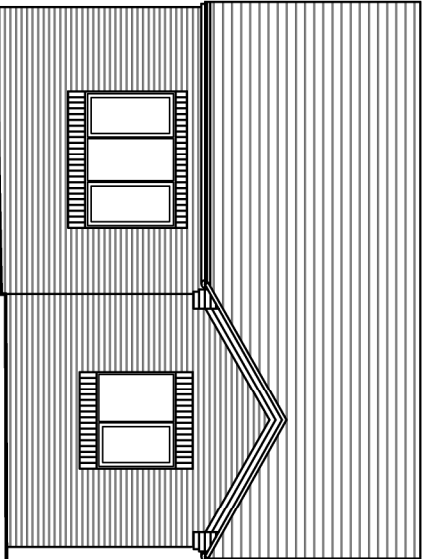


NORTH ELEVATION 1:100

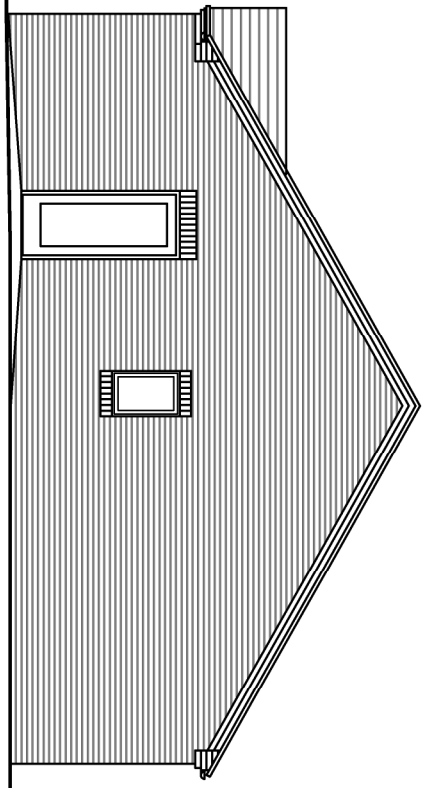

WEST ELEVATION 1:100

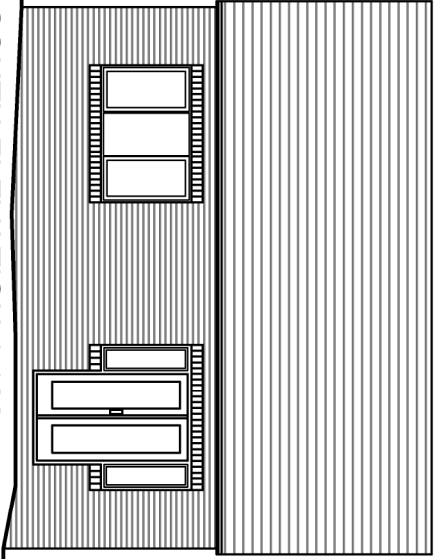

SOUTH ELEVATION 1:100

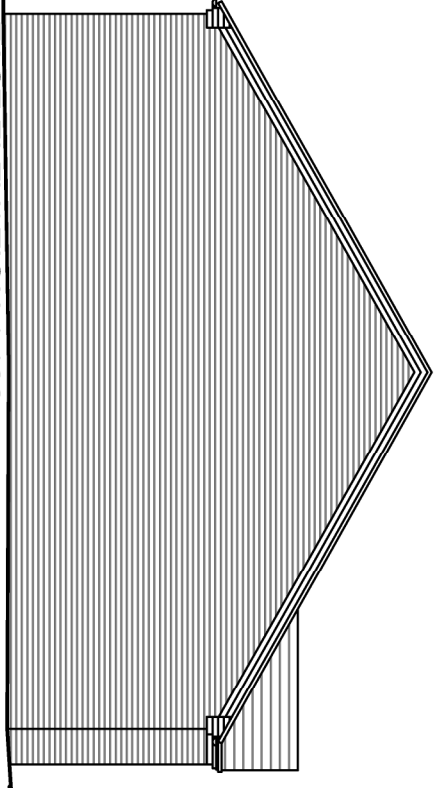

EAST ELEVATION 1:100

Hewitt&Carr Architects
A: DaisyBank House | 17-19 Leek Road | Cheadle | ST10 1JE
T: 01538 756888
E: enquiries@hccarchitects.co.uk
W: www.hccarchitects.co.uk

Client
Mike Ward

Project
Proposed development
Plot 1 Land South of Turners Pasture Cheadle
ST10 1FR
Title
As built floor plan and elevation

Status
Retrospective planning
Date
May 2026
Scale @A3
As Stated

Project No.
01538 AL(0) 02
Drawing No.
02
Rev