




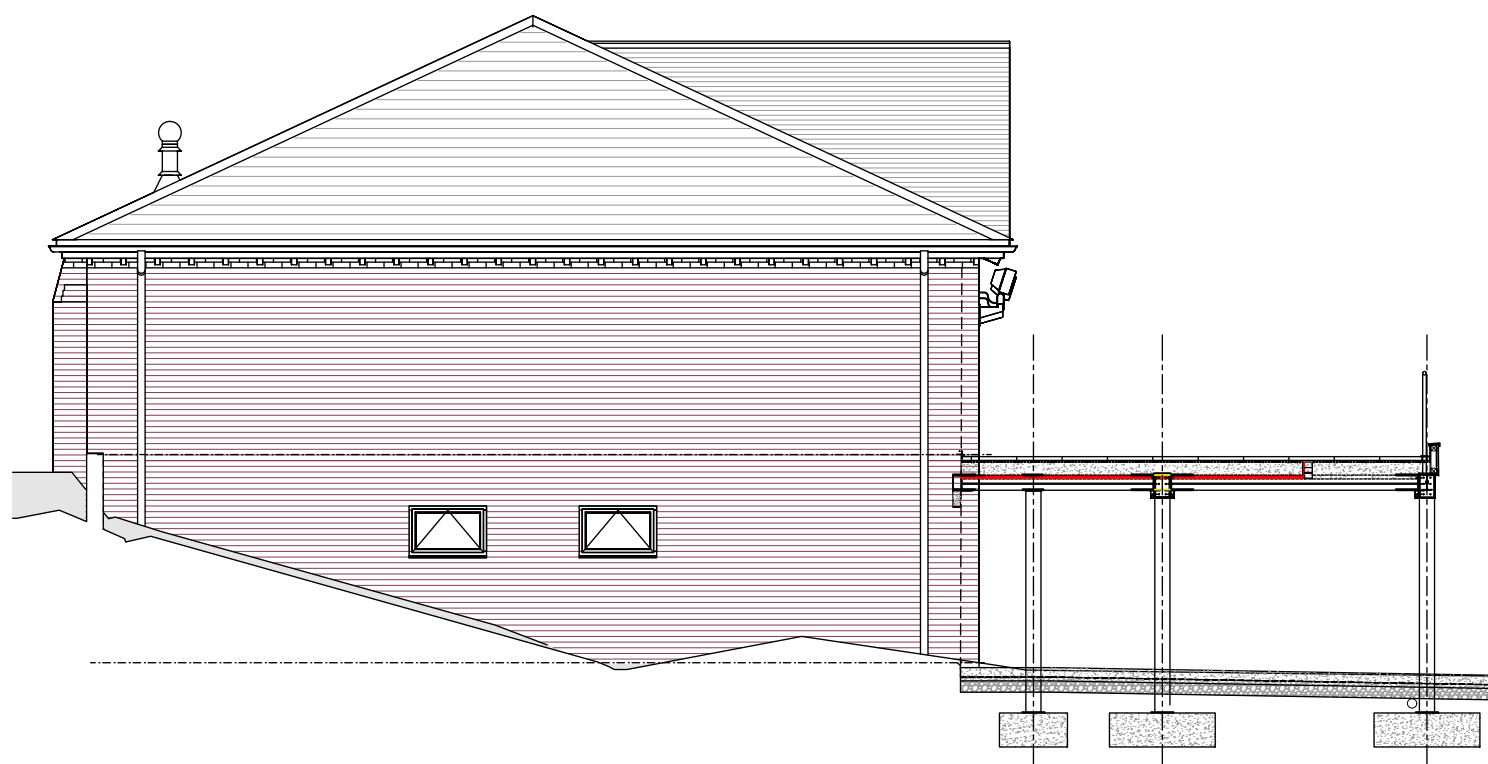


NORTH EAST ELEVATION SCALE 1:100

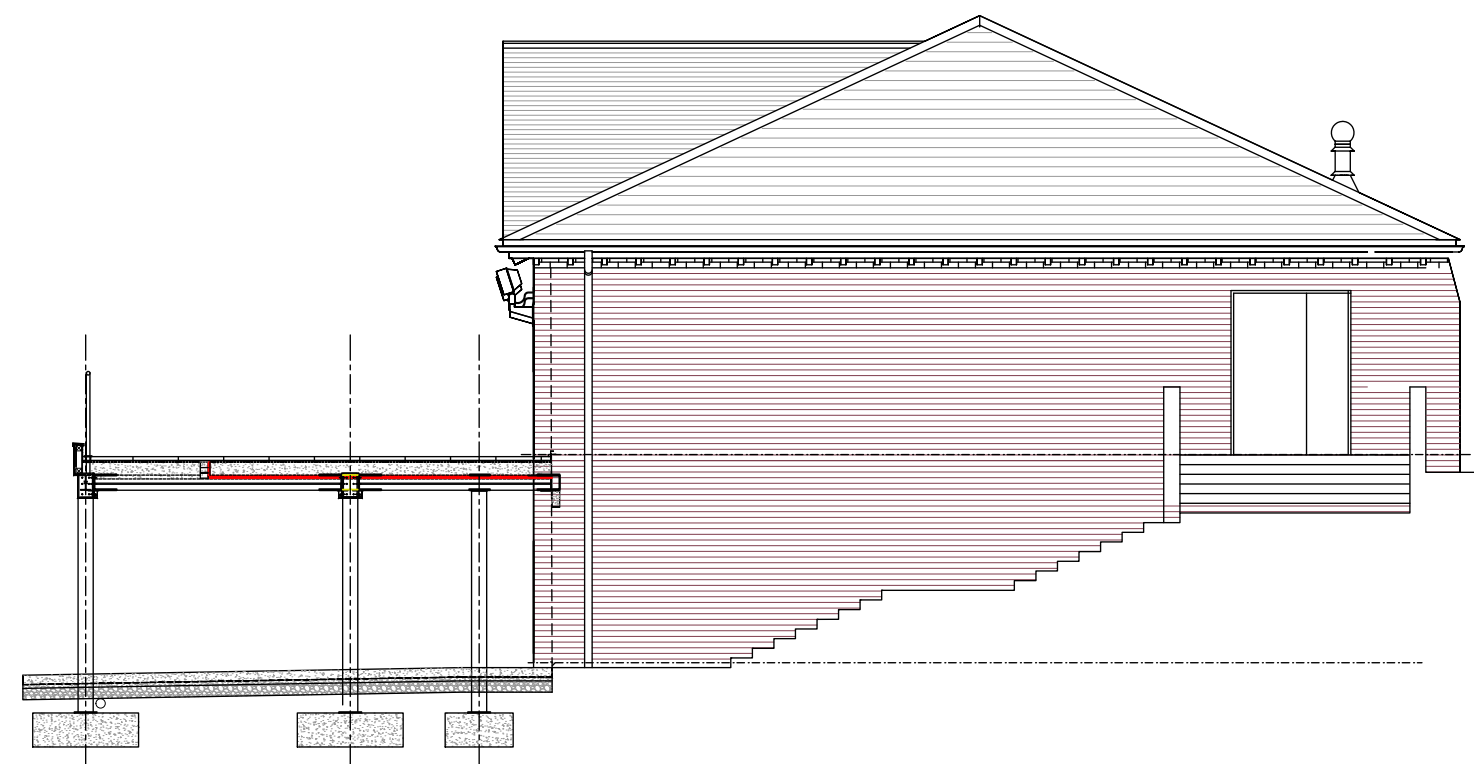


SOUTH WEST ELEVATION SCALE 1:100

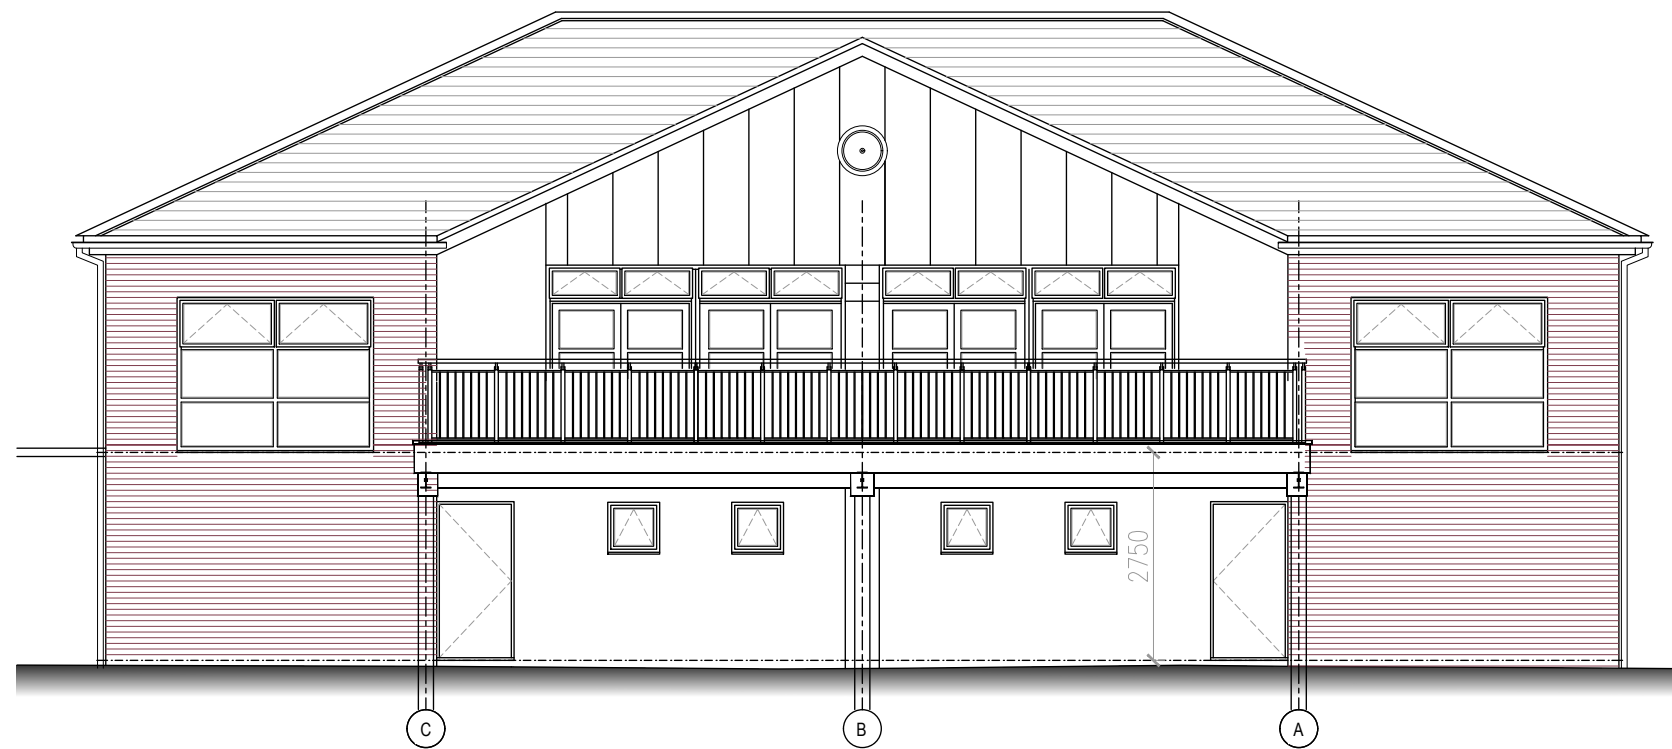


NORTH WEST ELEVATION SCALE 1:100

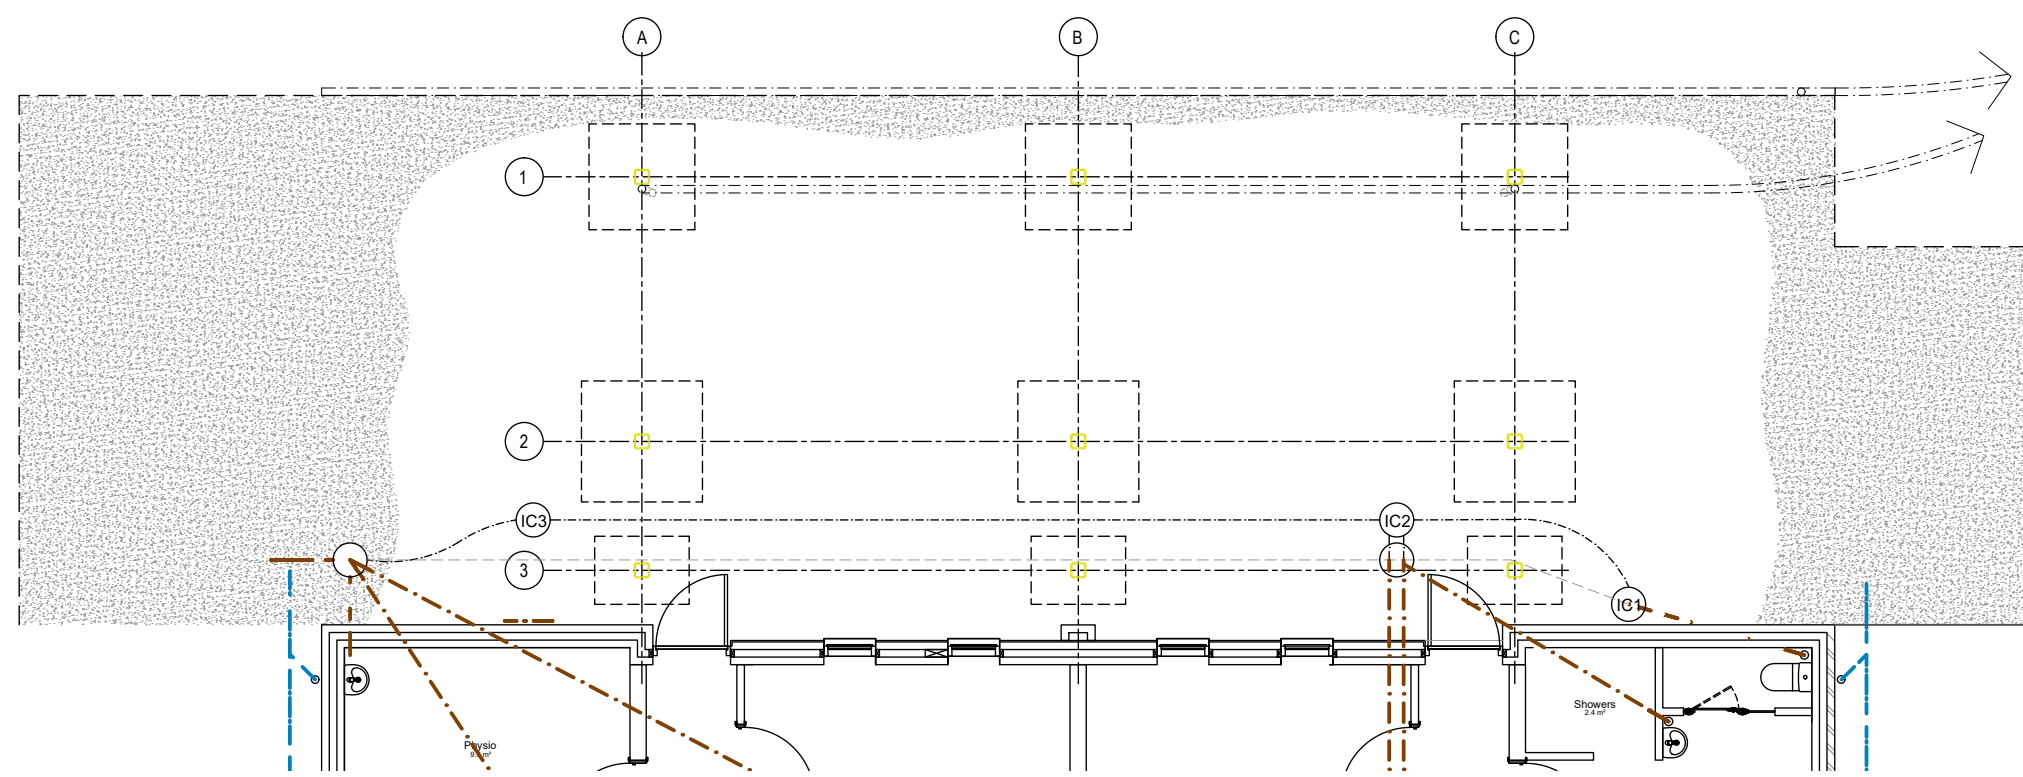


GROUND FLOOR PLAN SCALE 1:100

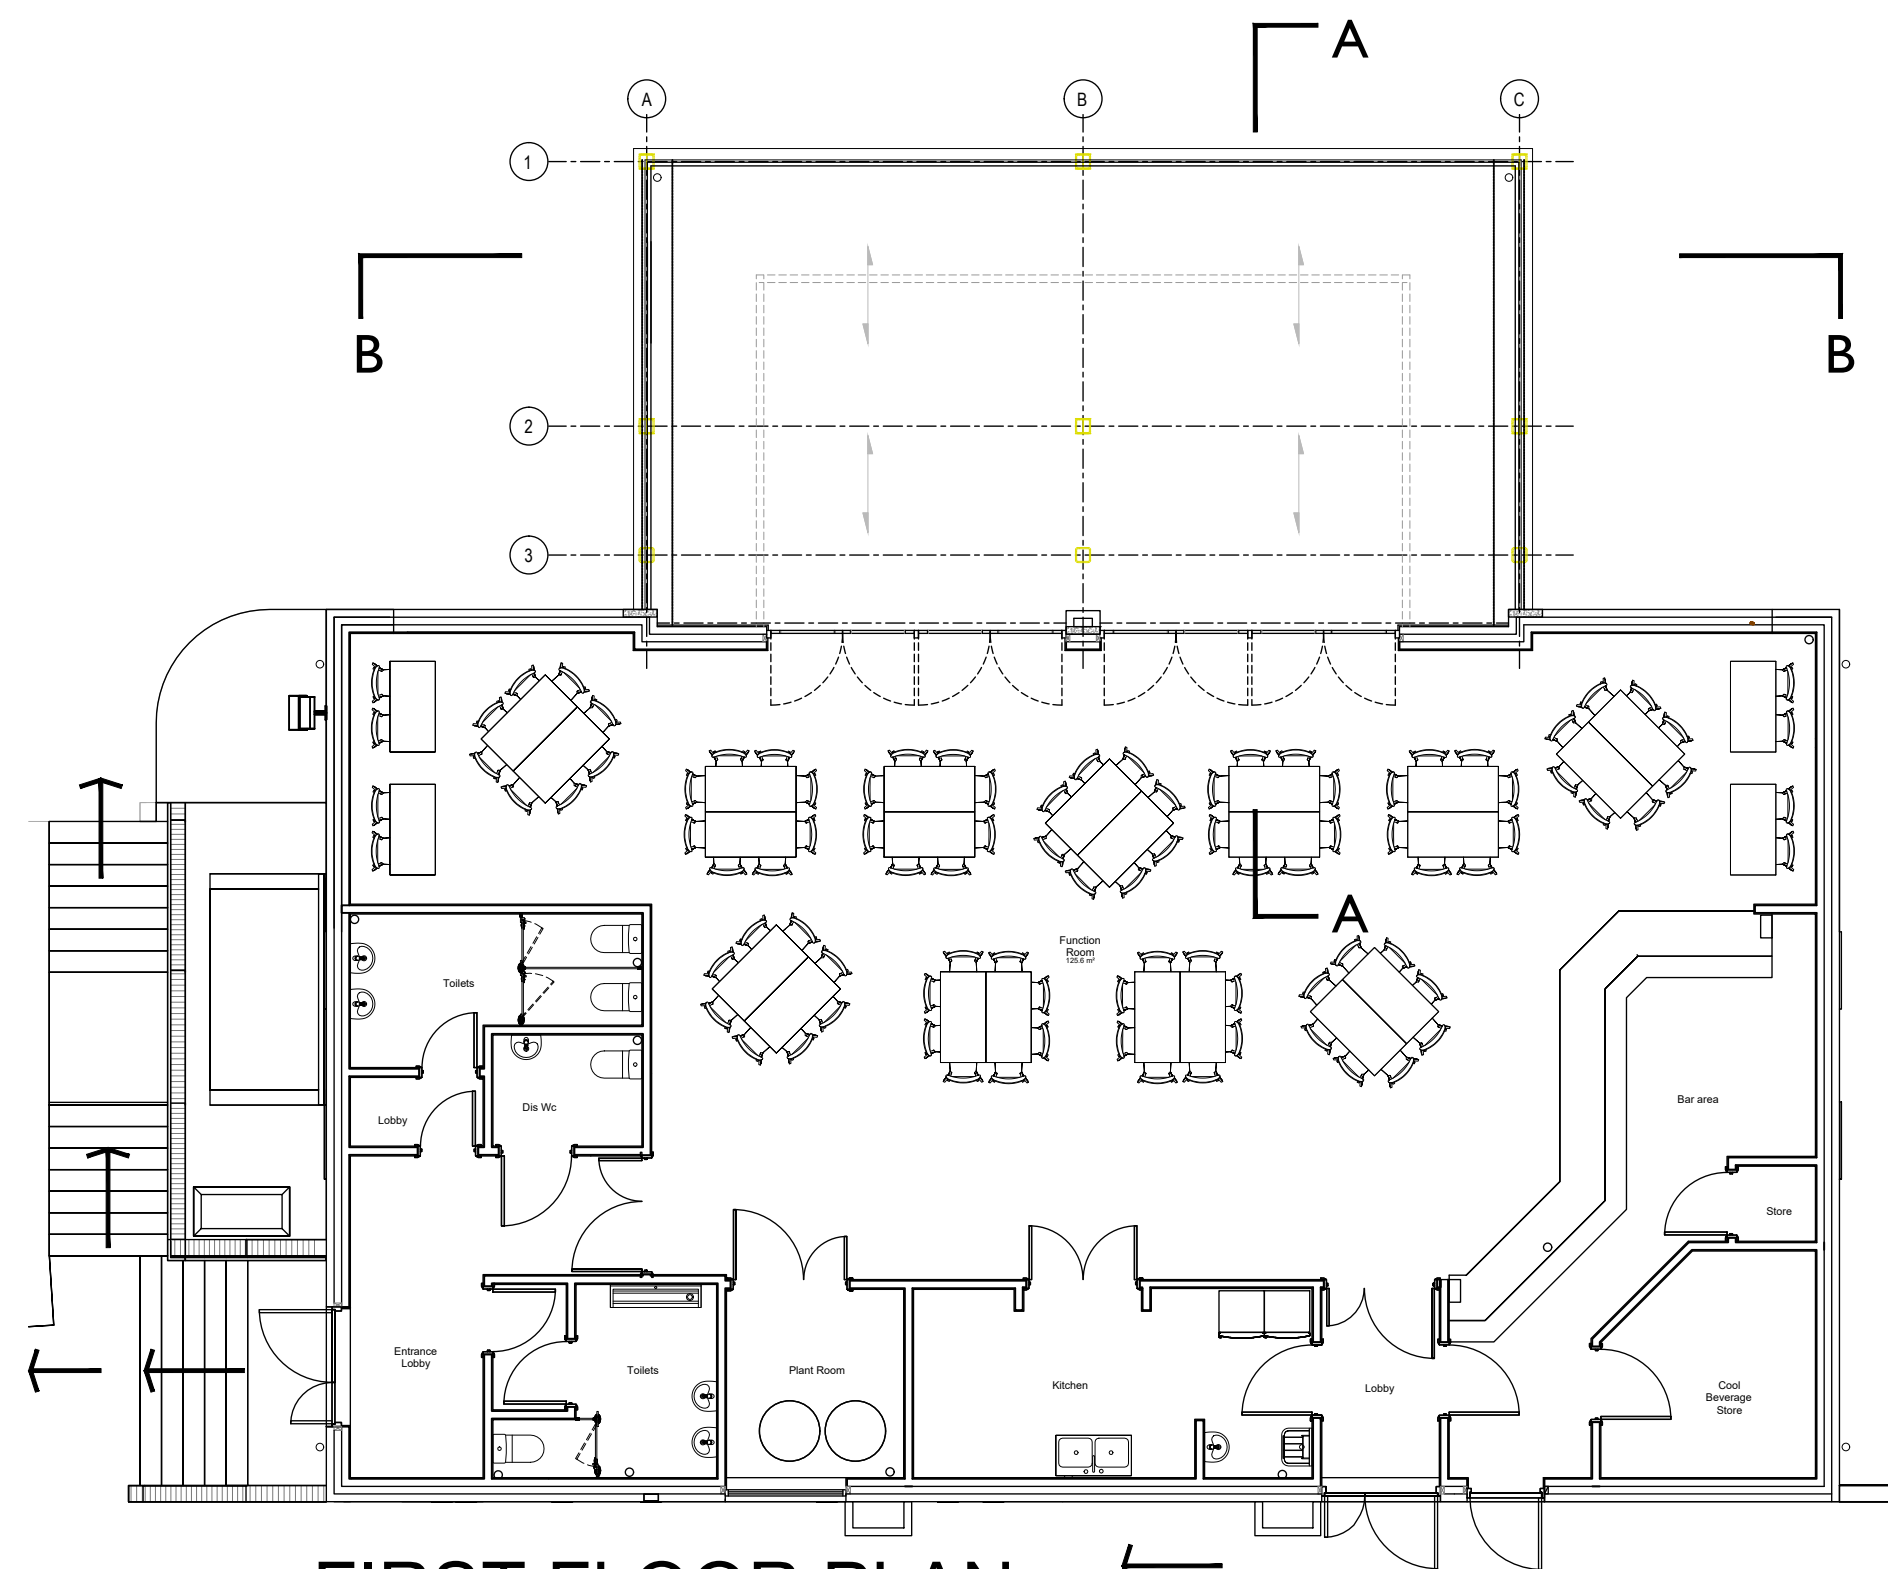

FIRST FLOOR PLAN SCALE 1:100

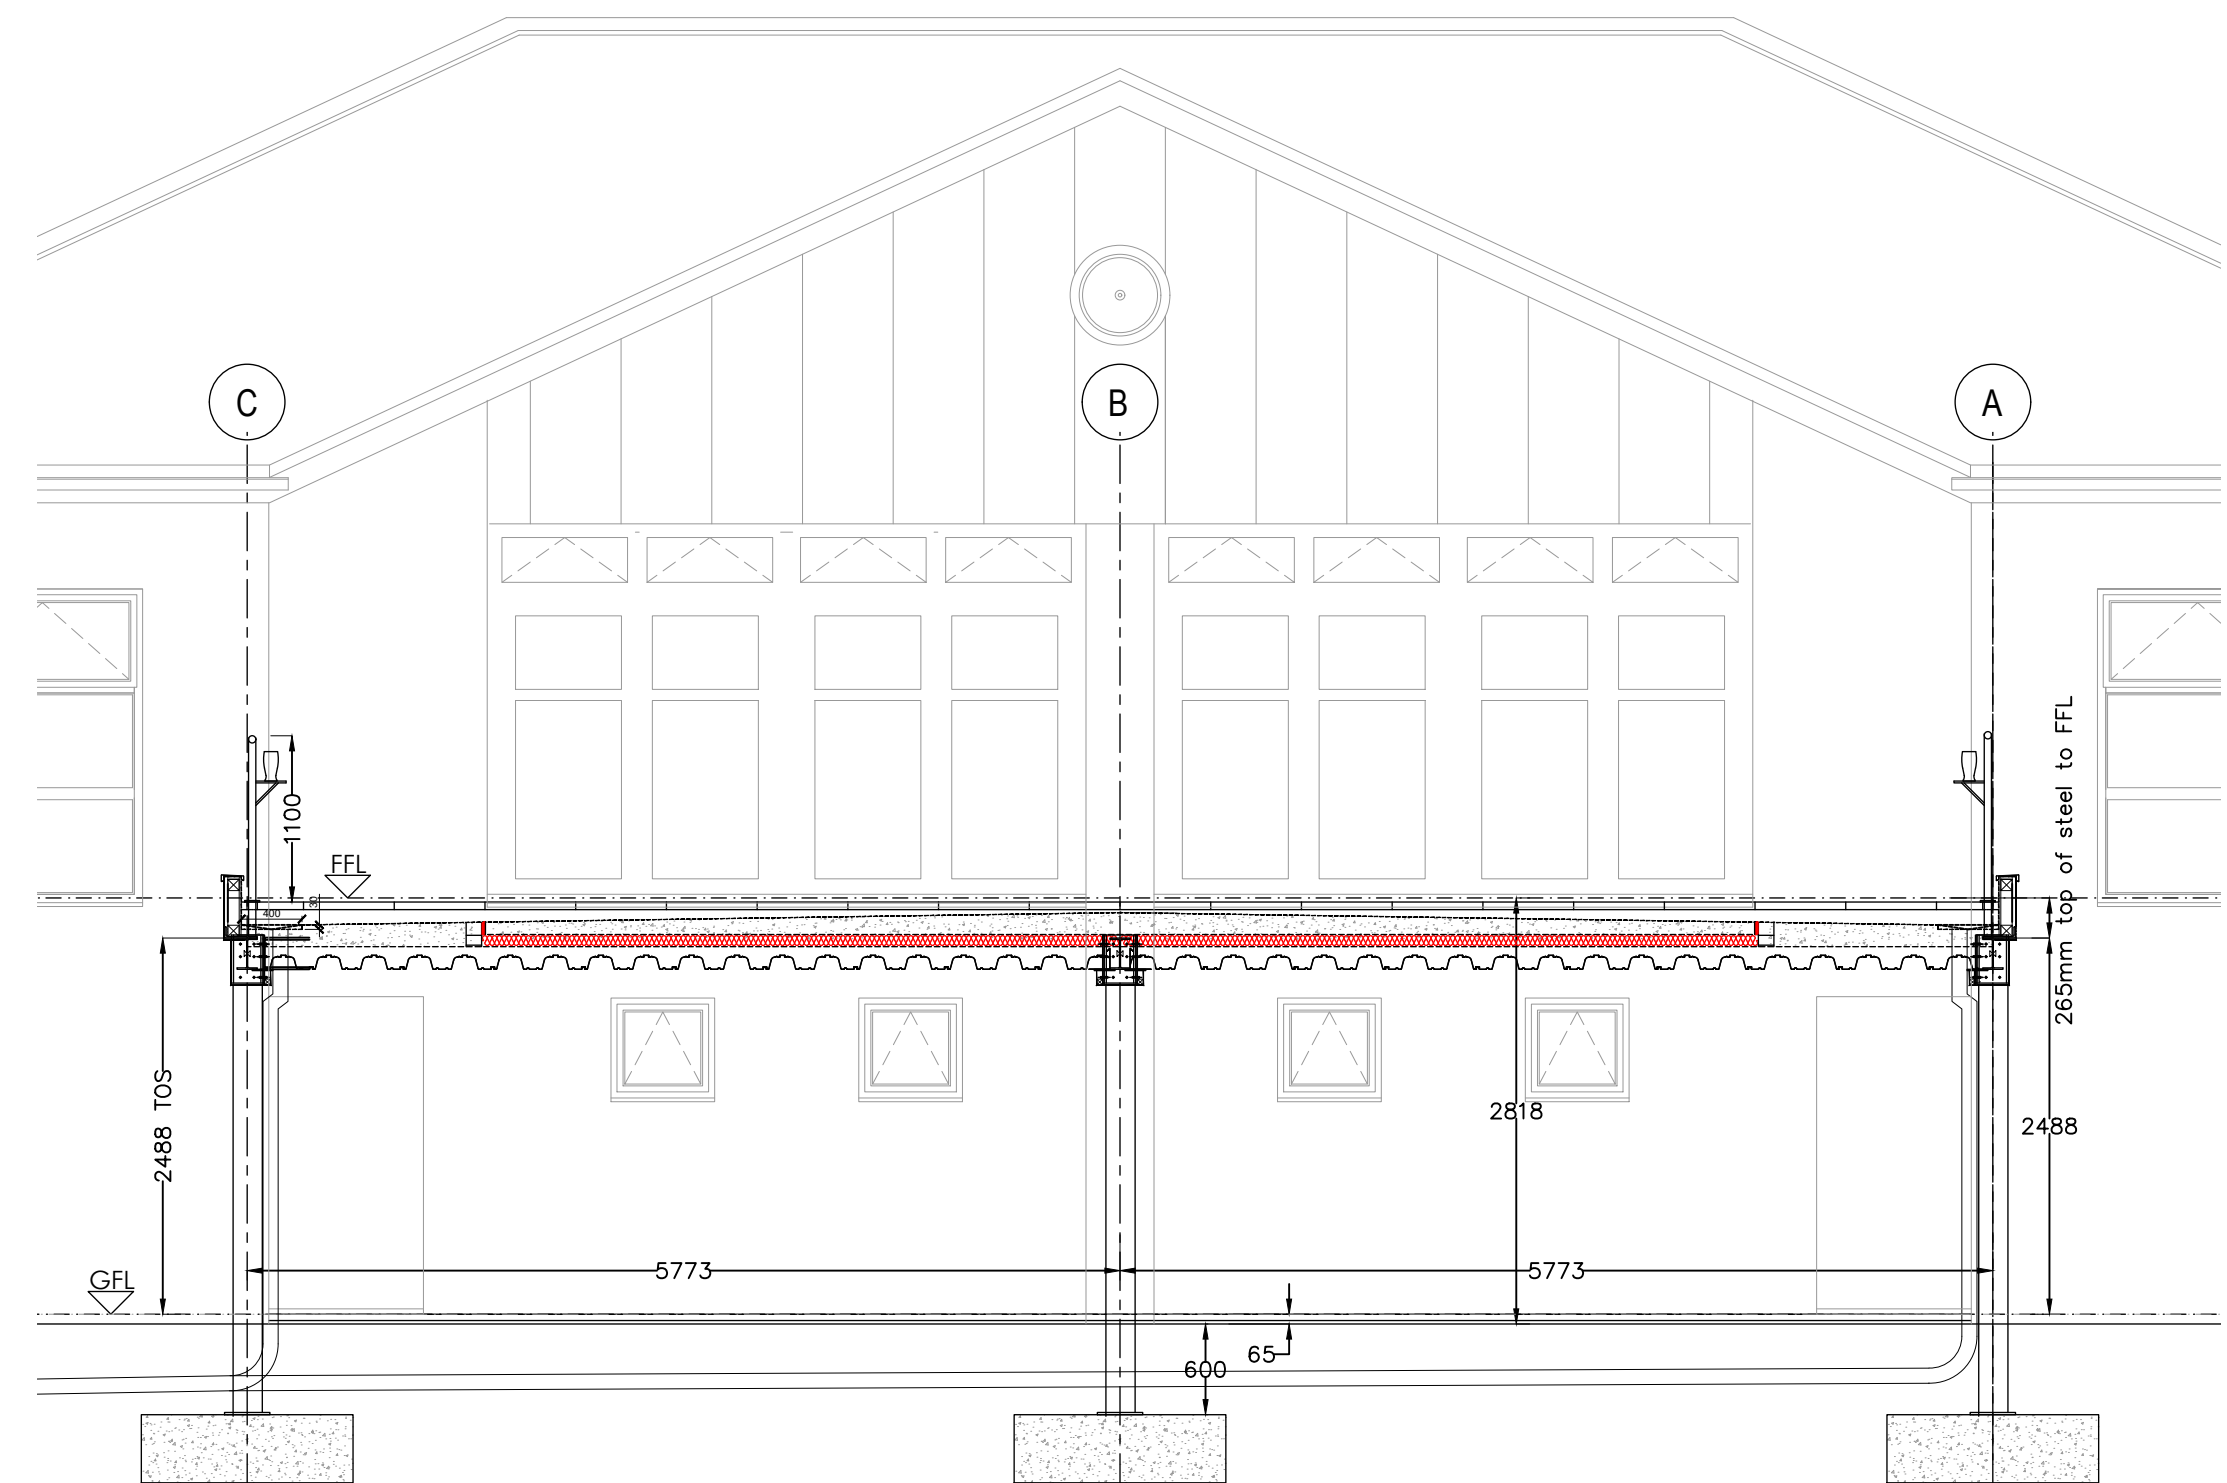


SECTION B-B SCALE 1:50

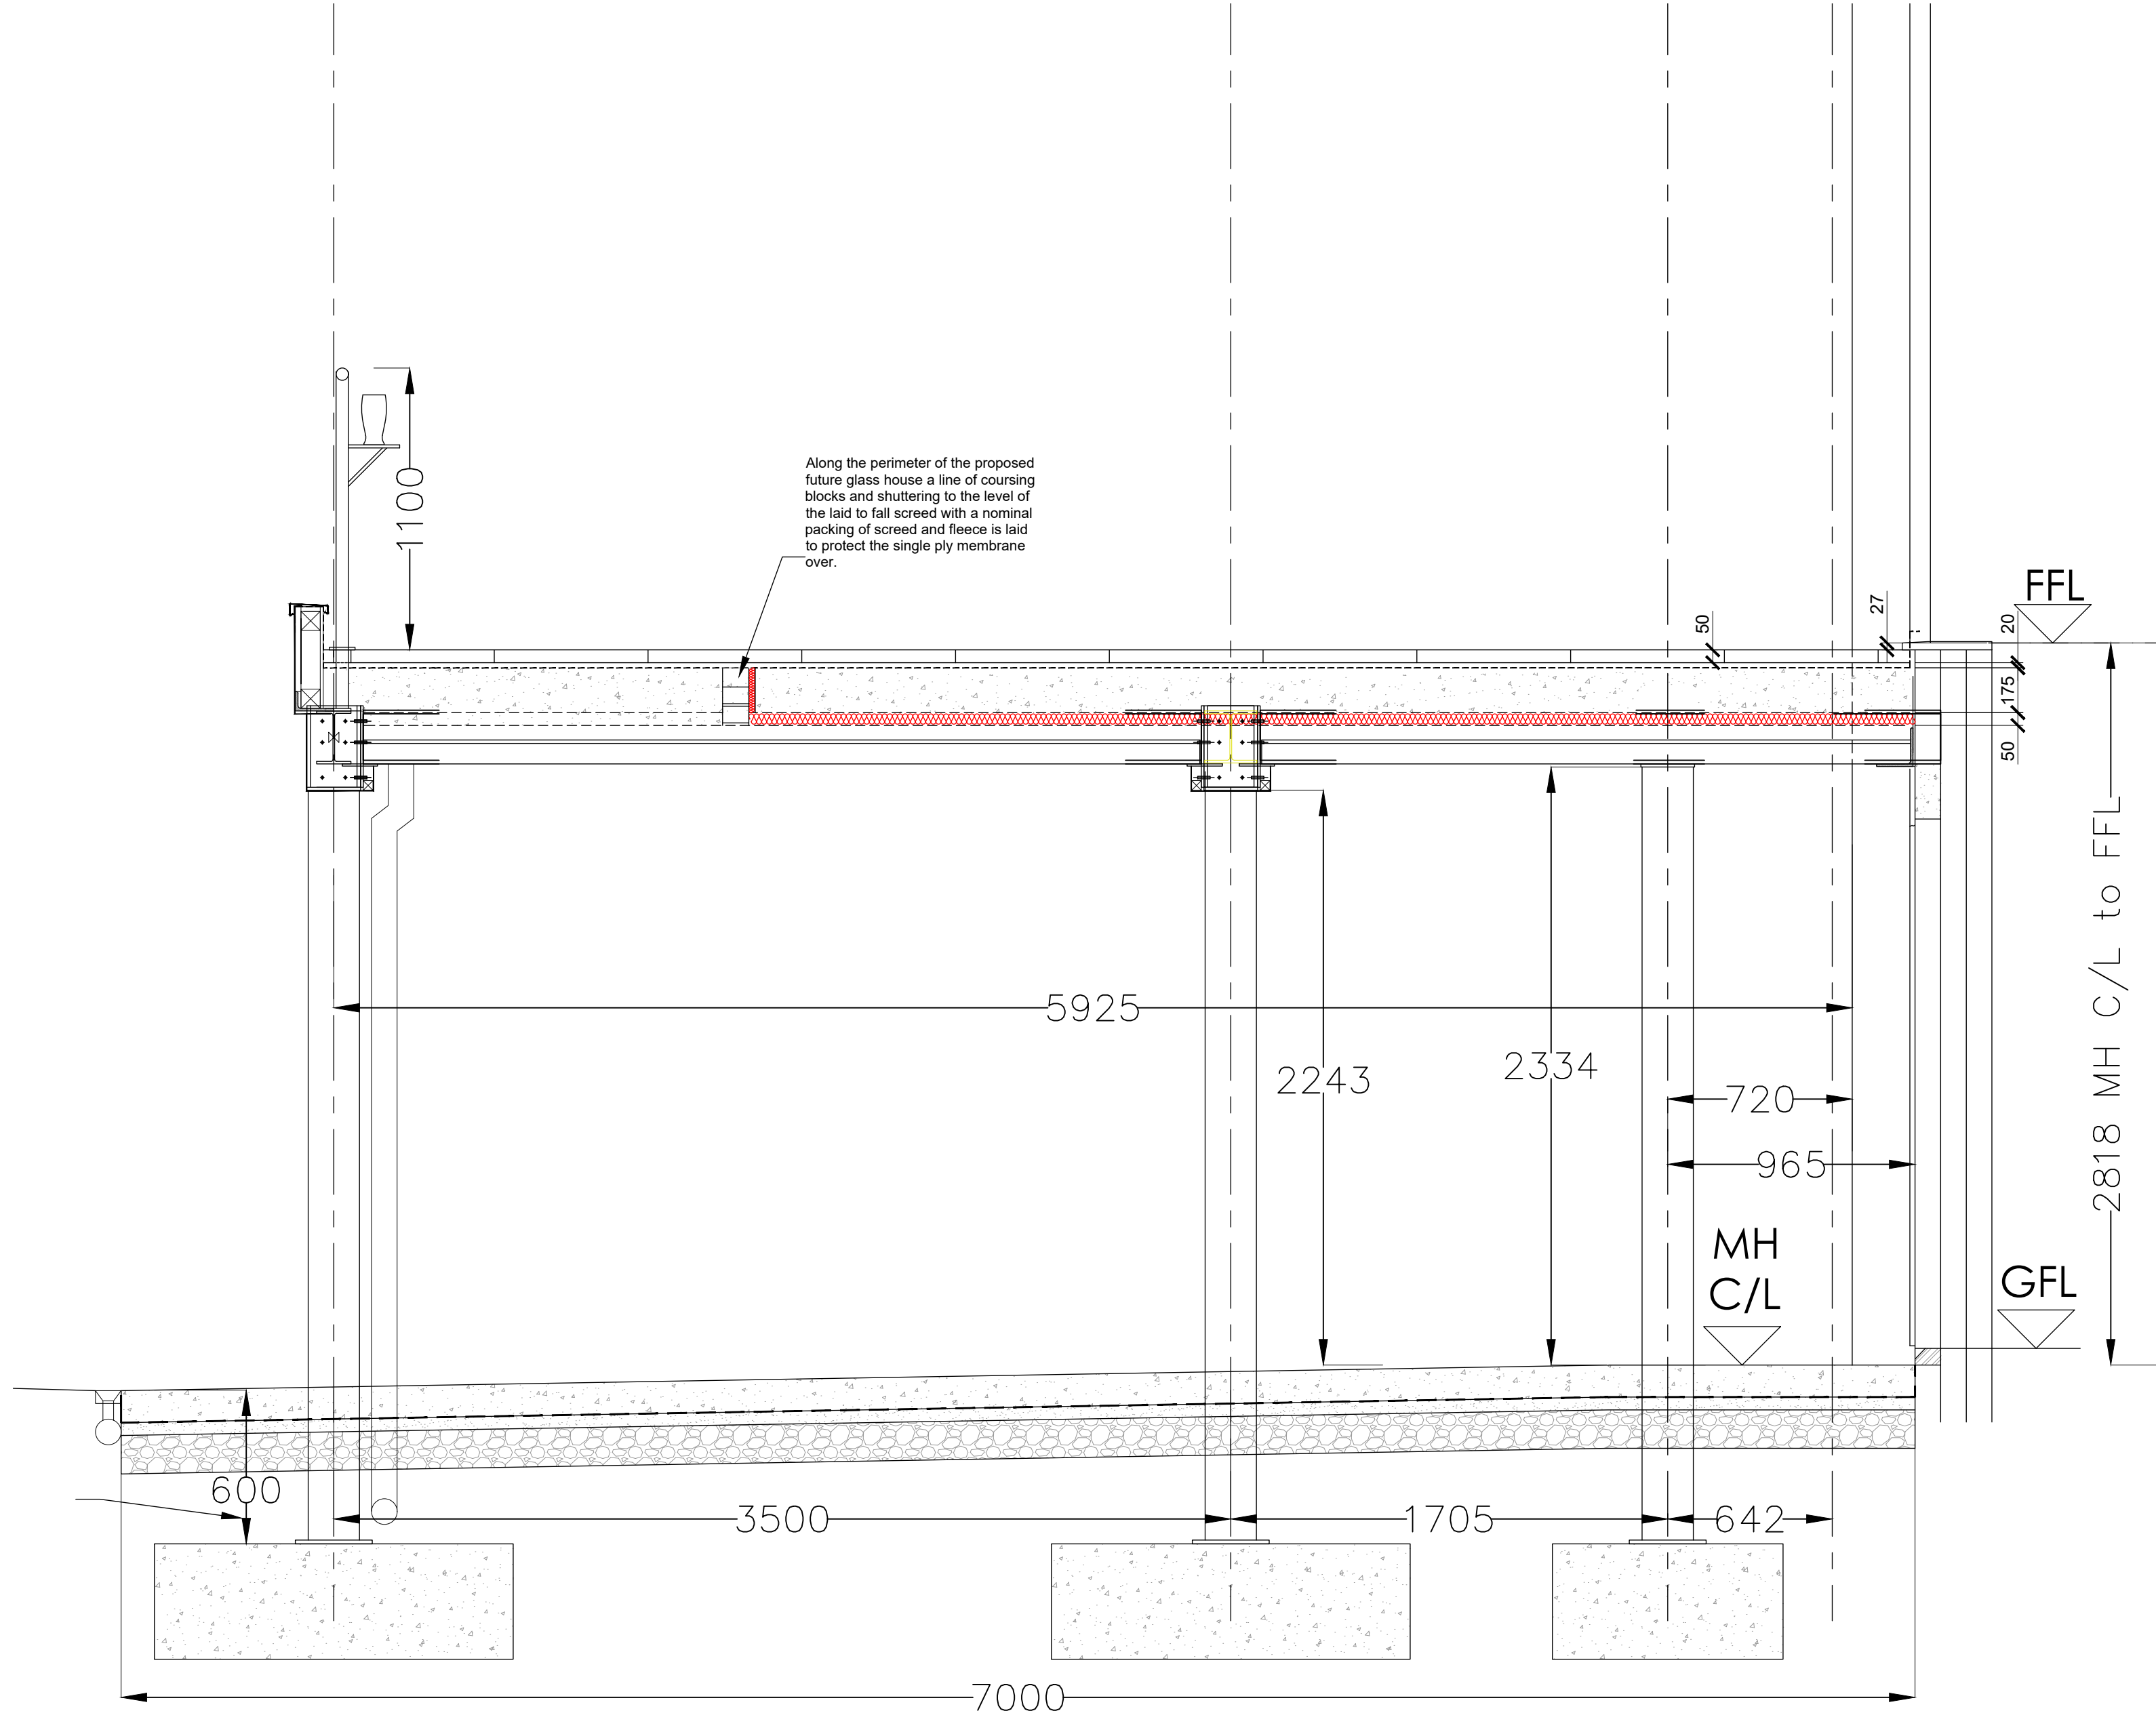

SECTION A-A SCALE 1:20

Rev	Date	Description
C	24-06-2026	Fire Officer request for 60 min steel fire protection
B	01-06-2026	Contract Drawing
A	26-05-26	Concrete patio identified as being to the extent of the stepped and ramped approaches each side

A1 Drawing Sheet

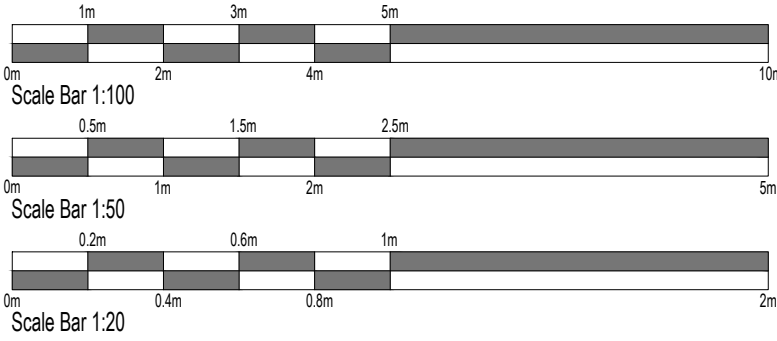

enquiries@forte-architectural.co.uk

Client:
LEEK RUGBY CLUB

Project:
Clubhouse Balcony Covered Space
Chestnut Walk,
Cheddleton, Leek,
Staffordshire ST13 7BJ

Title:
Balcony Plans As Existing
(As Constructed)

Date:
August 2026

Scale:
As Noted @ A1

Project No.
FAD-102

Drawing No.
FAD-102-P-01

Drawn:
-

Revision:
-