1

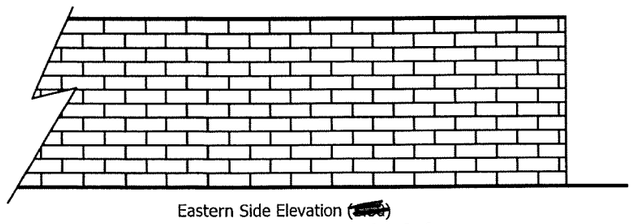

Eastern Side Elevation (~~1:100~~)
1:100

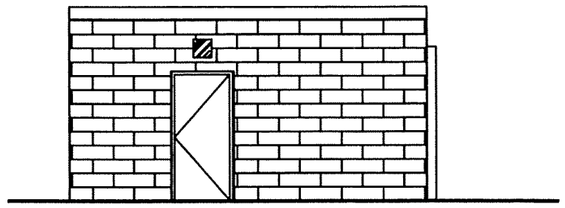

Western Side Elevation (~~1:100~~)
1:100

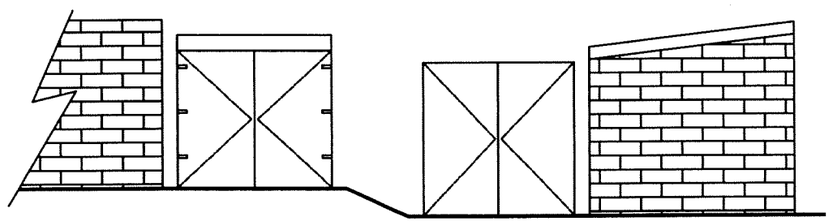

Northern Gable Elevation (~~1:100~~) 1:100

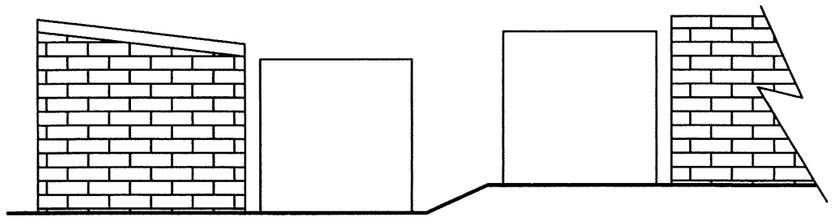

Southern Gable Elevation (~~1:100~~) 1:100

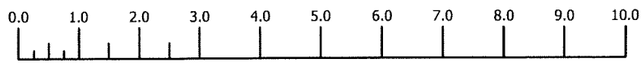

Scale Bar ~~1:100~~
1:100

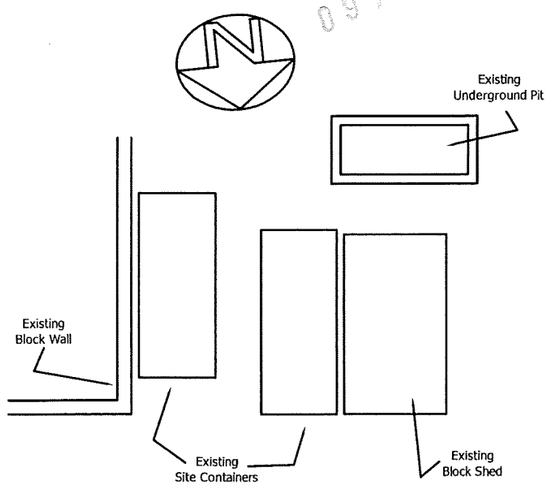

Plan View (~~1:200~~)
1:200

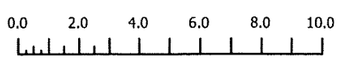

Scale Bar ~~1:200~~
1:200

Rev.	Revision Description	Drn	Chkd	Appd	Date

RICHARDSON CONSTRUCTION
8 The Crescent, Rudyard, Leek,
Staffordshire. ST13 8RW
Tel/Fax: 01538 306 239
© Copyright

Client:
Brassington & Co.
Easing Moor Farm, Thorncliffe,
Leek, Staffordshire.

Project:
Proposed Agricultural Building

Title:
Existing Plan and Elevational Views
for Local Authority reference

Drawn by:	Designed by:	Checked:
Richardson Const.	Richardson Const.	
Date: April 2009	**Index No.:**	**Approved:**
Scales: 1:50/100 @ A1		

Drawing No: RC/1855/001 — **Revision**

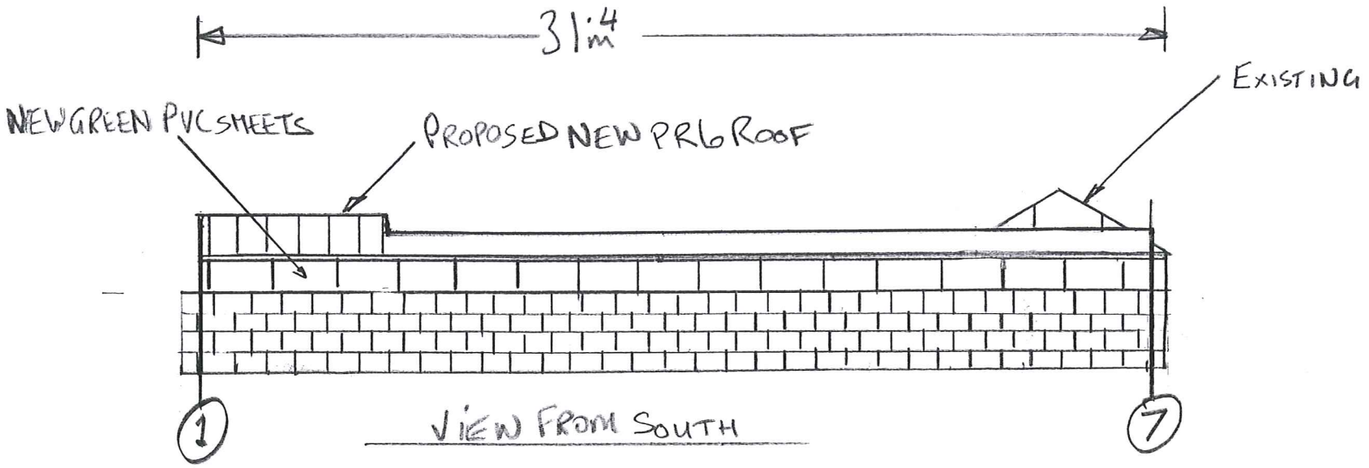

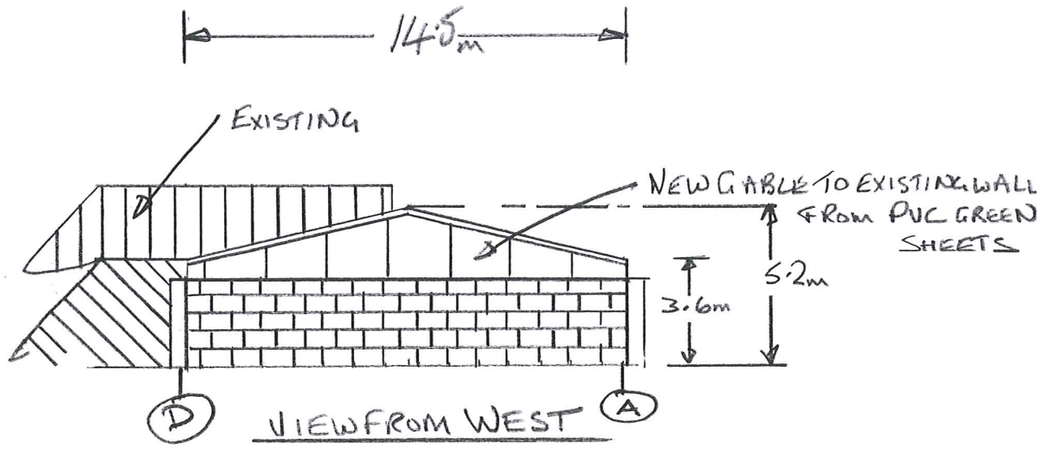

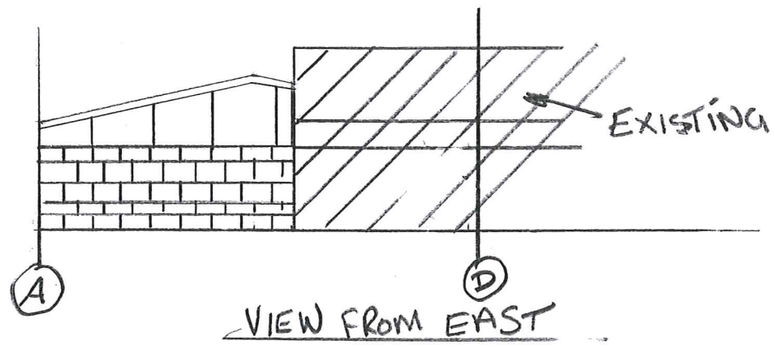

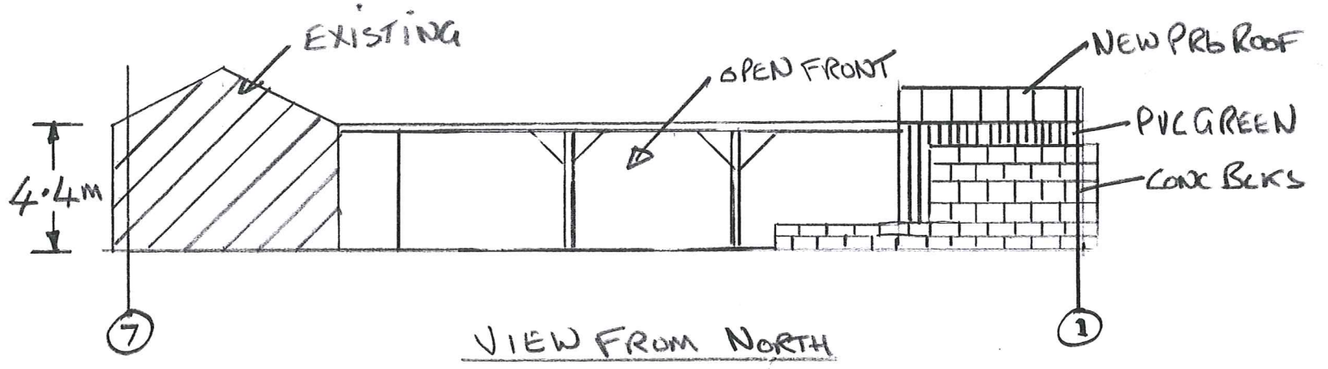

BUILDING SPECIFICATION

Roof Sheeting:
Profile 6 reinforced 'Anthracite' (Slate Grey) Farmscape Fibre Cement Sheets incorparating close fitting crown sheets

Vertical Cladding:
BS.18-B-25 Merlin Grey plastic coated box profile steel sheeting as shown

Rainwater Goods:
Black 160mm nominal half round PVC guttering complete with necessary 110mm diameter Black PVC rainwater pipes

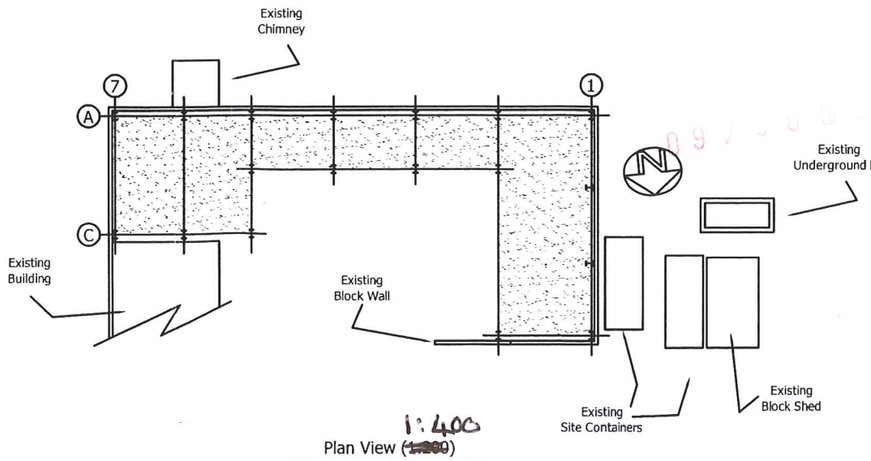

PROPOSED AGRICULTURAL BUILDING
BRASSINGTON & CO
EASING MOOR FARM
THORNCLIFFE LEEK APRIL 2009

2

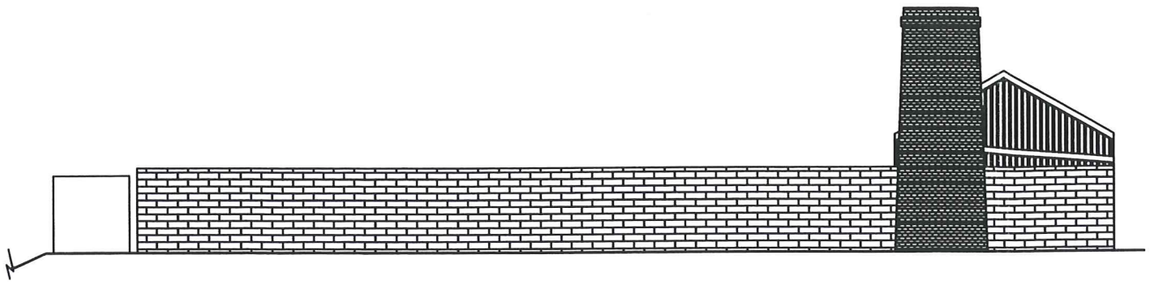

Southern Elevation (~~1:100~~)
1:200

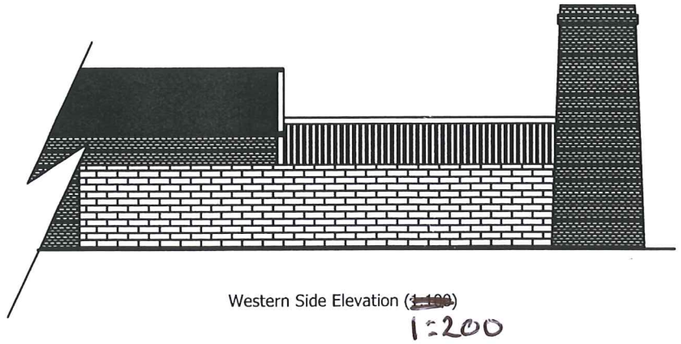

Western Side Elevation (~~1:100~~)
1:200

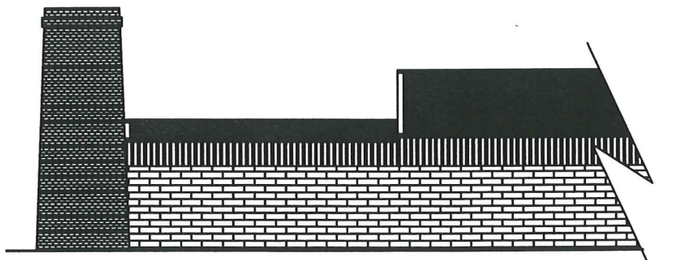

Eastern Elevation (~~1:100~~)
1:200

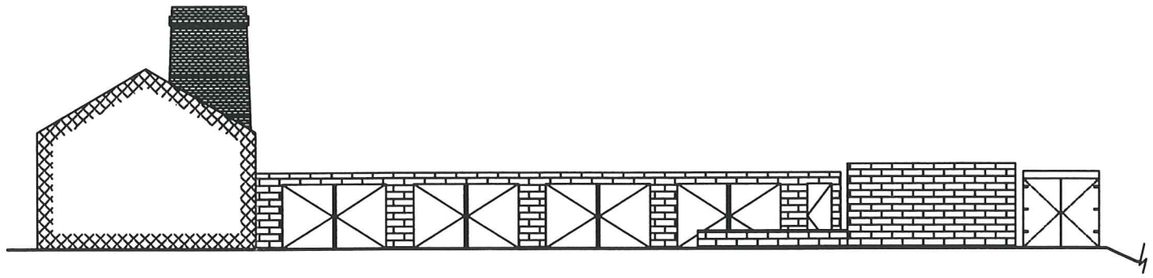

Northern Elevation (~~1:100~~)
1:200

0.0 1.0 2.0 3.0 4.0 5.0 6.0 7.0 8.0 9.0 10.0

Scale Bar ~~1:100~~
1:200

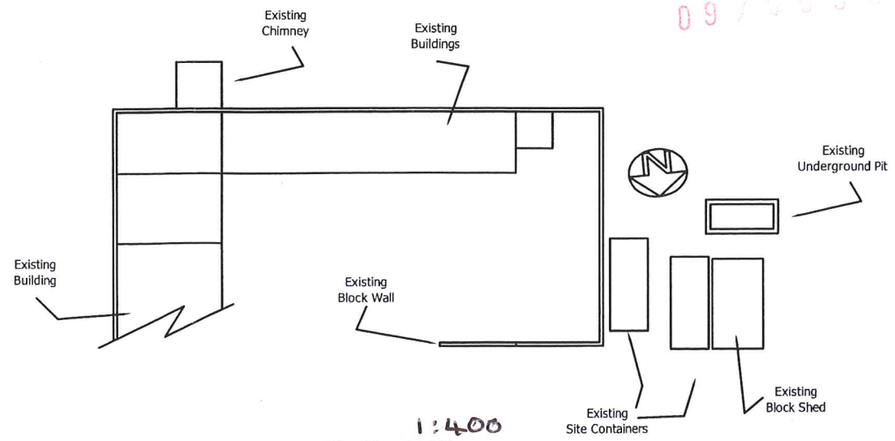

1:400
Plan View (~~1:200~~)
(shaded denotes new build)

0.0 2.0 4.0 6.0 8.0 10.0

Scale Bar ~~1:200~~
1:400

09/0057/FUL
- 7 MAY 2009

Rev.	Revision Description	Drn	Chkd	Appd	Date

RICHARDSON CONSTRUCTION
8 The Crescent, Rudyard, Leek,
Staffordshire. ST13 8RW
Tel/Fax: 01538 306 239
© Copyright

Client:
Brassington & Co.
Easing Moor Farm, Thorncliffe,
Leek, Staffordshire.

Project:
Proposed Agricultural Building

Title:
Existing Plan and Elevational Views
for Local Authority reference

Drawn by:	Designed by:	Checked:
Richardson Const.	Richardson Const.	
Date: April 2009	**Index No.:**	**Approved:**
Scales: ~~1:100/200~~ @ A1	1:200 1:400	
Drawing No: RC/1856/001		**Revision**

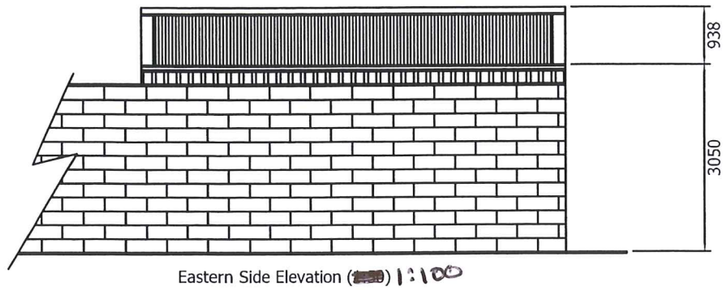

Eastern Side Elevation ([redacted]) 1:100

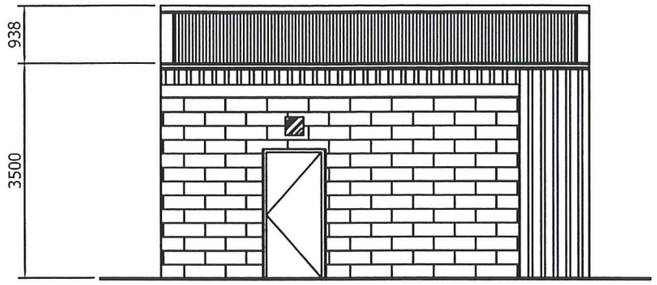

Western Side Elevation ([redacted])
1:100

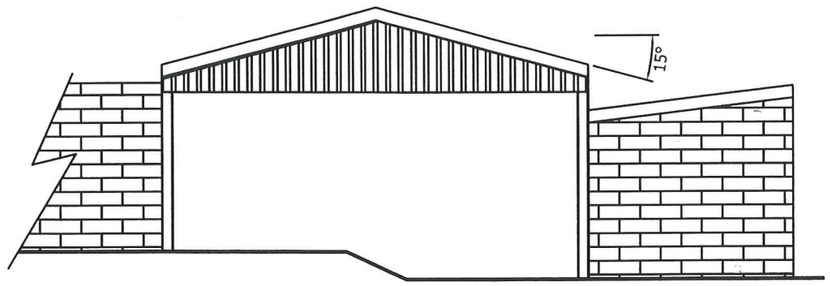

Northern Gable Elevation ([redacted]) 1:100

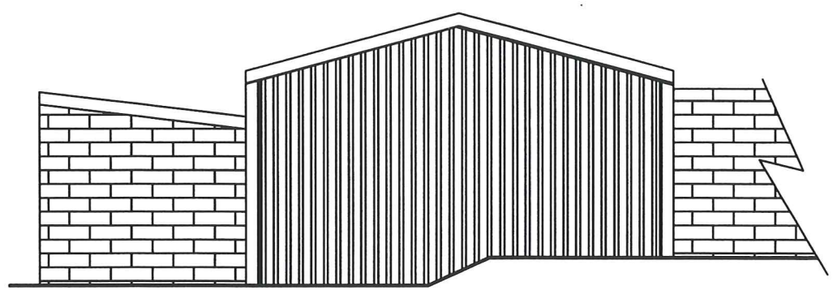

Southern Gable Elevation ([redacted]) 1:100

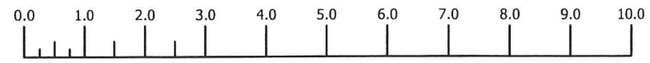

Scale Bar ~~1:50~~
1:100

BUILDING SPECIFICATION

Roof Sheeting:
Profile 6 reinforced 'Anthracite' (Slate Grey) Farmscape Fibre Cement Sheets incorparating close fitting crown sheets

Vertical Cladding:
BS.18-B-25 Merlin Grey plastic coated box profile steel sheeting to each side elevation and each gable end as shown

Rainwater Goods:
Black 160mm nominal half round PVC guttering complete with a 110mm diameter Black PVC rainwater pipe to each side

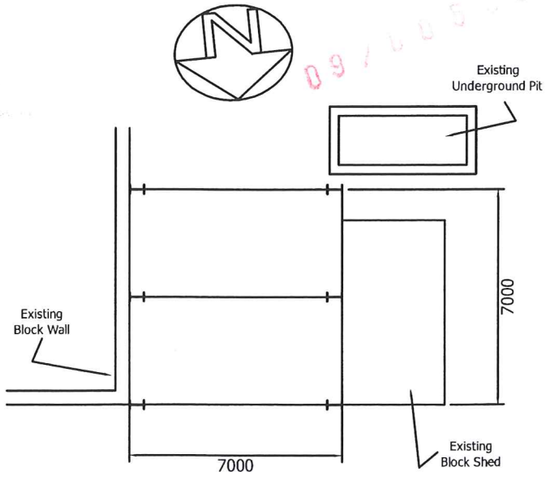

Plan View ([redacted])
1:200

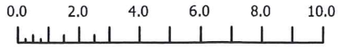

Scale Bar ~~1:100~~
1:200

Rev.	Revision Description	Drn	Chkd	Appd	Date

RICHARDSON CONSTRUCTION
8 The Crescent, Rudyard, Leek,
Staffordshire. ST13 8RW
Tel/Fax: 01538 306 239
© Copyright

Client:
Brassington & Co.
Easing Moor Farm, Thorncliffe,
Leek, Staffordshire.

Project:
Proposed Agricultural Building

Title:
Proposed Plan and Elevational Views for Local Authority reference

Drawn by: Richardson Const.	Designed by: Richardson Const.	Checked:
Date: April 2009	Index No.:	Approved:
Scales: ~~1:50/100~~ @ A1 1:100 1:200		
Drawing No: RC/1855/002		Revision