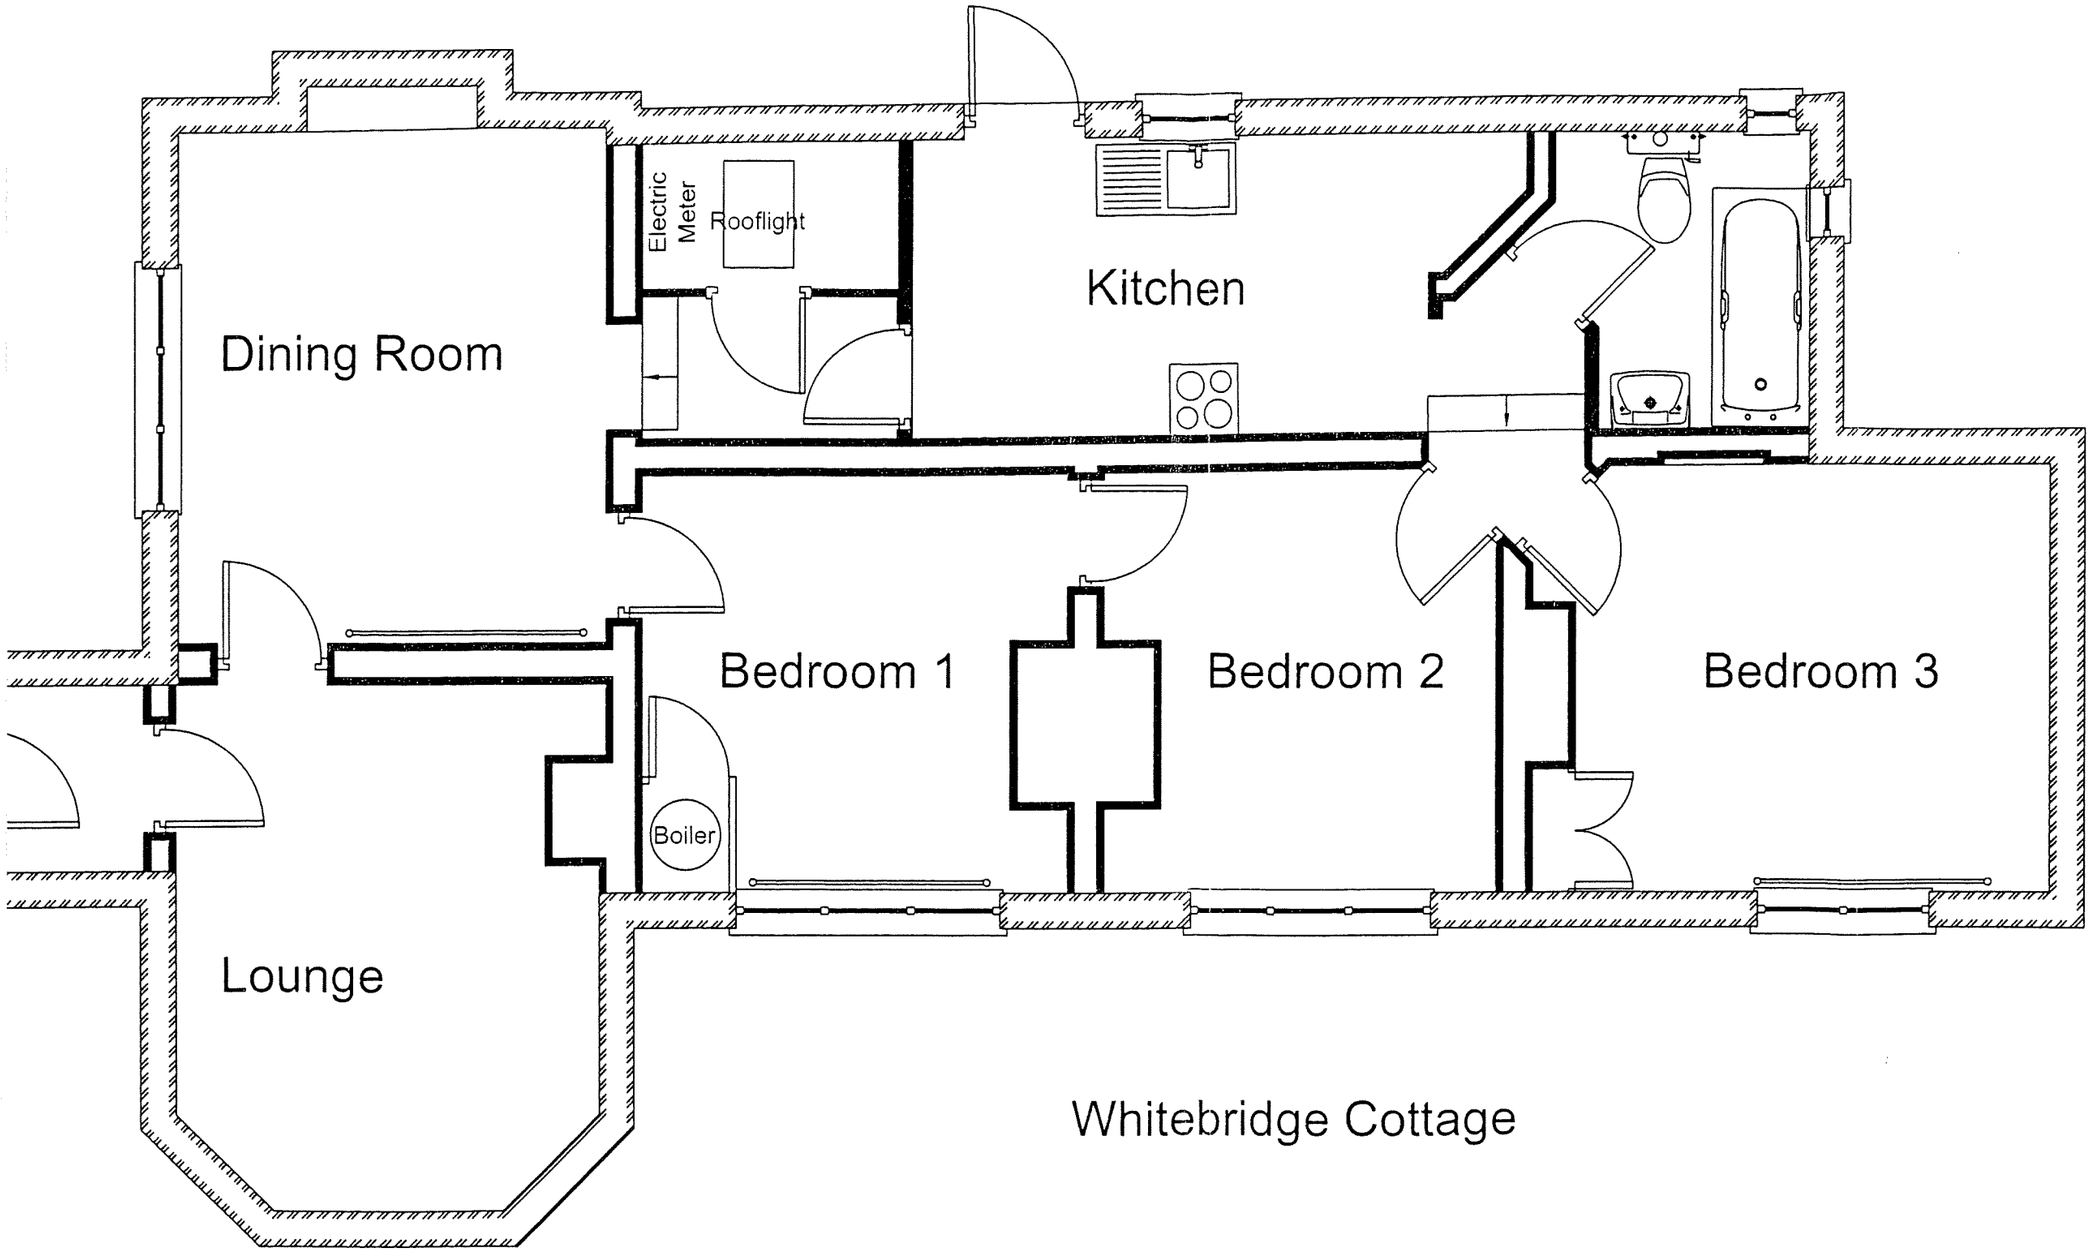


Notes

Where dimensions are not given, drawings must not be scaled and the matter referred to Lambert Smith Hampton.

In the event of any dimensional conflict between Lambert Smith Hampton Drawings, the matter must be referred to Lambert Smith Hampton for clarification.

The Contractor must also refer to any separate Lambert Smith Hampton Specification to be read in conjunction with this drawing.

This Drawing is only for the use identified. Do not build from this drawing unless marked 'For Construction'.

~~PLANNING~~

~~BUILDING REGULATIONS~~

~~TENDER DOCUMENT~~

~~FOR CONSTRUCTION~~

AS BUILT

Revisions

Lambert Smith Hampton

Property Solutions

Birmingham Building Consultancy
Interchange Place
Edmund Street
Birmingham B3 2TA
Telephone: 0121 236 2066
Fax: 0121 233 1623
www.lsh.co.uk

Client

BRB (Residuary) Ltd

Project

Whitebridge Crossing Cottage

Drawing

Identification Layout Plan

Job No.	Dwg No.		
F0055	001		
Scale	Date	Drawn	Checked
NTS	08/10/08	CAT	DJO