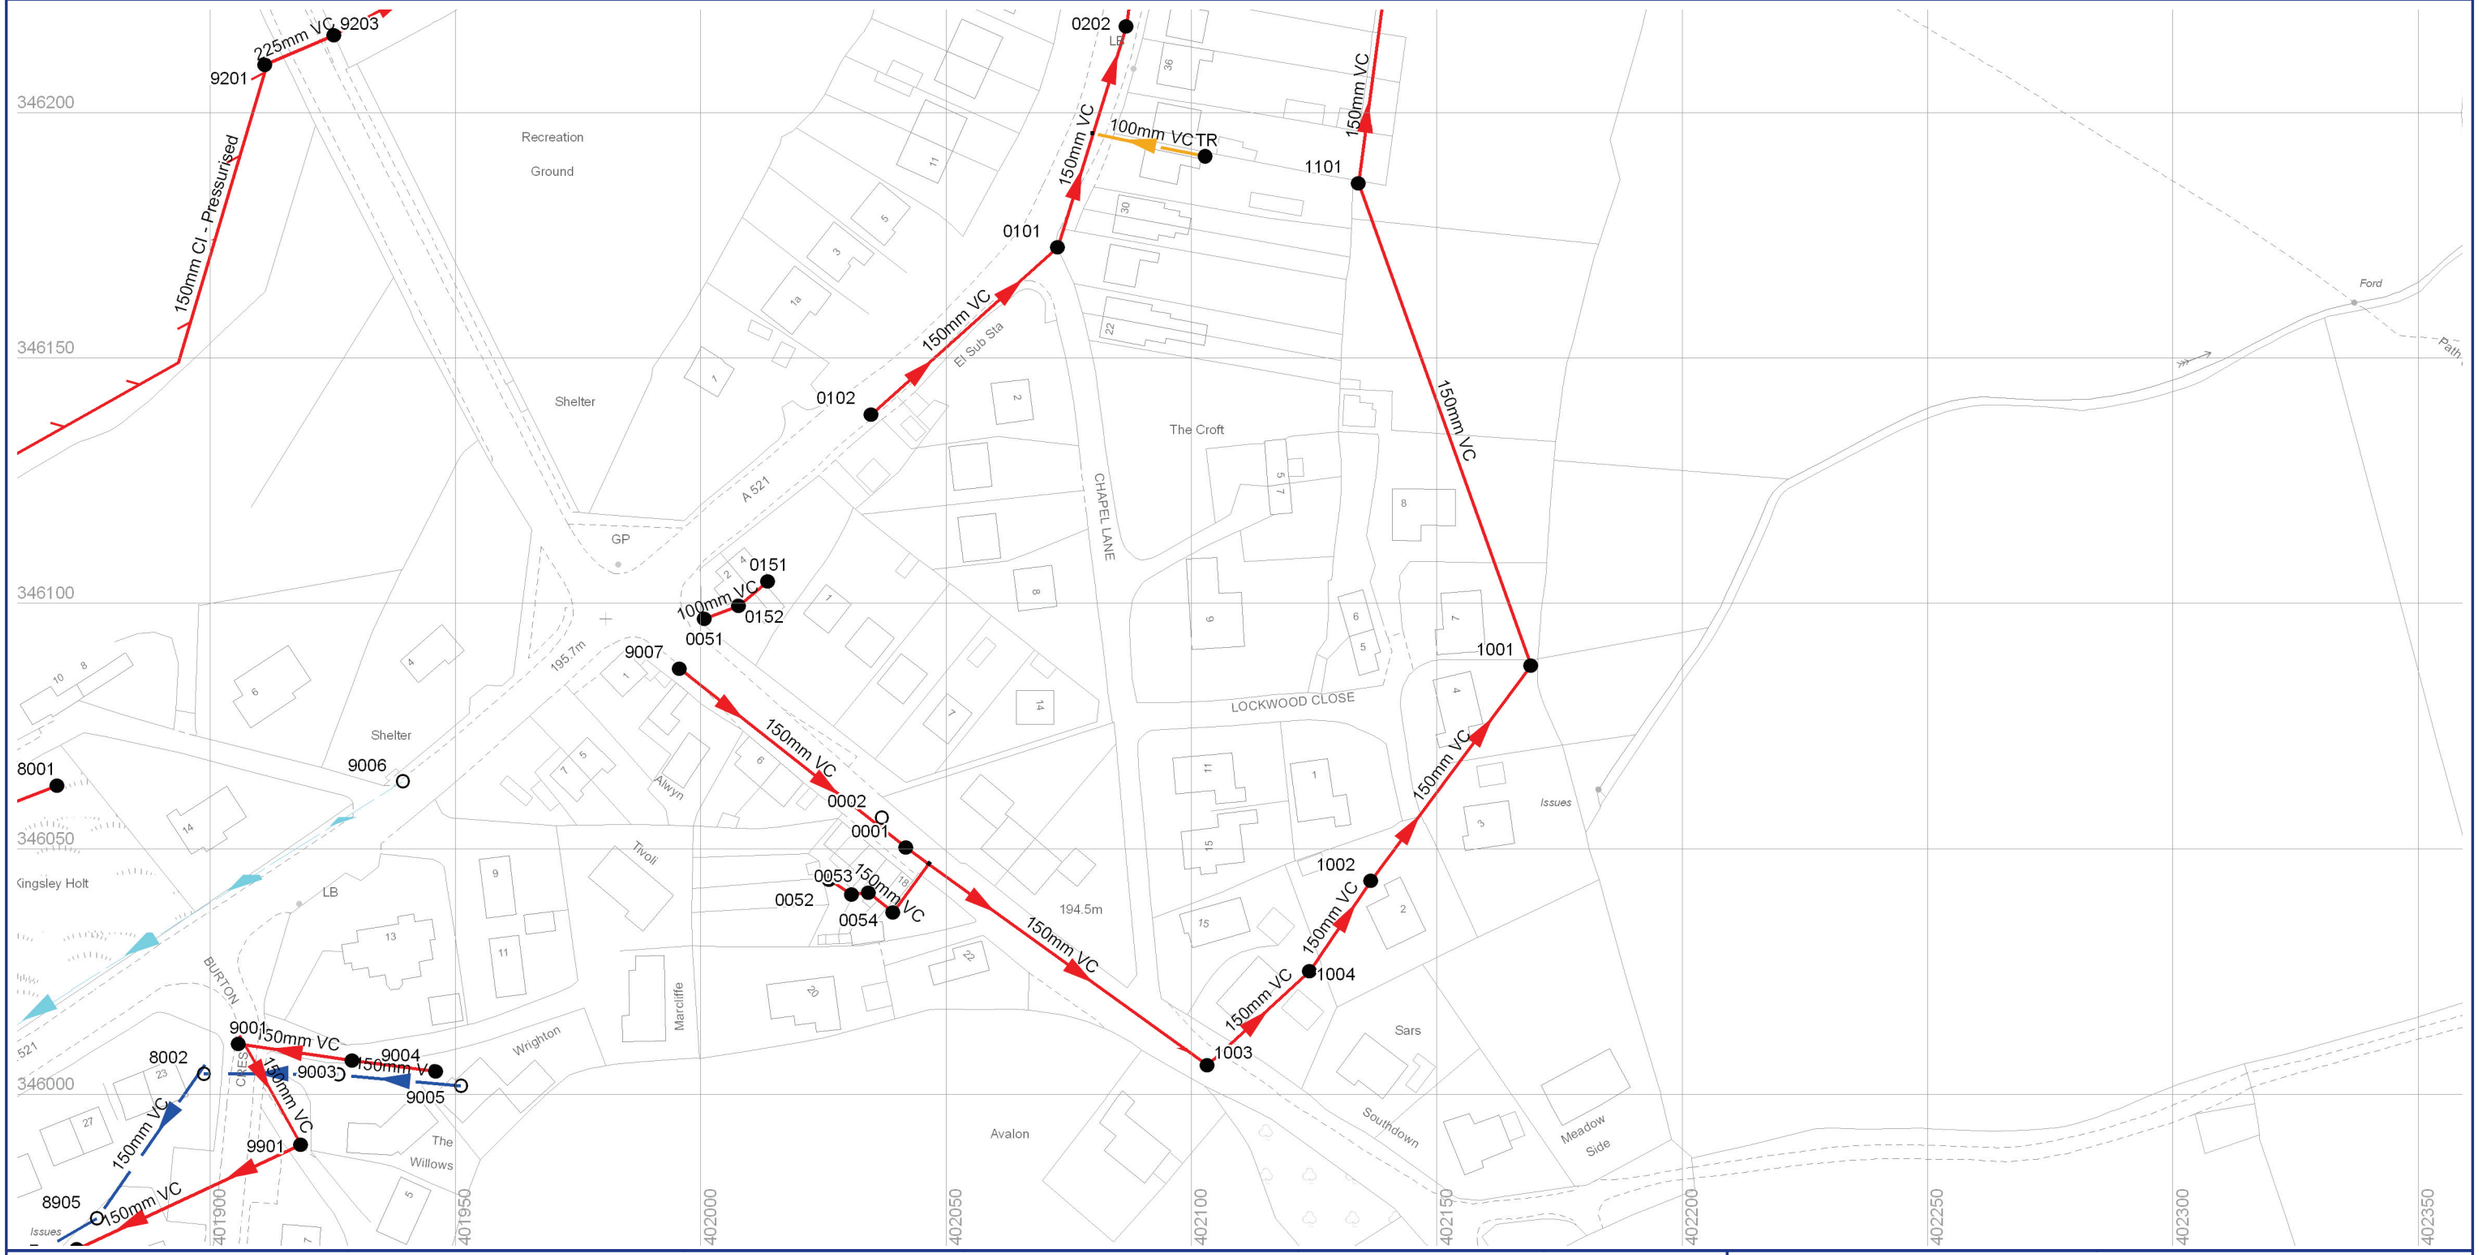

- Abandoned Gravity Sewer
- Private Combined Gravity Sewer
- Private Foul Gravity Sewer
- Private Surface Water Gravity Sewer
- Public Combined Gravity Sewer
- Public Foul Gravity Sewer
- Public Surface Water Gravity Sewer
- Trunk Combined Gravity Sewer
- Trunk Foul Use Gravity Sewer
- Trunk Surface Water Gravity Sewer
- Combined Use Pressurised Sewer
- Foul Use Pressurised Sewer
- Surface Water Pressurised Sewer
- Highway Drain
- Combined Lateral Drain (SS)
- Foul Lateral Drain (SS)
- Surface Water Lateral Drain (SS)

All Private Sewers are shown in magenta
All section 104 sewers are shown in green
All Sewers that have been transferred to Severn Trent Water after the 1st October 2011, but have not been surveyed and confirmed by Severn Trent Water are shown in orange

- Culverted Watercourse
- Cable, Earthing
- Cable Junction
- Cable, Optical Fibre/Instrumentation
- Cable, Low Voltage
- Cable, High Voltage
- Cable, Other
- Housing, Building
- Housing, Kiosk
- Disposal Site
- Sewage Treatment Works
- Housing, Other
- Pipe Support Structure
- Sewage Pumping Facility
- Sewer Facility Connection Inlet / Outlet

- Blind Shaft
- Combined Use Manhole
- Flushing Chamber
- Foul Use Manhole
- Grease Trap
- Head Node
- Hydrobrake
- Lamphole
- Outfall
- Overflow
- Penstock
- Petrol Interceptor

- Sewer Chemical Injection Point
- Sewer Junction
- Sewerage Air Valve
- Sewerage Hatch Box Point
- Sewerage Isolation Valve
- Soakaway
- Surface Water Manhole
- Vent Column
- Waste Water Storage
- Pre-1937 Properties

MATERIALS

- - NONE
- AC - ASBESTOS CEMENT
- BR - BRICK
- CC - CONCRETE BOX CULVERT
- CI - CAST IRON
- CO - CONCRETE
- CSB - CONCRETE SEGMENTS (BOLTED)
- CSU - CONCRETE SEGMENTS (UNBOLTED)
- DI - DUCTILE IRON
- GRC - GLASS REINFORCED CONCRETE
- GRP - GLASS REINFORCED PLASTIC
- MAC - MASONRY IN REGULAR COURSES
- MAR - MASONRY RANDOMLY COURSED
- PE - POLYETHLENE
- PF - PITCH
- PP - POLYPROPYLENE
- PSC - PLASTIC STEEL COMPOSITE
- PVC - POLYVINYL CHLORIDE
- RPM - REINFORCED PLASTIC MATRIX
- SI - SPUN (GREY) IRON
- ST - STEEL
- U - UNKNOWN
- VC - VITRIFIED CLAY
- XXX - OTHER

SHAPE

- C - CIRCULAR
- E - EGG SHAPED
- O - OTHER
- R - RECTANGLE
- S - SQUARE
- T - TRAPEZOIDAL
- U - UNKNOWN

PURPOSE

- C - COMBINED
- E - FINAL EFFLUENT
- F - FOUL
- L - SLUDGE
- S - SURFACE WATER

CATEGORIES

- W - WEIR
- C - CASCADE
- DB - DAMBOARD
- SE - SIDE ENTRY
- FV - FLAP VALVE
- BD - BACK DROP
- S - SIPHON
- HD - HIGHWAY DRAIN
- S104 - SECTION 104

N
W E
S

SEVERN TRENT WATER

Severn Trent Water Limited
Asset Data Management
PO Box 5344
Coventry
CV3 9FT
Telephone: 0845 601 6616

SEWER RECORD

O/S Map scale: 1:1250

Date of issue: 12.01.16

This map is centred upon:
O / S Grid reference:

x : 402110

y : 346095

Disclaimer Statement:

1. Do not scale off this Map.

2. This map and any information supplied with it is furnished as a general guide, is only valid at the date of issue and no warranty as to its correctness is given or implied. In particular this Map and any information shown on it must not be relied upon in the event of any development or works (including but not limited to excavations) in the vicinity of Severn Trent Water's assets or for the purposes of determining the suitability of a point of connection to the sewerage or distribution systems.

3. On **1 October 2011** most private sewers and private lateral drains in Severn Trent Water's sewerage area, which were connected to a public sewer as at 1 July 2011, transferred to the ownership of Severn Trent Water and became public sewers and public lateral drains. A further transfer takes place on 1 October 2012 (date to be confirmed).
Private pumping stations, which form part of these sewers or lateral drains, will transfer to the ownership of Severn Trent Water on or before 1 October 2016.
Severn Trent Water does not possess complete records of these assets.
These assets may not be displayed on this Map.

4. Reproduction by permission of Ordnance Survey on behalf of HMSO. © Crown Copyright and database right 2004. All rights reserved. Ordnance Survey licence number **100018202**. Document users other than Severn Trent Water business users are advised that this document is provided for reference purpose only and is subject to copyright, therefore, no further copies should be made from it.