345140mN

345120mN

345100mN

345080mN

345060mN

345040mN

407220mE

407240mE

407260mE

407280mE

407300mE

407320mE

407340mE

INDICATIVE

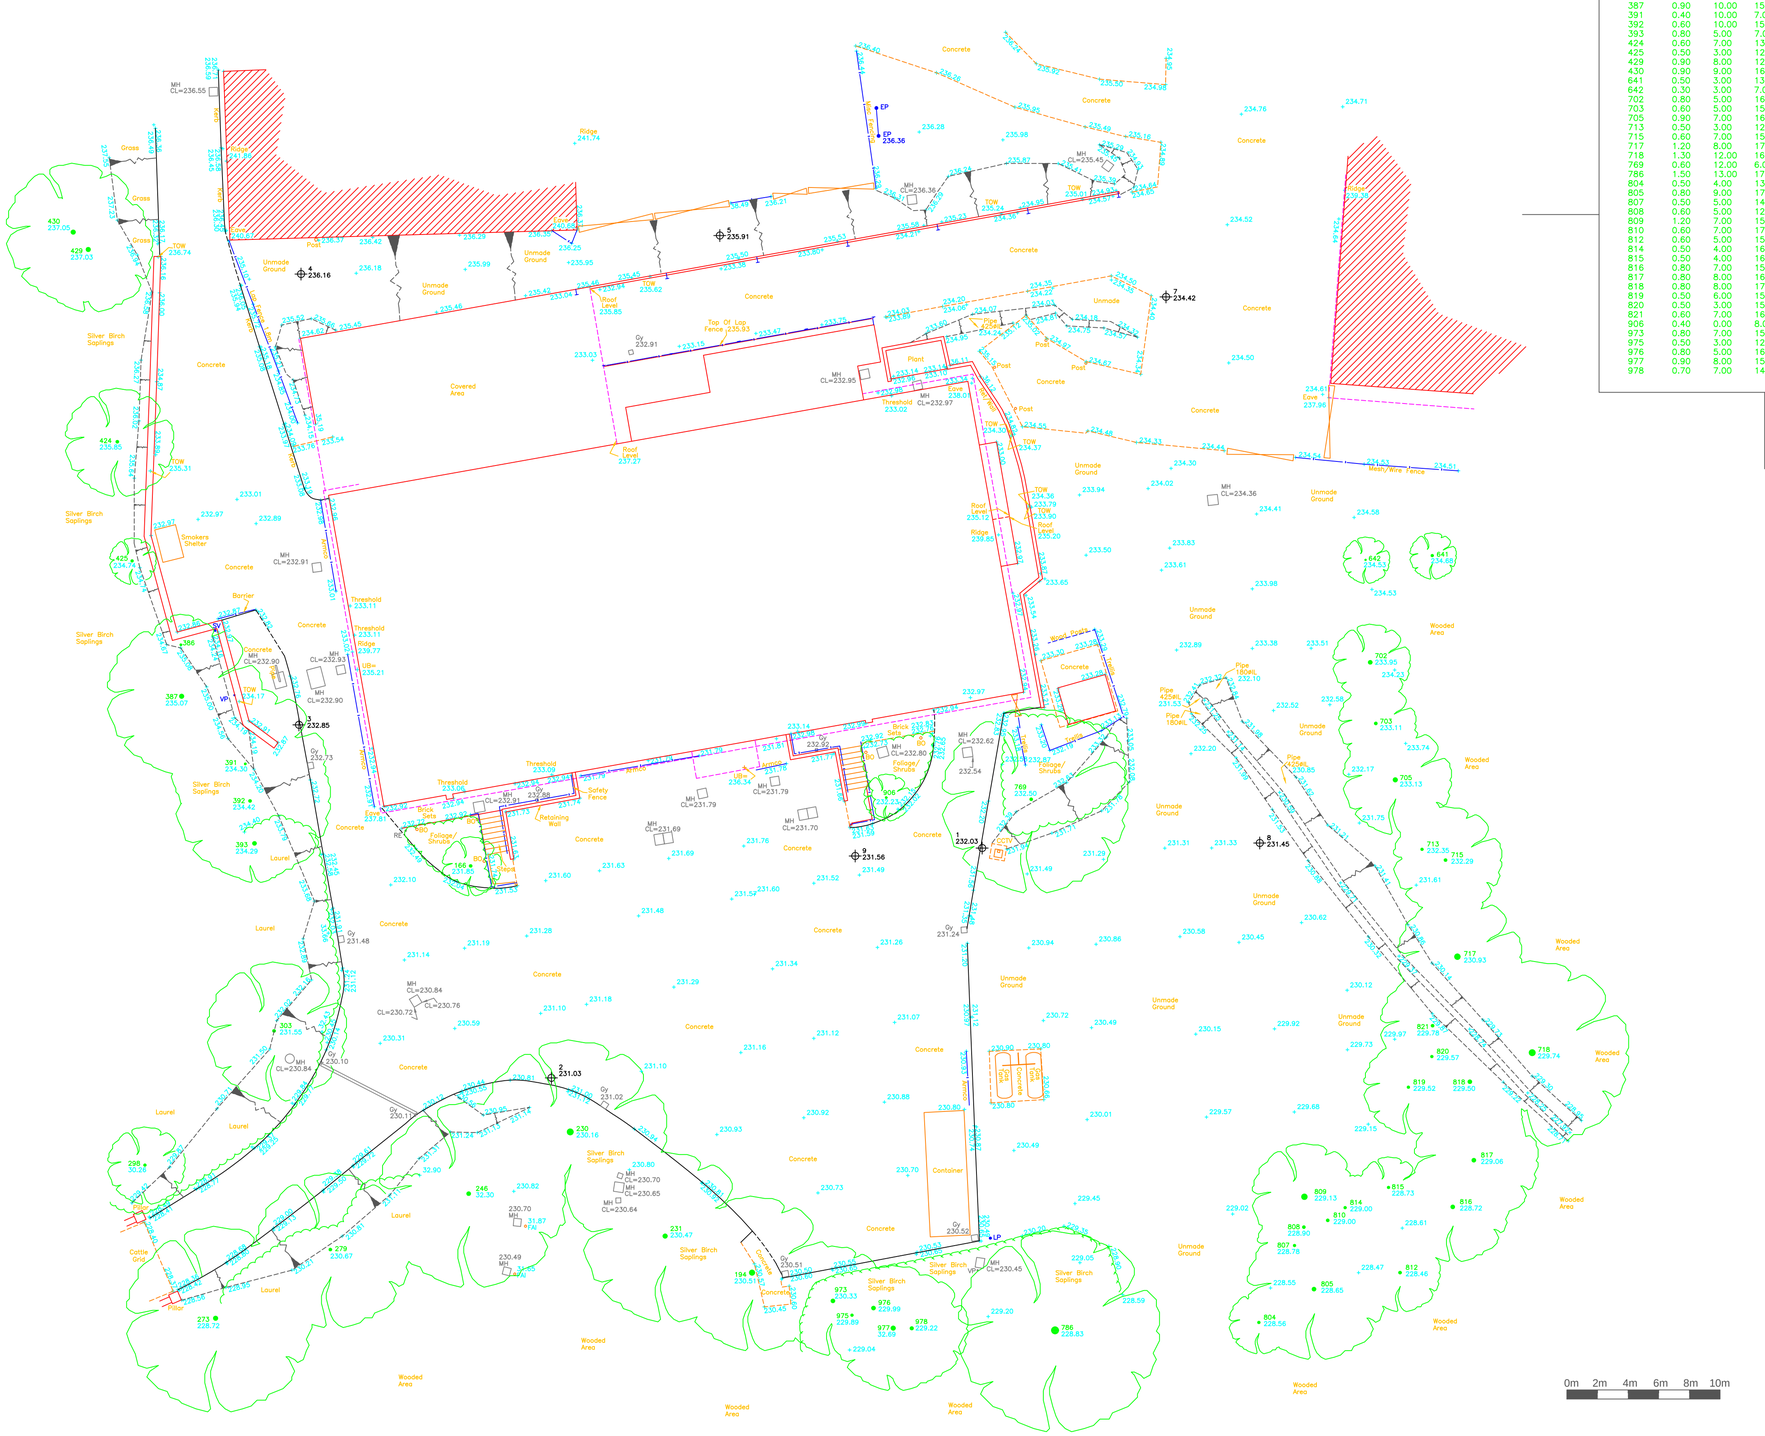

Tree Schedule

ID	Girth	Spread	Height	Species
166	0.60	0.00	9.00	Unknown
194	1.10	10.00	15.00	Silver Birch
230	1.30	12.00	16.00	Silver Birch
231	0.90	11.00	16.00	Sycamore
246	0.80	12.00	16.00	Silver Birch MB
273	0.90	12.00	16.00	Silver Birch
279	0.60	10.00	16.00	Silver Birch
298	0.50	5.00	15.00	Silver Birch
303	0.60	9.00	14.00	Silver Birch MB
386	0.40	4.00	5.00	Beech
387	0.90	10.00	15.00	Silver Birch
391	0.40	10.00	7.00	Unknown
392	0.60	10.00	15.00	Silver Birch MB
393	0.80	5.00	7.00	Silver Birch
424	0.60	7.00	13.00	Silver Birch MB
425	0.50	3.00	12.00	Silver Birch MB
429	0.90	8.00	12.00	Silver Birch
430	0.90	9.00	16.00	Silver Birch
641	0.50	3.00	13.00	Silver Birch
642	0.30	3.00	7.00	Unknown MB
702	0.80	5.00	16.00	Sallow
703	0.60	5.00	15.00	Sallow
705	0.90	7.00	16.00	Sallow
713	0.50	3.00	12.00	Sallow
715	0.60	7.00	15.00	Sallow
717	1.20	8.00	17.00	Sallow
718	1.50	12.00	16.00	Oak
769	0.60	12.00	6.00	Unknown
786	1.50	13.00	17.00	Oak
804	0.50	4.00	13.00	Cherry MB
805	0.80	9.00	17.00	Silver Birch MB
807	0.50	5.00	14.00	Silver Birch
808	0.60	5.00	12.00	Silver Birch
809	1.20	7.00	15.00	Silver Birch
810	0.60	7.00	17.00	Silver Birch
812	0.60	5.00	15.00	Unknown
814	0.50	4.00	16.00	Silver Birch
815	0.50	4.00	16.00	Silver Birch
816	0.80	7.00	15.00	Silver Birch
817	0.80	8.00	16.00	Silver Birch
818	0.80	8.00	17.00	Silver Birch
819	0.50	6.00	15.00	Silver Birch
820	0.50	3.00	15.00	Silver Birch
821	0.60	7.00	16.00	Silver Birch
906	0.40	0.00	8.00	Unknown
973	0.80	7.00	15.00	Silver Birch
975	0.50	3.00	12.00	Silver Birch
976	0.80	5.00	16.00	Silver Birch
977	0.90	8.00	15.00	Silver Birch
978	0.70	7.00	14.00	Silver Birch

NOTES:

Whilst every effort has been made to correctly identify species of trees on the site, we advise that an arboriologist be consulted before any final decisions are made.

Grid coordinates are based on Ordnance Survey National Grid.

All services have been shown within car park area that were visible at the time of survey

ABBREVIATION KEY – TOPOGRAPHIC SURVEY

AV	Air Valve
BO	Bollard
BIG	Back Inlet Gully
BT	British Telecom
CPS	Concrete Paving Slabs
CL=	Cover Level
CATV	Cable Television Cover
DY	Double Yellow Line
DR	Double Red Line
DW	Dashed White Line
ECB	Electric Cable Cabinet
ECP	Electric Cable Pit
EP	Electricity Pole
ER	Earth Rod
FAI	Fresh Air Inlet
FH	Fire Hydrant
F/B	Flower Bed
GV	Gas Valve
Gy	Gully
IL=	Invert Level
LC	Lamp Column
LP	Lamp Post
MB	Multi Bole
MK	Service Marker
PM	Parking Meter
RE	Rodding Eye
RS	Road Sign
RWP	Rain Water Pipe
SC	Stop Cock
SW	Single White Line
SY	Single Yellow Line
SV	Stop Valve
SVP	Soil and Vent Pipe
TCB	Telephone Cable Cabinet
TP	Telephone Pole
UTL	Unable To Lift
WG	Weir Gully
WM	Water Meter
WO	Wash Out

ABBREVIATION KEY – BUILDING SURVEY

CL	Floor To Ceiling
CL	Floor To False Ceiling
AB	Air Brick
DS	Double Socket
Dh	Door Head Level
Ceil HT	Ceiling Level
FA	Fire Alarm
FL	Floor Level
FS=	Floor To Sill
FS	Fuse Box
GL	Ground Line
Ht=	Height
LS	Light Switch
RWP	Rain Water Pipe
SA	Smoke Alarm
SD	Smoke Detector
SH=	Sill To Head
SS	Single Socket
Stat	Thermostat
SW	Switch
Tel	Telephone/Outlet
TV	Arial/Cable Socket
UA=	Under Arch (enter)
UO=	Under Opening
UB=	Under Beam
UD=	Under Duct
UP=	Under Pipe
WL	Wall Light
Wh=	Window Head Level
Wa=	Window Sill Level

Co-ordinate Table

ID	Easting	Northing	Height
1	407288.895	345078.636	232.026
2	407260.774	345063.634	231.028
3	407244.287	345086.684	232.853
4	407244.422	345116.113	236.161
5	407271.772	345118.631	235.907
7	407300.909	345114.624	234.424
8	407307.026	345078.967	231.452
9	407280.611	345078.120	231.561

REV. SUFFIX	DATE	INITIAL	REVISION DETAILS

LEVELLING DATUM
Related To Ordnance Survey Utilising GPS

CAD OPERATOR	CDH	APPROVED BY	BED	DATE	29.04.2016

Survey and Engineering Services Ltd

Land, Architectural and Engineering Surveyors

CLIENT
Bull Construction Ltd

LOCATION
The Abattoir
Ramshorn
Oakamoor
Staffordshire

DRAWING TITLE
Detail Survey

ORIGINAL JOB No.	JOB No.
	030516
DRAWING No.	REVISION SUFFIX
030516/topo	
SCALE	DATE
1:200 (A1 Sheet	*3rd May 2016*

The Granary
Lee Farm
Lee Lane
Pinkneys Green
Maidenhead
SL6 6PE

Registered Company No: 5366478

Tel No / Fax: +44 (0) 1628 675 781
e-mail: mail@ses-surveyors.co.uk