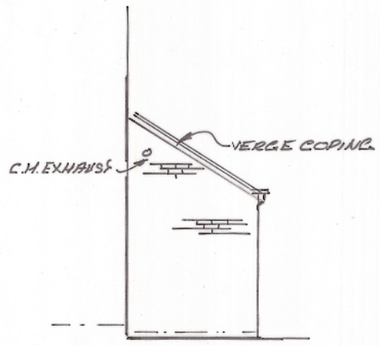

VIEW ON B-B.

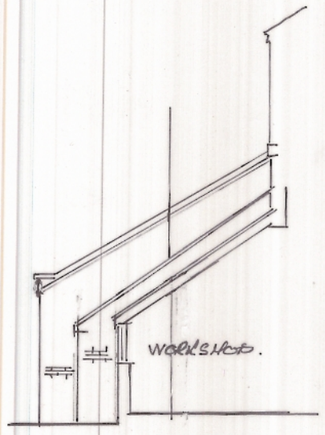

SECTION VIEW
D-D.

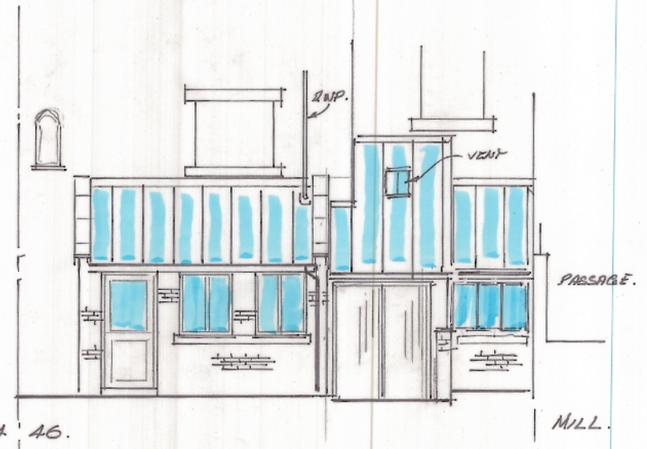

REAR (WEST) ELEVATION

REAR ACCESS PASSAGE TO ALBION MILL

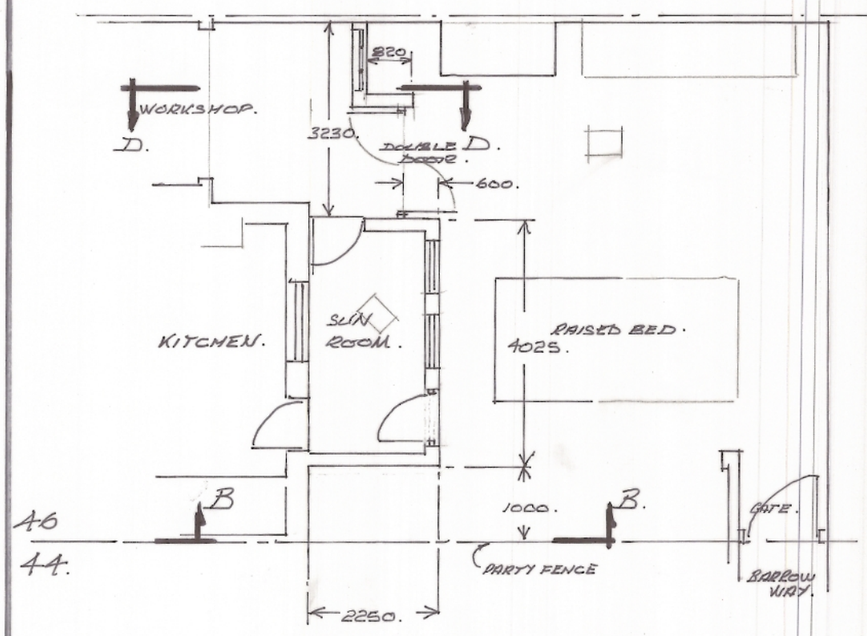

GROUND FLOOR PLAN.

(DIMENSIONS IN MMs.)

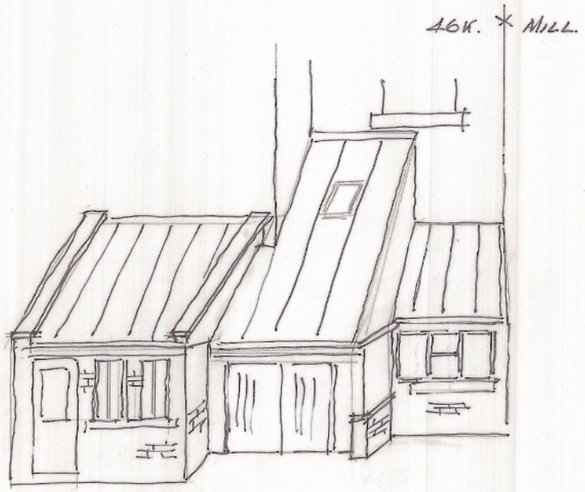

REAR ELEVATION
PICTORIAL VIEW (NTS)
SHOWING ROOF DETAIL.

ROOF :- TRIPLE WALL POLYCARBONATE
WALLS :- MATCHING BRICKWORK.
WINDOWS :- TIMBER FRAMED D.G.
FLASHINGS :- LEAD & FLASH BAND.
DOORS :- TIMBER - VERTICAL BOARD & 1/2 GLAZE.

AS BUILT DETAILS.

SEE ALSO PHOTO'S : PH1 → PH4.

REGULARIZATION SUBMISSION.

Proposed CONSERVATORY / SUN ROOM & EXTENSION OF WORKSHOP.	
At 46 KING ST LEEK STAFFS.	
For R.W. MITCHELL	
R.W. Mitchell ENG.TECH.MIE./AMIPlant E.	Date 12-10-2016.
	Scale 1:50
	DRG. No. 0845.

0 1 2 3 4 5 m.
0 3 6 9 12 ft. 1:50.