


South West Elevation




North West Elevation




North East Elevation

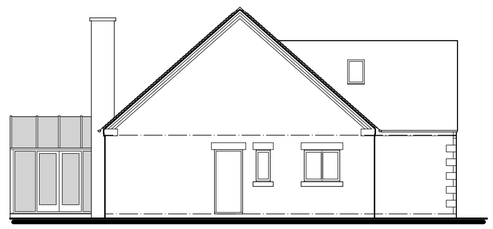


South East Elevation

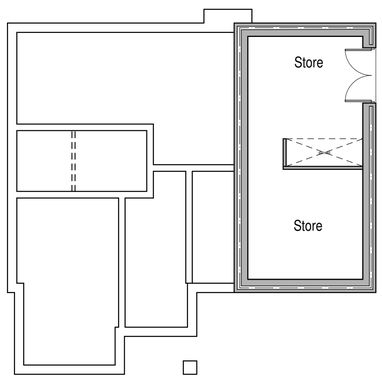

Basement Plan

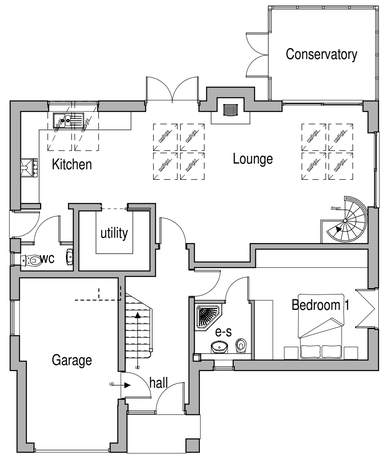

Ground Floor Plan

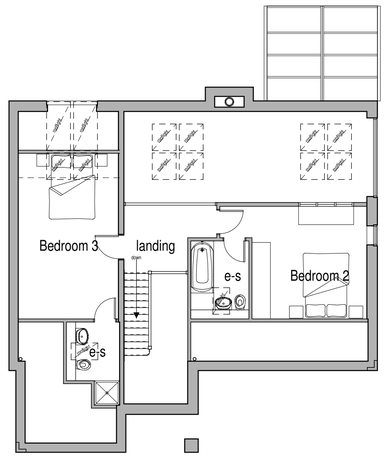

First Floor Plan



scale bar @ 1:100

Mr and Mrs J Miller

PROPOSED DWELLING (RETROSPECTIVE)
INCLUDING REAR CONSERVATORY
TO REAR OF THE DIMBLE,
LIMEKILN LANE, ALTON,
STAFFORDSHIRE MOORLANDS,
ST10 4AR

PLANNING PROPOSAL
PLANS + ELEVATIONS

Date	Sheet	Scale
FEBRUARY 2016	A1	1:100
Drg No.	Rev.	Drawn
2013-1930-09	B	NAW

A - 15/06/2016 - FRONT ELEVATION (NORTH-EAST) SHOWN
B - 11/08/2016 - ELEVATIONS AND PLAN (JOINERY) UPDATED TO MATCH AS-BUILT (2013-1930-12)

SAMMONS LIMITED Architectural

Chartered Institute of Architectural Technologists Registered Practice

10 Cawdry Buildings, Fountain Street, Leek. ST13 6JP
Telephone: 01538 386002
E-mail: info@sammonsltd.co.uk
Web: www.sammonsltd.co.uk

This drawing is copyright. Do not scale.
All dimensions must be checked prior to commencement.