Revisions

.	.	.

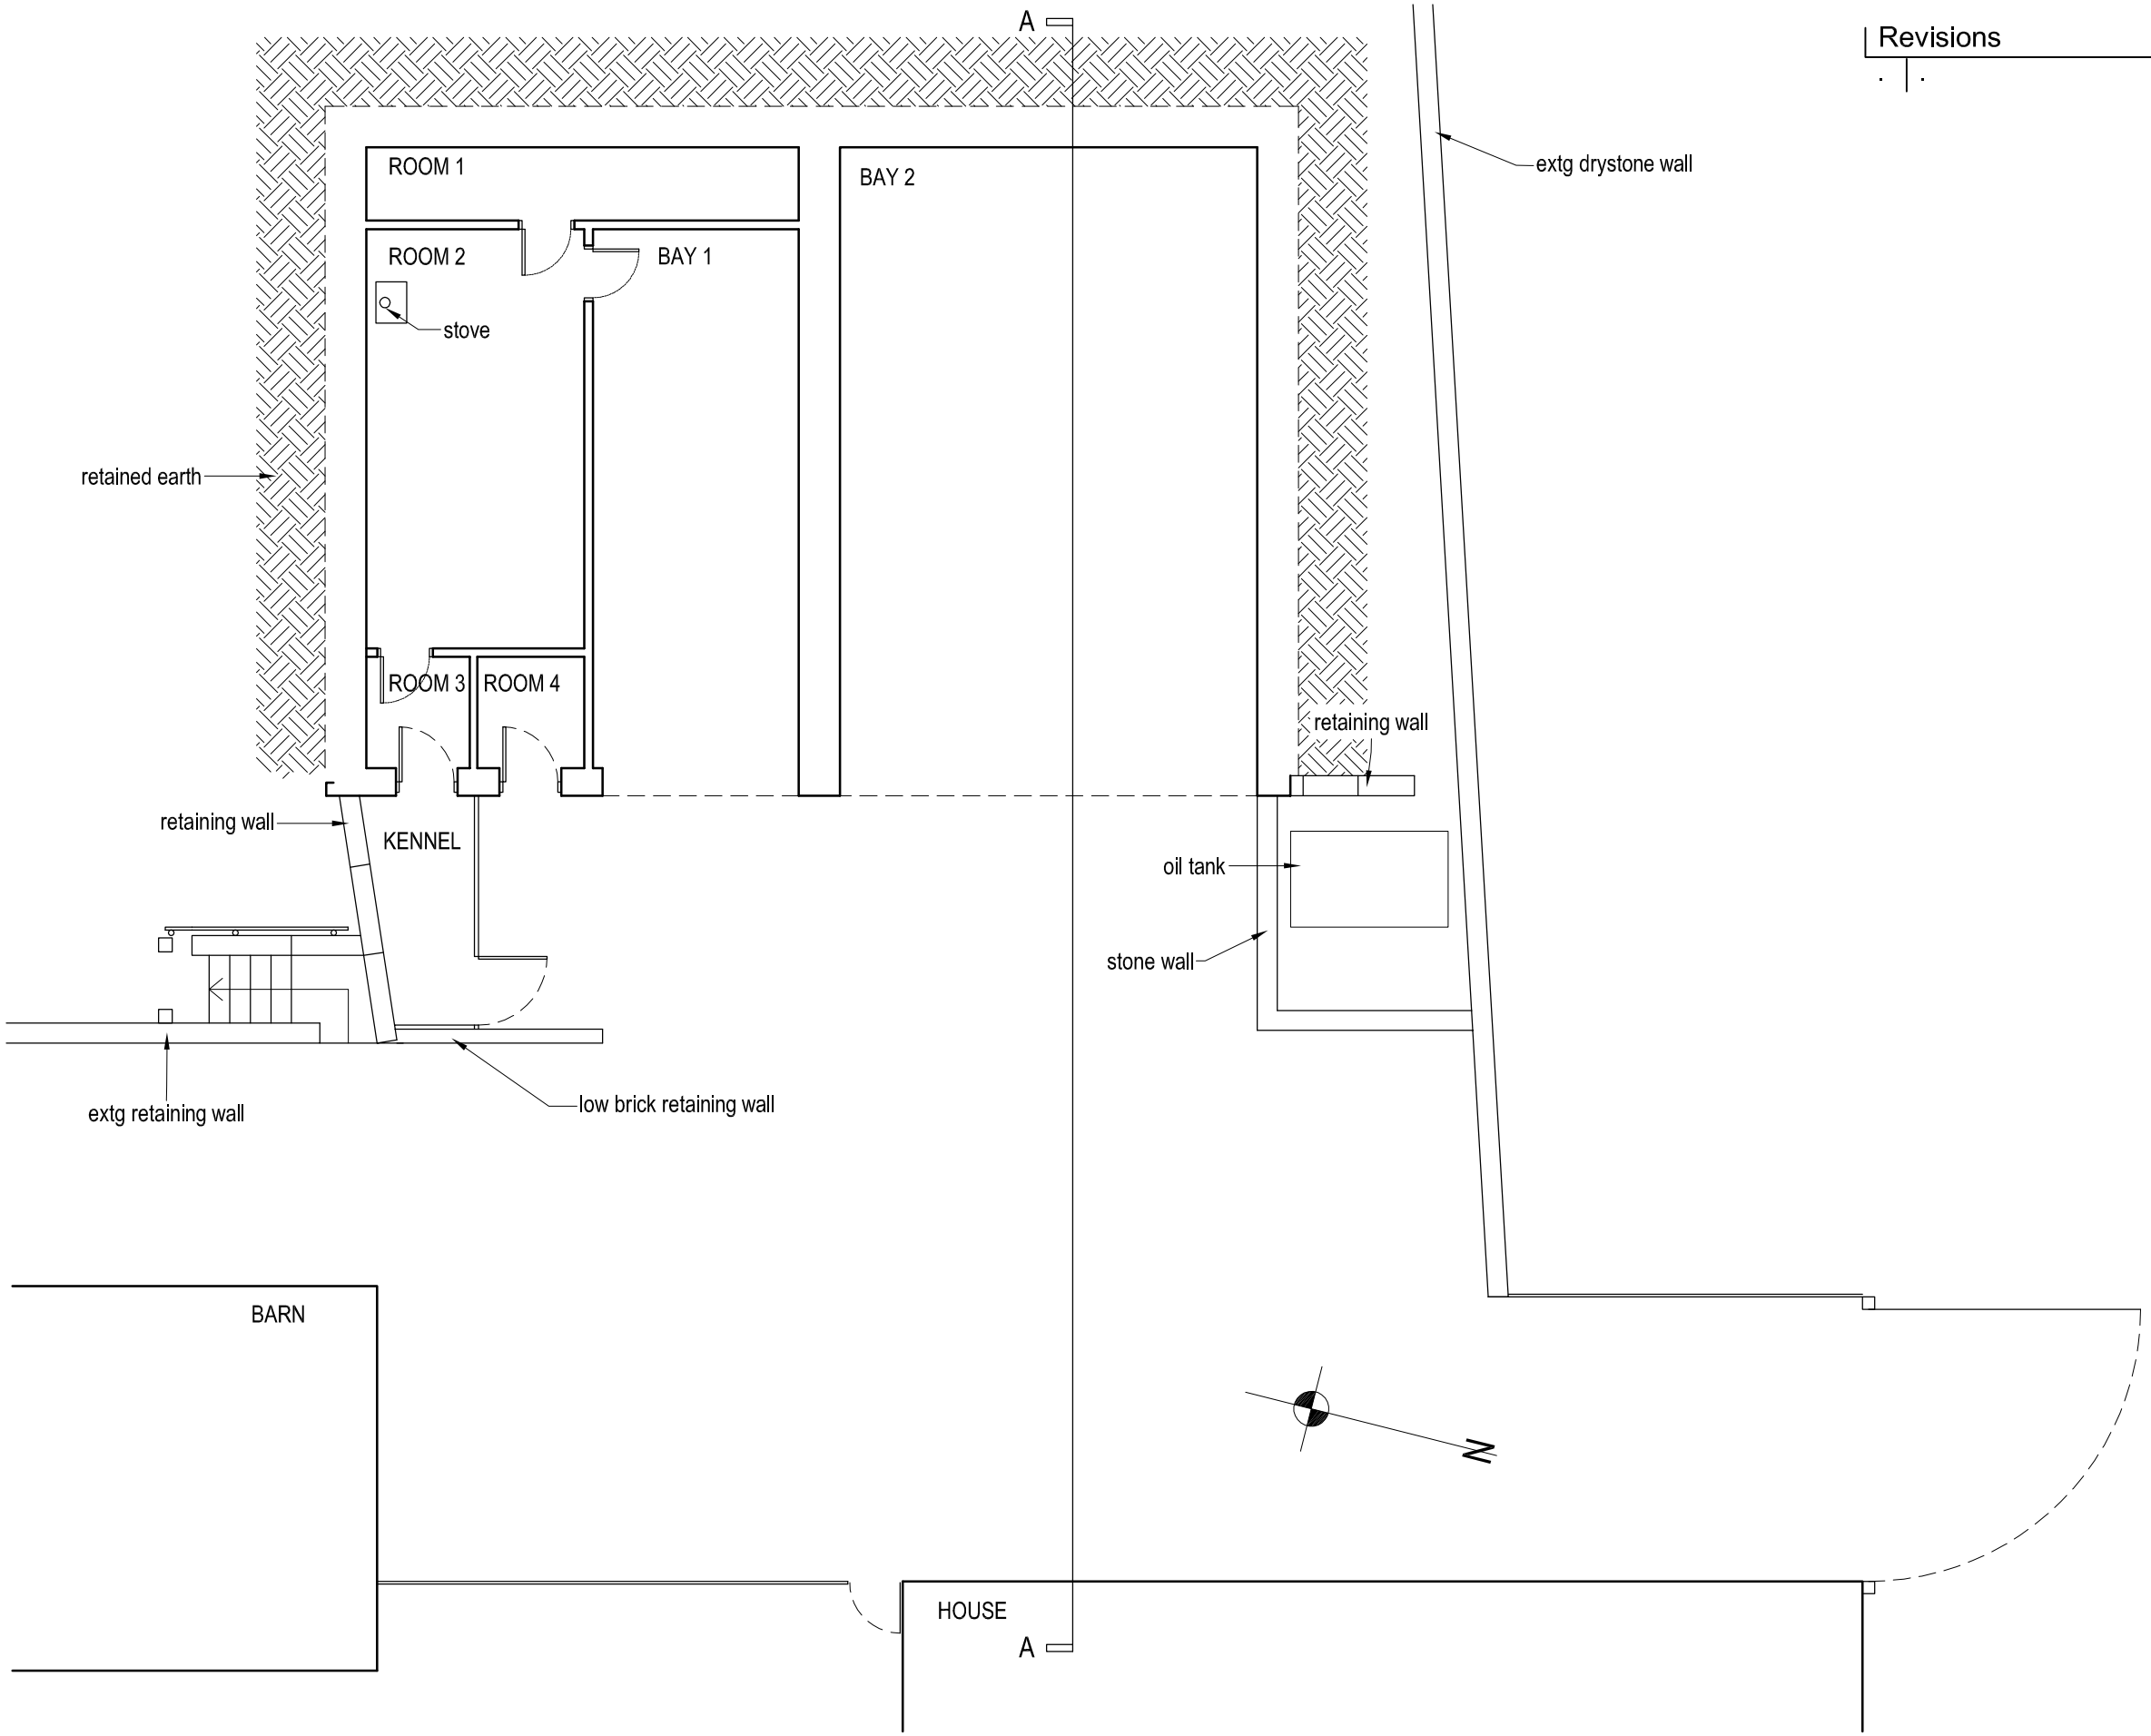

FLOOR PLAN

0 1 2 3 4 5m

job	Green Acres, Cloudside Garage Block		
title	Floor Plan as Built		
date 17.08.15	scale 1/100 @ A3	dwg. no. G-03	rev. .

Ian Ankers architecture
Building and Design Consultants
Ryecroft Farm, Rushton Spencer, Macclesfield, SK11 0RP
t 01260 546944
e ian@ianankers.co.uk
w www.ianankers.co.uk