Revisions		
.	.	.

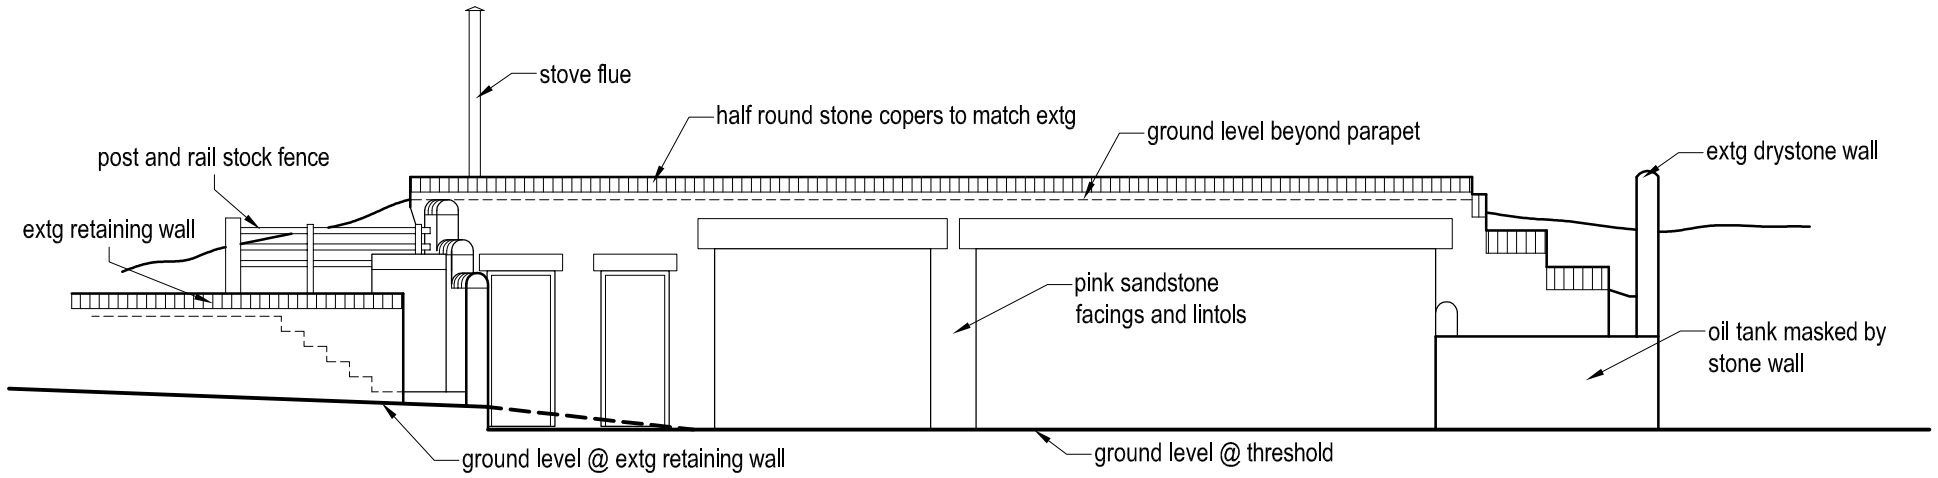

WEST ELEVATION

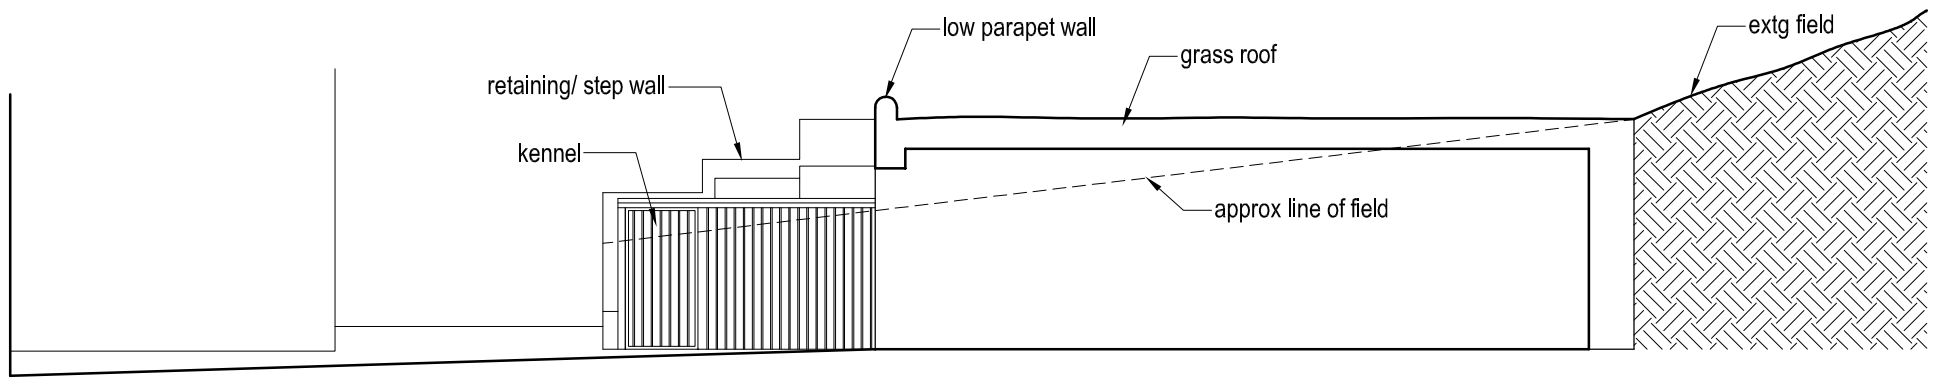

SECTION A-A

0 1 2 3 4 5m

job	Green Acres, Cloudside Garage Block		
title	Elevations and Section A-A as Built		
date 17.08.15	scale 1/100 @ A3	dwg. no. G-04	rev. .

Ian Ankers architecture
Building and Design Consultants
Ryecroft Farm, Rushton Spencer, Macclesfield, SK11 0RP
t 01260 546944
e ian@iananders.co.uk
w www.iananders.co.uk