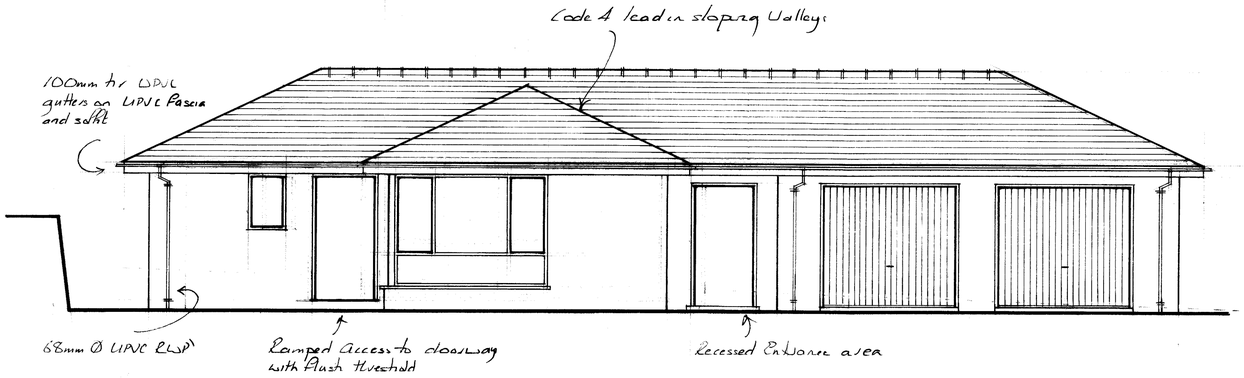

NORTH EAST ELEVATION

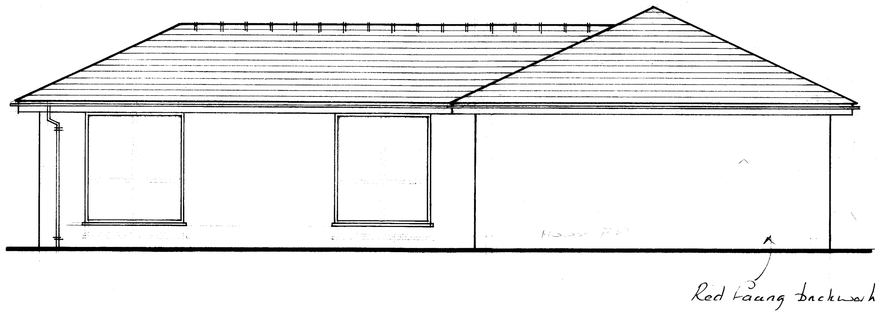

NORTH WEST ELEVATION

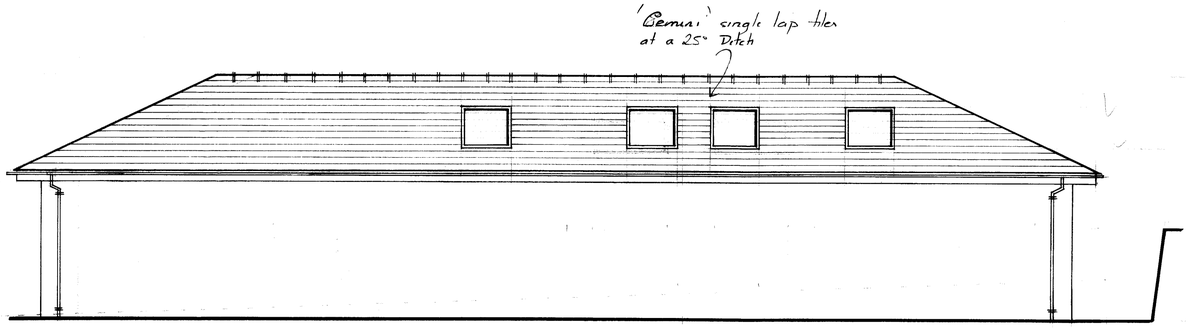

SOUTH WEST ELEVATION

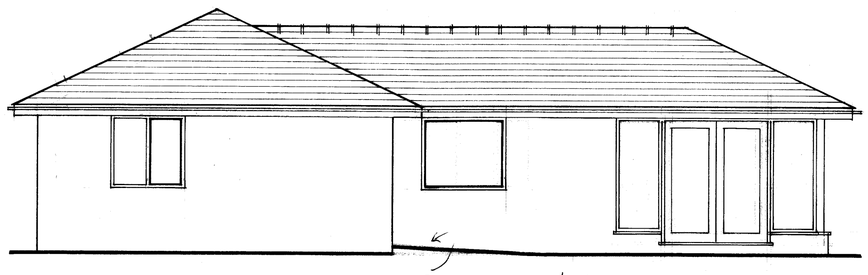

SOUTH EAST ELEVATION

Height of Building not to be Lugher than 4m from ground level adjacent to building in accordance with The Town and Country planning (General permitted Development) Order 1995 - Article 1(3).

CLIENT

Mr and Mrs P Brown

PROJECT

Ancillary Domestic Accommodation
"As Built" Details

At

11 Battlesteads
Alton
Stoke-on-Trent
Staffordshire
ST10 4BE

DRAWING NUMBER 09/206/1A

Elevations

SCALES 1/50