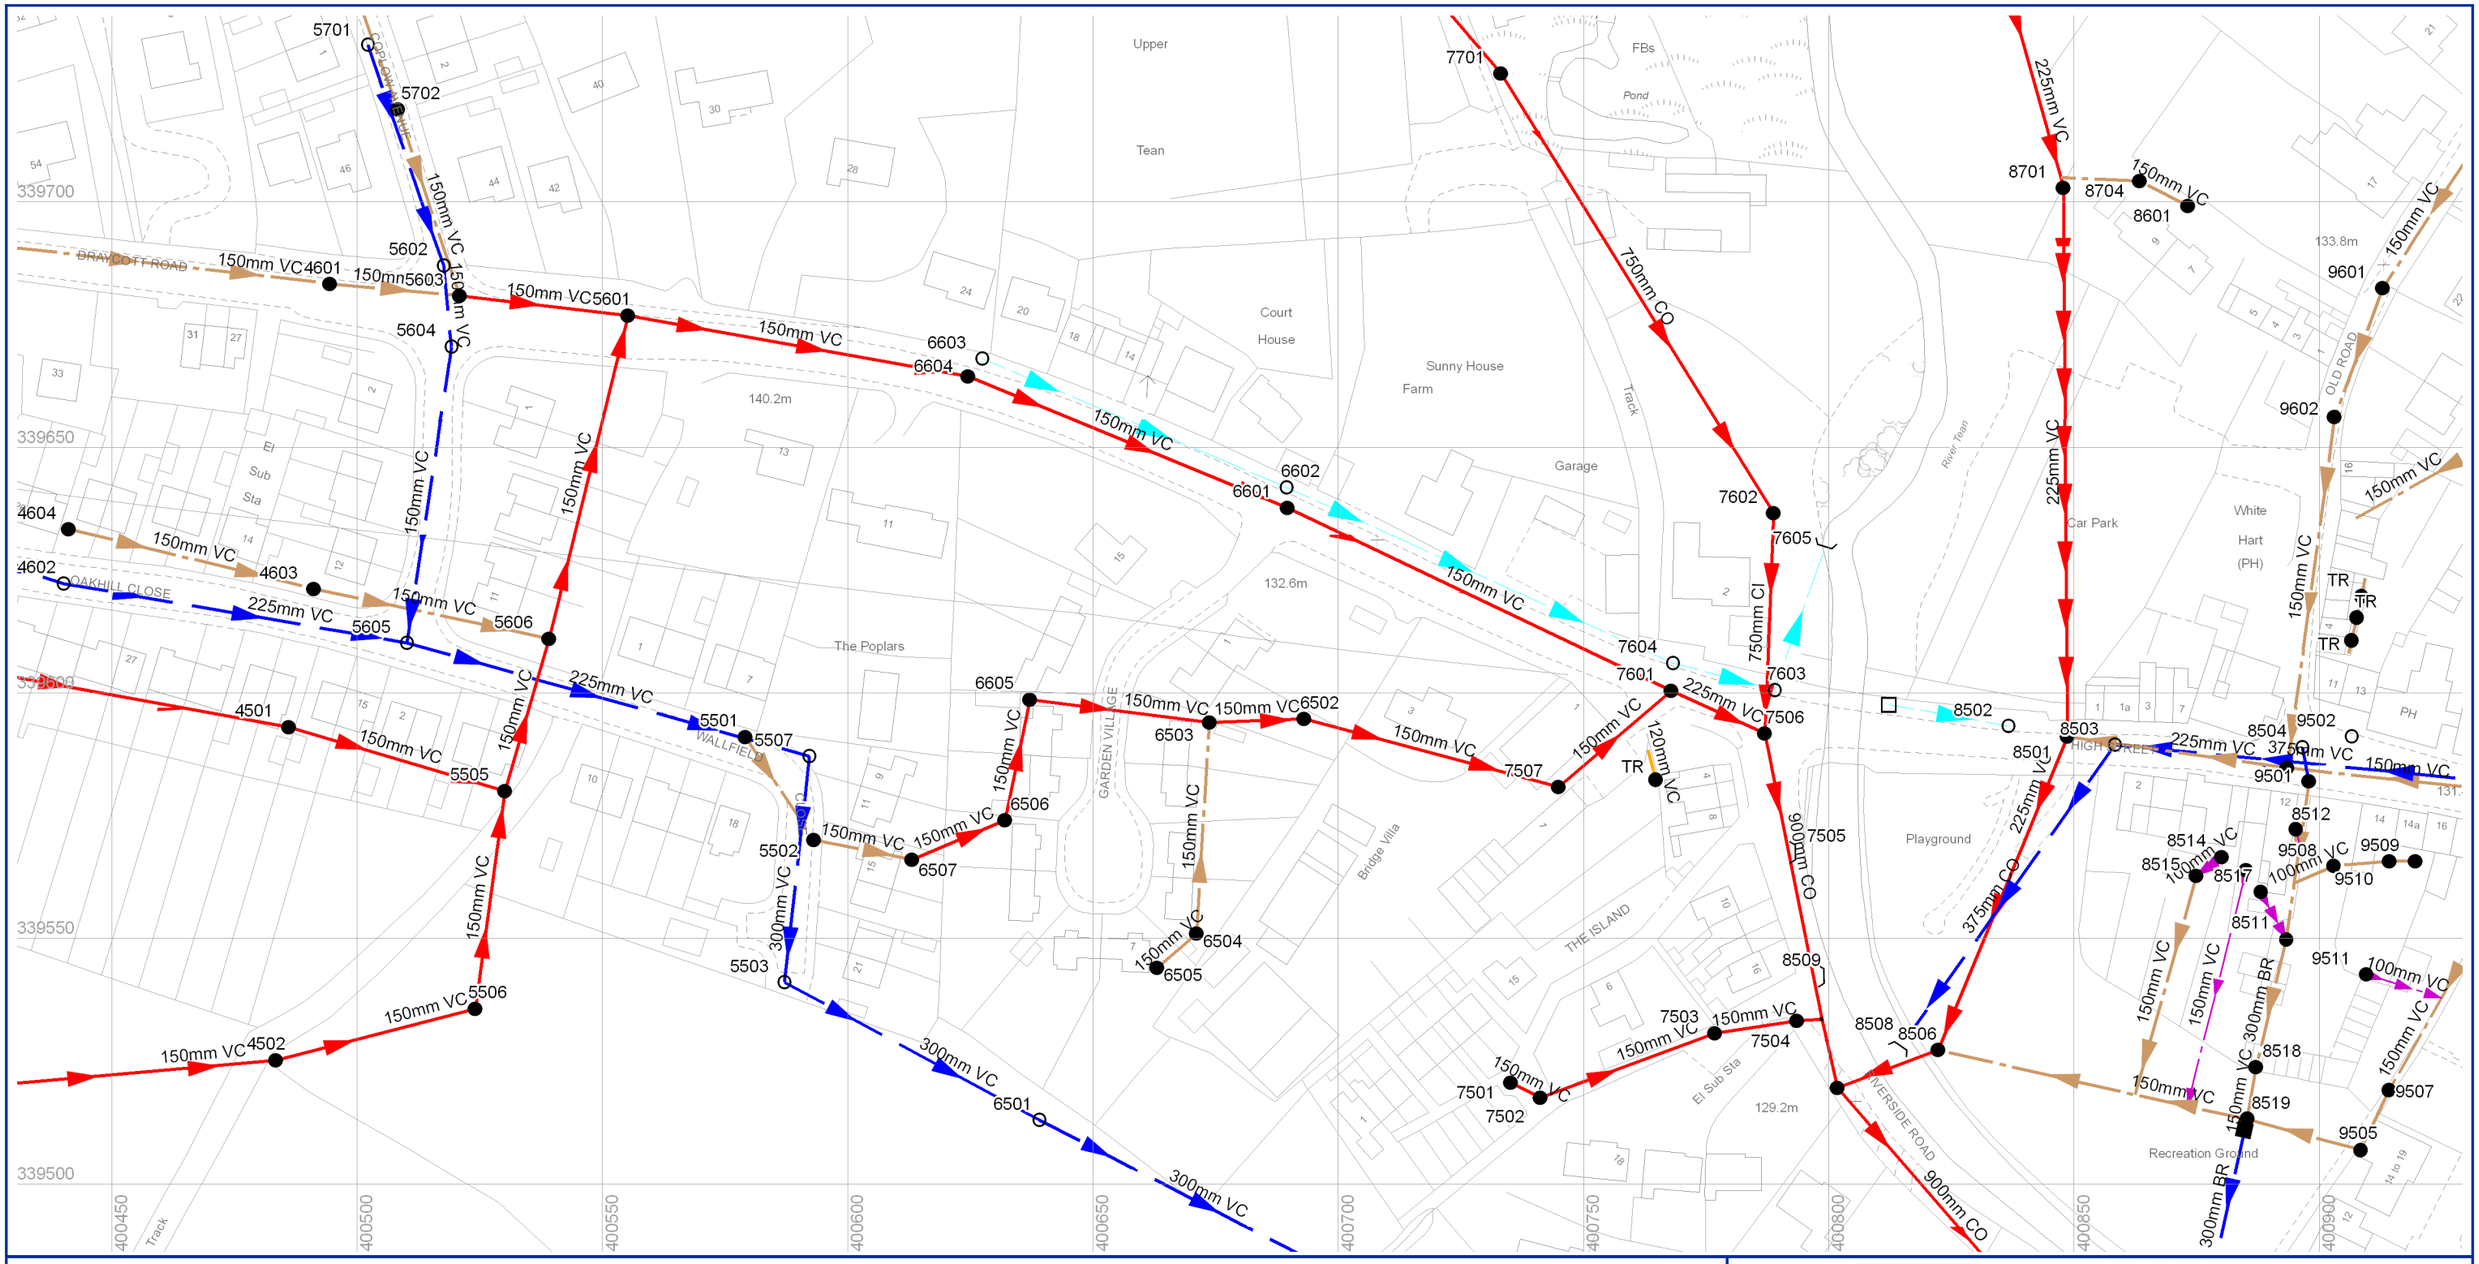

Abandoned Gravity Sewer
Private Combined Gravity Sewer
Private Foul Gravity Sewer
Private Surface Water Gravity Sewer
Public Combined Gravity Sewer
Public Foul Gravity Sewer
Public Surface Water Gravity Sewer
Trunk Combined Gravity Sewer
Trunk Foul Use Gravity Sewer
Trunk Surface Water Gravity Sewer
Combined Use Pressurised Sewer
Foul Use Pressurised Sewer
Surface Water Pressurised Sewer
Highway Drain
Combined Lateral Drain (SS)
Foul Lateral Drain (SS)
Surface Water Lateral Drain (SS)

All Private Sewers are shown in magenta
All section 104 sewers are shown in green
All Sewers that have been transferred to Severn Trent Water after the 1st October 2011, but have not been surveyed and confirmed by Severn Trent Water are shown n orange

Culverted Watercourse
Cable, Earthing
Cable Junction
Cable, Optical Fibre/Instrumentation
Cable, Low Voltage
Cable, High Voltage
Cable, Other
Housing, Building
Housing, Kiosk
Disposal Site
Sewage Treatment Works
Housing, Other
Pipe Support Structure
Sewage Pumping Facility
Sewer Facility Connection Inlet / Outlet

Blind Shaft
Combined Use Manhole
Flushing Chamber
Foul Use Manhole
Grease Trap
Head Node
Hydrobrake
Lamphole
Outfall
Overflow
Penstock
Petrol Interceptor

Sewer Chemical Injection Point
Sewer Junction
Sewerage Air Valve
Sewerage Hatch Box Point
Sewerage Isolation Valve
Soakaway
Surface Water Manhole
Vent Column
Waste Water Storage
Pre-1937 Properties

MATERIALS

- - NONE
AC - ASBESTOS CEMENT
BR - BRICK
CB - CONCRETE BOX CULVERT
CI - CAST IRON
CO - CONCRETE
CSB - CONCRETE SEGMENTS (BOLTED)
CSU - CONCRETE SEGMENTS (UNBOLTED)
DI - DUCTILE IRON
GRC - GLASS REINFORCED CONCRETE
GRP - GLASS REINFORCED PLASTIC
MAC - MASONRY IN REGULAR COURSES
MAR - MASONRY RANDOMLY COURSED
PE - POLYETHLENE
PF - PITCH
PP - POLYPROPYLENE
PSC - PLASTIC STEEL COMPOSITE
PVC - POLYVINYL CHLORIDE
RPM - REINFORCED PLASTIC MATRIX
SI - SPUN (GREY) IRON
ST - STEEL
U - UNKNOWN
VC - VITRIFIED CLAY
XXX - OTHER

SHAPE

C - CIRCULAR
E - EGG SHAPED
O - OTHER
R - RECTANGLE
S - SQUARE
T - TRAPEZOIDAL
U - UNKNOWN

CATEGORIES

W - WEIR
C - CASCADE
DB - DAMBOARD
SE - SIDE ENTRY
FV - FLAP VALVE
BD - BACK DROP
S - SIPHON
HD - HIGHWAY DRAIN
S104 - SECTION 104

PURPOSE

C - COMBINED
E - FINAL EFFLUENT
F - FOUL
L - SLUDGE
S - SURFACE WATER

N
W E
S

SEVERN TRENT WATER

Severn Trent Water Limited
Asset Data Management
PO Box 5344
Coventry
CV3 9FT
Telephone: 0845 601 6616

SEWER RECORD

O/S Map scale: 1:1250
Date of issue: 02.09.16

This map is centred upon:
O / S Grid reference:
x : 400680
y : 339612

Disclaimer Statement:
1. Do not scale off this Map.
2. This map and any information supplied with it is furnished as a general guide, is only valid at the date of issue and no warranty as to its correctness is given or implied. In particular this Map and any information shown on it must not be relied upon in the event of any development or works (including but not limited to excavations) in the vicinity of Severn Trent Water's assets or for the purposes of determining the suitability of a point of connection to the sewerage or distribution systems.
3. On **1 October 2011** most private sewers and private lateral drains in Severn Trent Water's sewerage area, which were connected to a public sewer as at 1 July 2011, transferred to the ownership of Severn Trent Water and became public sewers and public lateral drains. A further transfer takes place on 1 October 2012 (date to be confirmed).
Private pumping stations, which form part of these sewers or lateral drains, will transfer to the ownership of Severn Trent Water on or before 1 October 2016.
Severn Trent Water does not possess complete records of these assets.
These assets may not be displayed on this Map.
4. Reproduction by permission of Ordnance Survey on behalf of HMSO. © Crown Copyright and database right 2004. All rights reserved. Ordnance Survey licence number **100018202**. Document users other than Severn Trent Water business users are advised that this document is provided for reference purpose only and is subject to copyright, therefore, no further copies should be made from it.