

Copyright of this drawing is vested in the Architect and it must not be copied or reproduced without consent. Figured dimensions only are to be taken from this drawing. All contractors must visit the site and be responsible for taking and checking all dimensions relative to their work. Hewitt&Carr Architects Ltd are to be advised of any variation between drawings and site conditions.
DO NOT SCALE OFF THIS DRAWING.....IF IN DOUBT ASK


Rev.	Drawn	Comments	Date

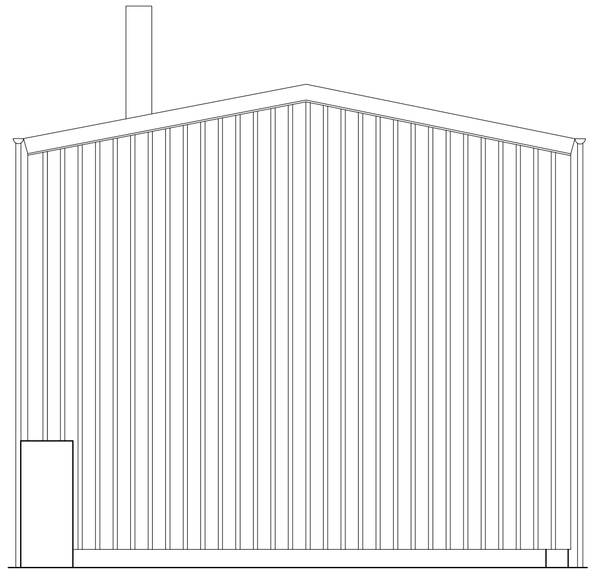


REAR ELEVATION 1:50

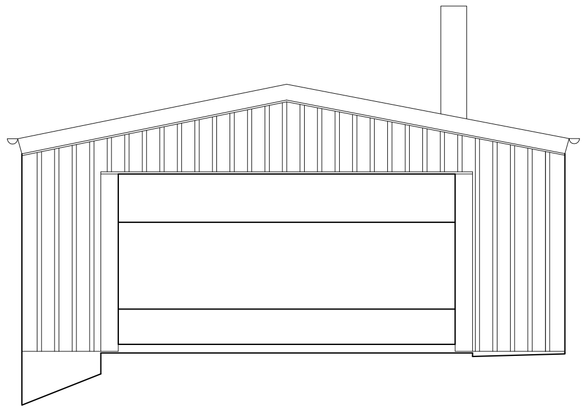


FRONT ELEVATION 1:50

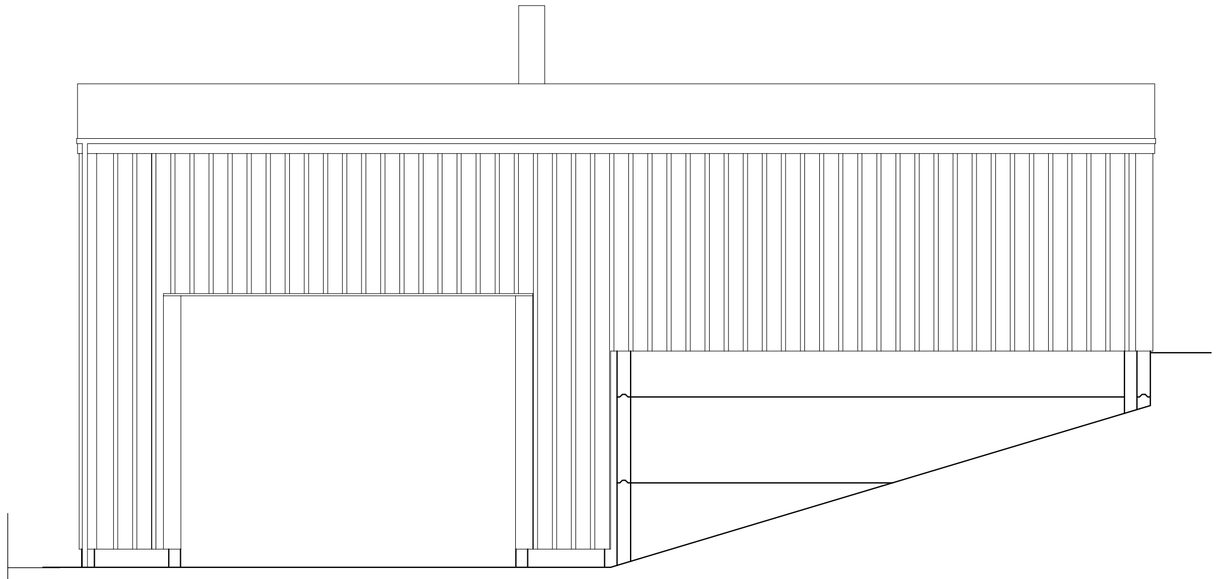


SIDE ELEVATION 1:50

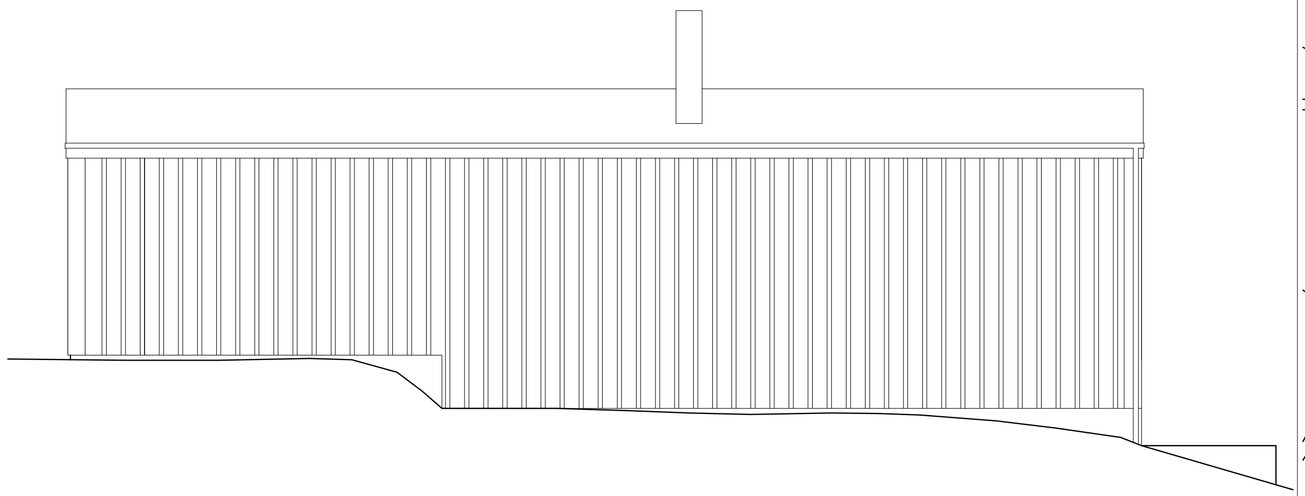


SIDE ELEVATION 1:50

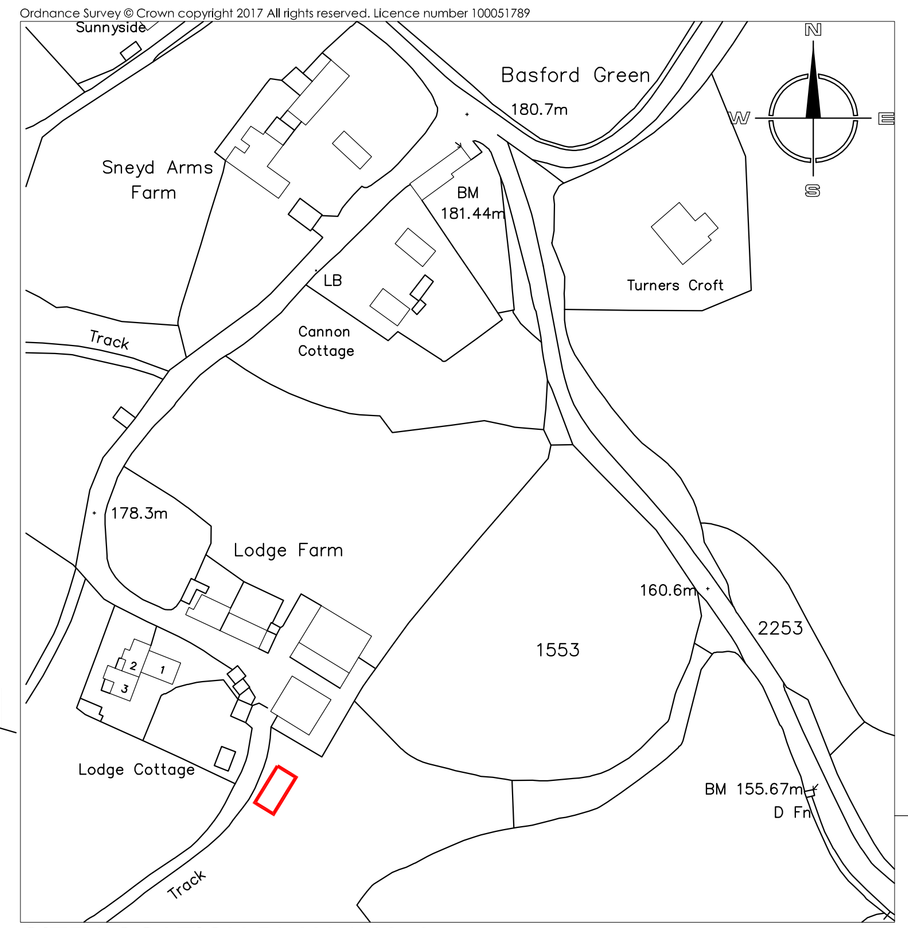


SITE LOCATION PLAN 1:1250

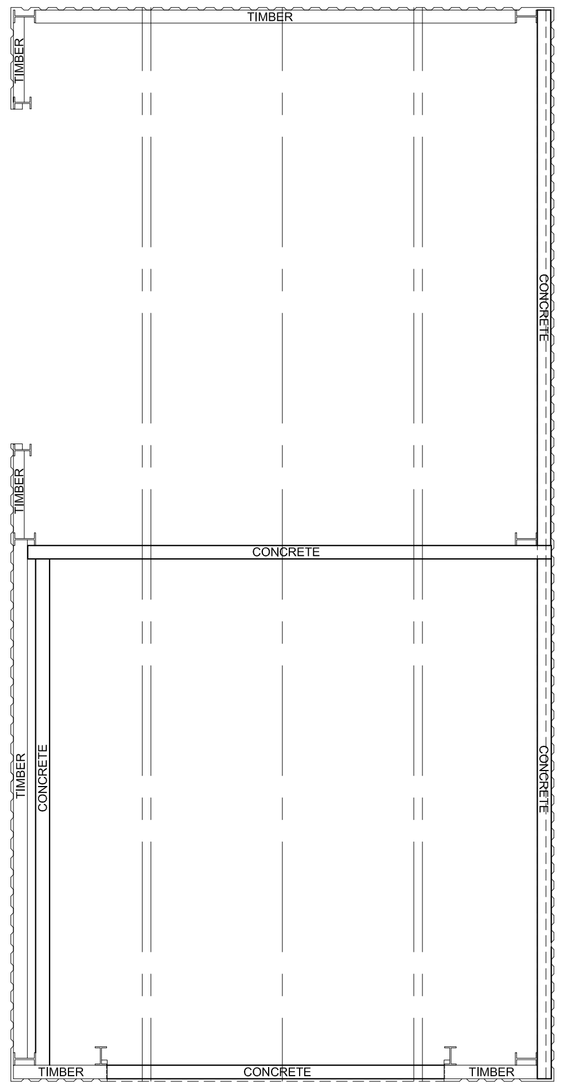

FLOOR PLAN 1:50

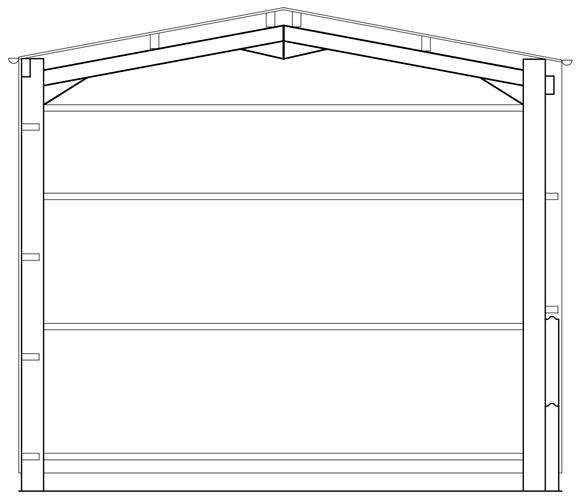

TYPICAL SECTION 1:50

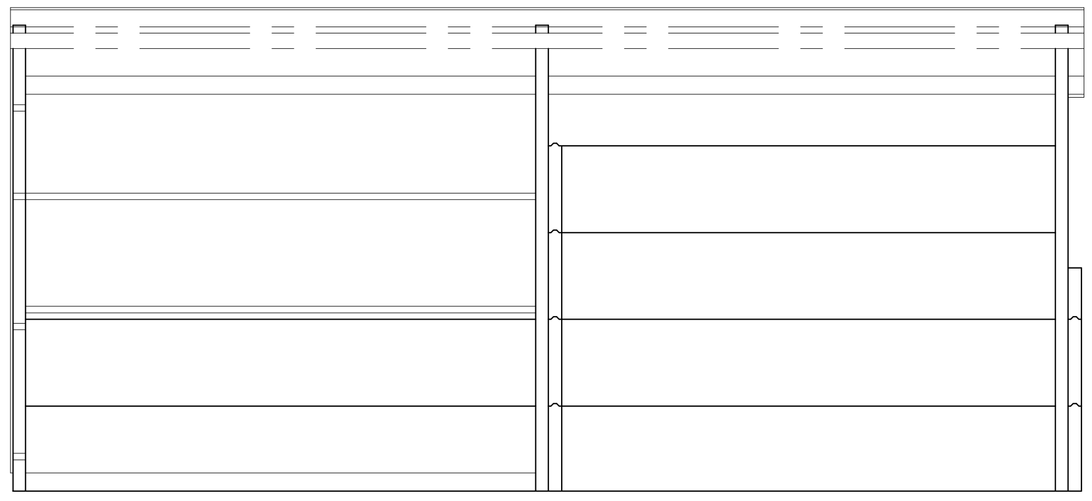

TYPICAL SECTION 1:50

Hewitt&Carr Architects
A: 2-4 Cross Street I Cheadle I Staffordshire I ST10 1NP
T: 01538 756888
E: enquiries@hcarchitects.co.uk
W: www.hcarchitects.co.uk

Client
Mr Scott-Moncrief

Project
As built drawings for retrospective planning application

Title
Existing plans and elevations

SURVEY

Status
Survey

Date Feb 2017 Drawn WJH

Scale @A1 As stated Checked

Project No 00617 Drawing No. AL(0)01 Rev

File Ref: H:\REF