Copyright of this drawing is vested in the Architect and it must not be copied or reproduced without consent. Figured dimensions only are to be taken from this drawing. All contractors must visit the site and be responsible for taking and checking all dimensions relative to their work. Hewitt&Carr Architects Ltd are to be advised of any variation between drawings and site conditions.
CLIENTS ARE ADVISED TO CLARIFY DIMENSIONS WITH THE ARCHITECT PRIOR TO SETTING OUT AND NOT TO SCALE FROM THE DRAWING

Rev.	Drawn	Comments	Date
A	KB	Red line changed	10.07.17
B	KB	Pre-development Commenced Plans added	03.10.17

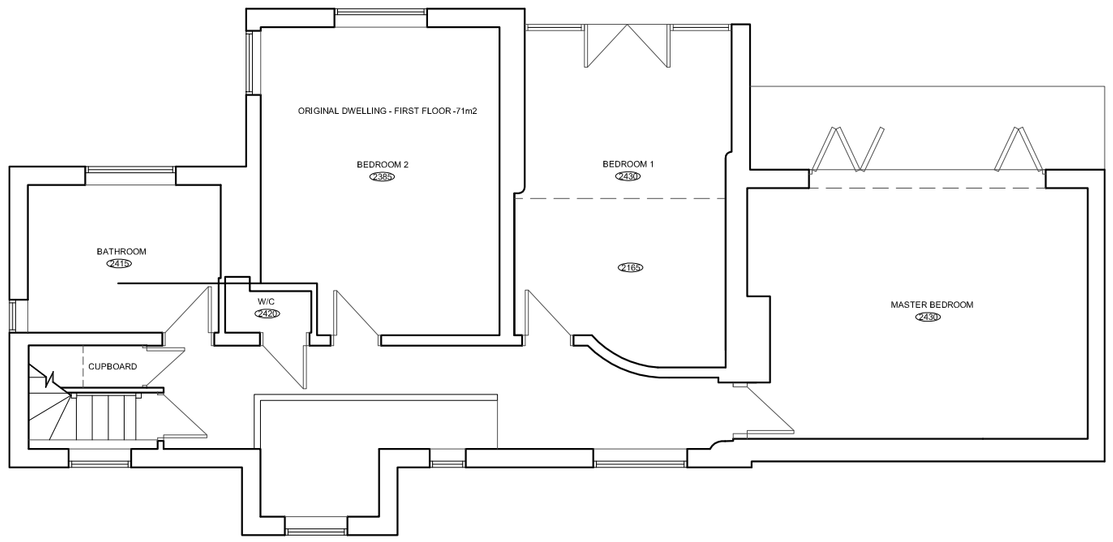

Pre-Development Commenced First Floor Plan 1:100

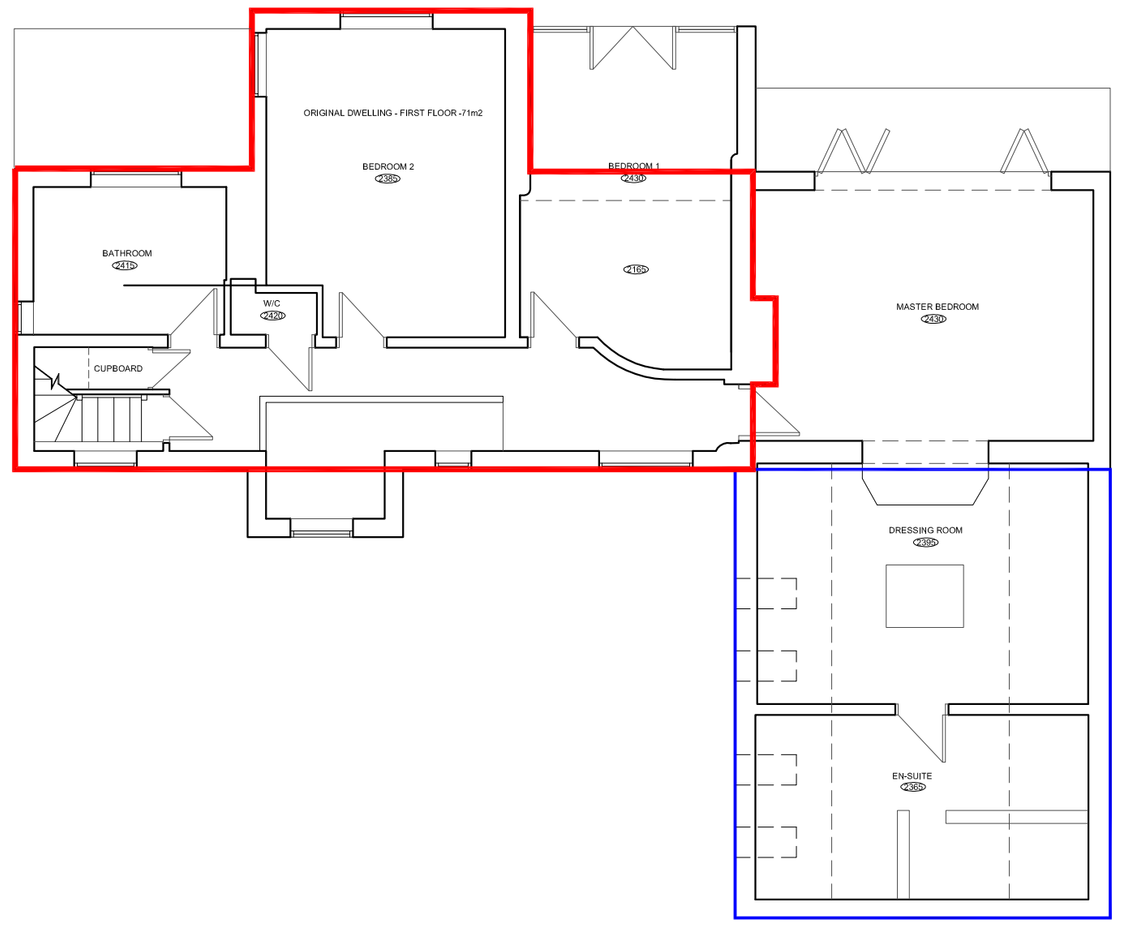

Current First Floor Plan 1:100

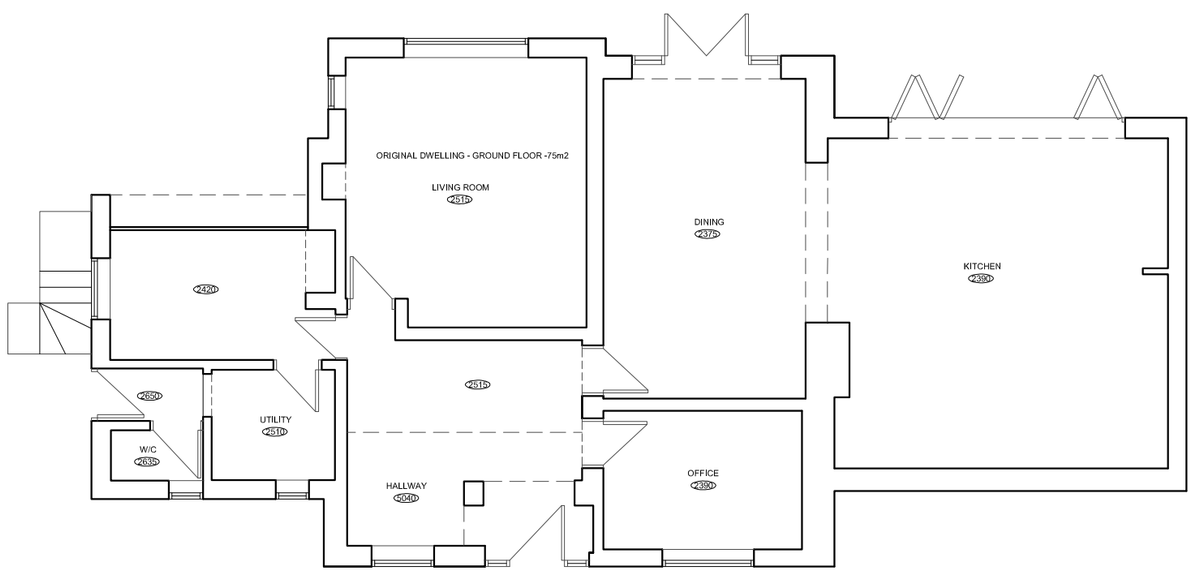

Pre-Development Commenced Ground Floor Plan 1:100

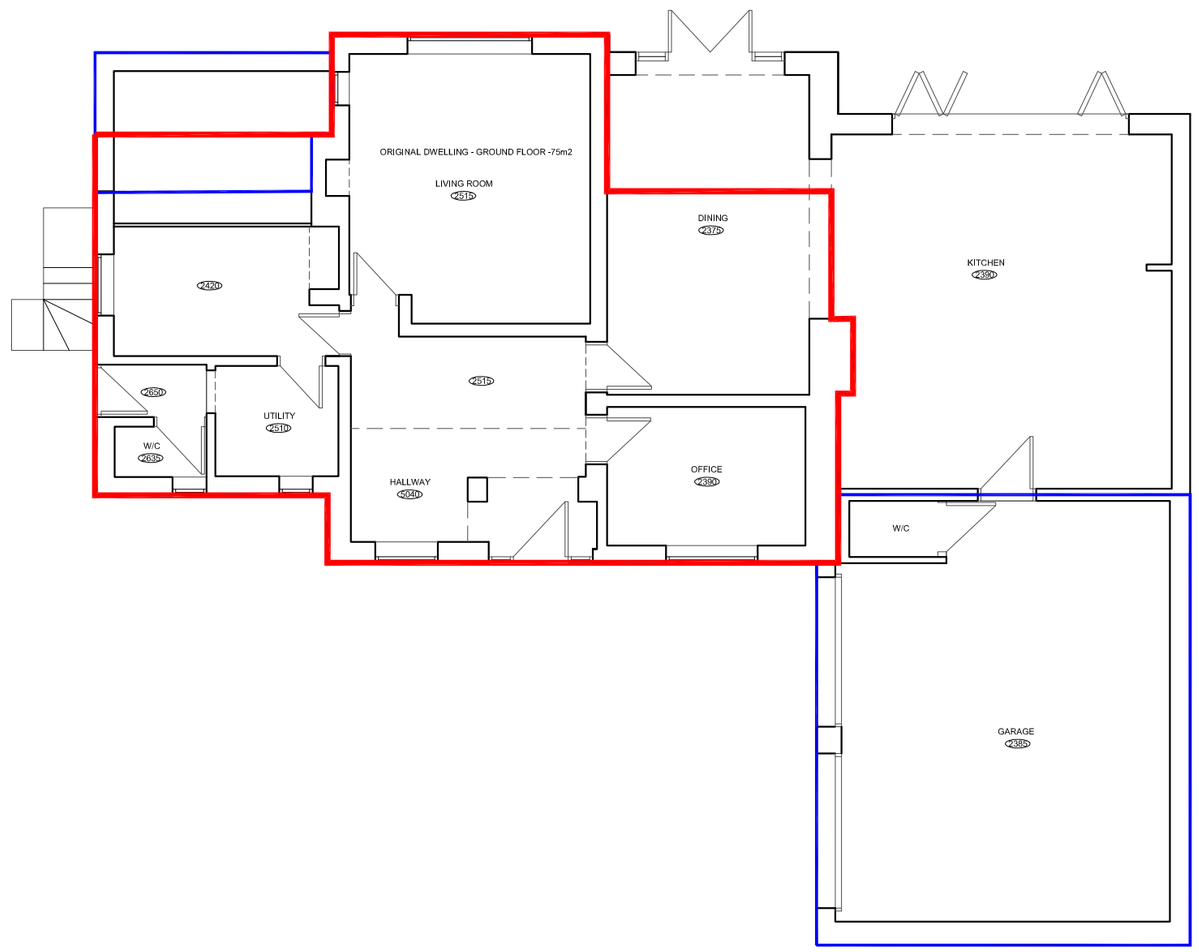

Current Ground Floor Plan 1:100

Hewitt&Carr Architects
A: 2-4 Cross Street I Cheadle I Staffordshire I ST10 1NP
T: 01538 756888
E: enquiries@hcarchitects.co.uk
W: www.hcarchitects.co.uk

Client
Mr Ward

Project
Existing Drawings and Proposal

PLANNING

Title
Pre-Development Commenced Plans and Plans as Currently Existing

Status
Planning

Date July 2017 Drawn KB

Scale @A2 As Stated Checked

Project No Drawing No.
00664 - AL(0)02 Rev B

File Ref: H:\