


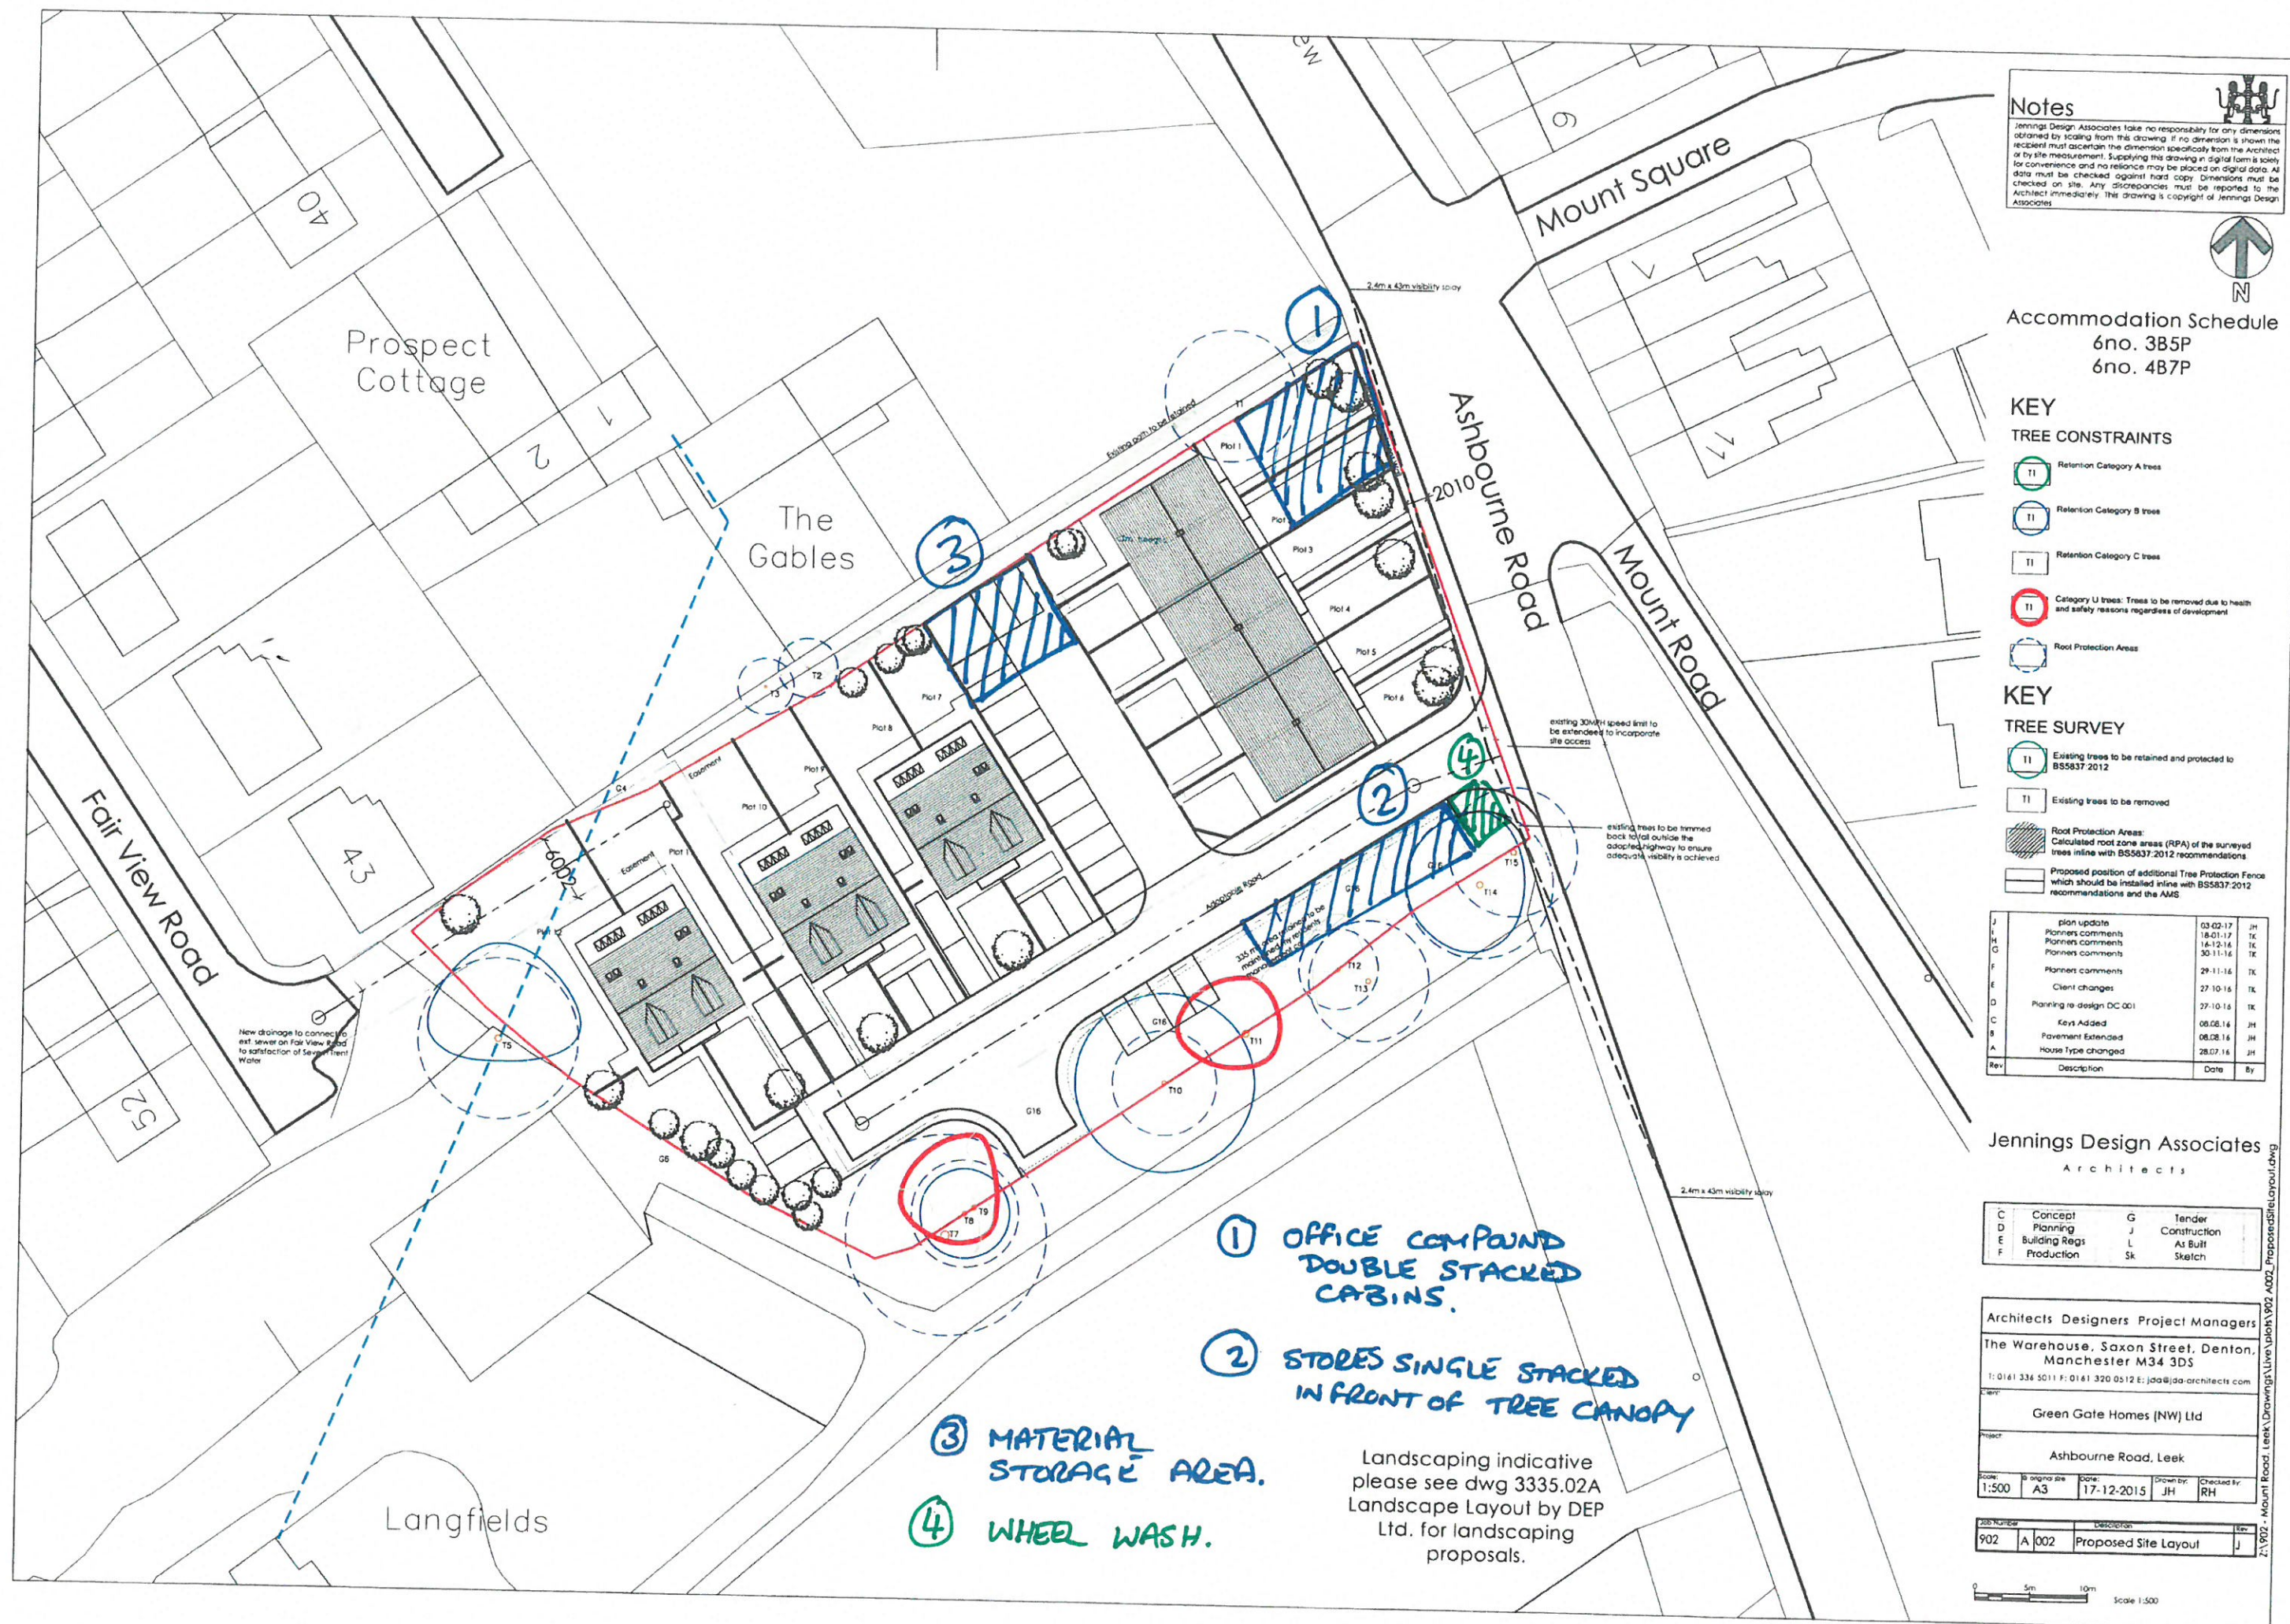

Notes
Jennings Design Associates take no responsibility for any dimensions obtained by scaling from this drawing. If no dimension is shown the recipient must ascertain the dimension specifically from the Architect or by site measurement. Supplying this drawing in digital form is solely for convenience and no reliance may be placed on digital data. All data must be checked against hard copy. Dimensions must be checked on site. Any discrepancies must be reported to the Architect immediately. This drawing is copyright of Jennings Design Associates.

Accommodation Schedule
6no. 3B5P
6no. 4B7P

- KEY**
TREE CONSTRAINTS
- T1 Retention Category A trees
 - T1 Retention Category B trees
 - T1 Retention Category C trees
 - T1 Category U trees: Trees to be removed due to health and safety reasons regardless of development
 - Root Protection Areas

- KEY**
TREE SURVEY
- T1 Existing trees to be retained and protected to BS5837:2012
 - T1 Existing trees to be removed
 - Root Protection Areas: Calculated root zone areas (RPA) of the surveyed trees inline with BS5837:2012 recommendations
 - Proposed position of additional Tree Protection Fence which should be installed inline with BS5837:2012 recommendations and the AMS

J	plan update	03.02.17	JH
H	Planners comments	18.01.17	TK
G	Planners comments	16.12.16	TK
F	Planners comments	30.11.16	TK
E	Planners comments	29.11.16	TK
D	Client changes	27.10.16	TK
C	Planning re-design DC-001	27.10.16	TK
B	Keys Added	08.08.16	JH
A	Pavement Extended	08.08.16	JH
Rev	House type changed	28.07.16	JH
Rev	Description	Date	By

Jennings Design Associates
Architects

C	Concept	G	Tender
D	Planning	J	Construction
E	Building Regs	L	As Built
F	Production	Sk	Sketch

Architects Designers Project Managers
The Warehouse, Saxon Street, Denton,
Manchester M34 3DS
T: 0161 334 5011 F: 0161 320 0512 E: jda@jda-architects.com

Green Gate Homes (NW) Ltd
Project:
Ashbourne Road, Leek
Scale: 1:500
Is original site: A3
Date: 17-12-2015
Drawn by: JH
Checked by: RH

200 Number	Description	Rev
902	A 002 Proposed Site Layout	J

0 5m 10m
Scale 1:500

① OFFICE COMPOUND
DOUBLE STACKED
CABINS.

② STORES SINGLE STACKED
IN FRONT OF TREE CANOPY

③ MATERIAL
STORAGE AREA.

④ WHEEL WASH.

Landscaping indicative
please see dwg 3335.02A
Landscape Layout by DEP
Ltd. for landscaping
proposals.