AS BUILT DETAIL | 'A3'


1:100 (0 1 2 3 4 5 6 7 8 9 10)

DRG Nº MB 16/48


PROPOSED !!!

Rev'A' Amended per client's request.

Rev'B' As built detail for submission to L.A. to client's instruction & measurements. 1/9/18

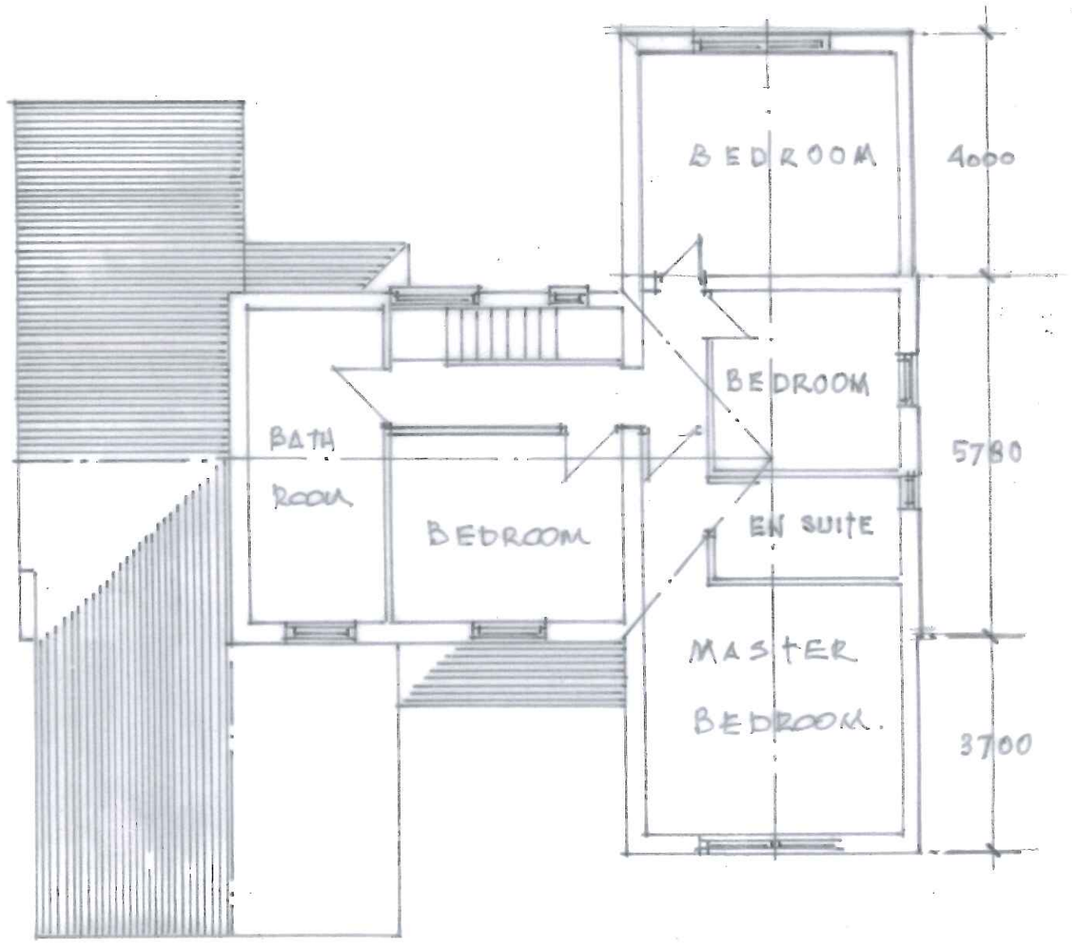

FIRST FLOOR PLAN

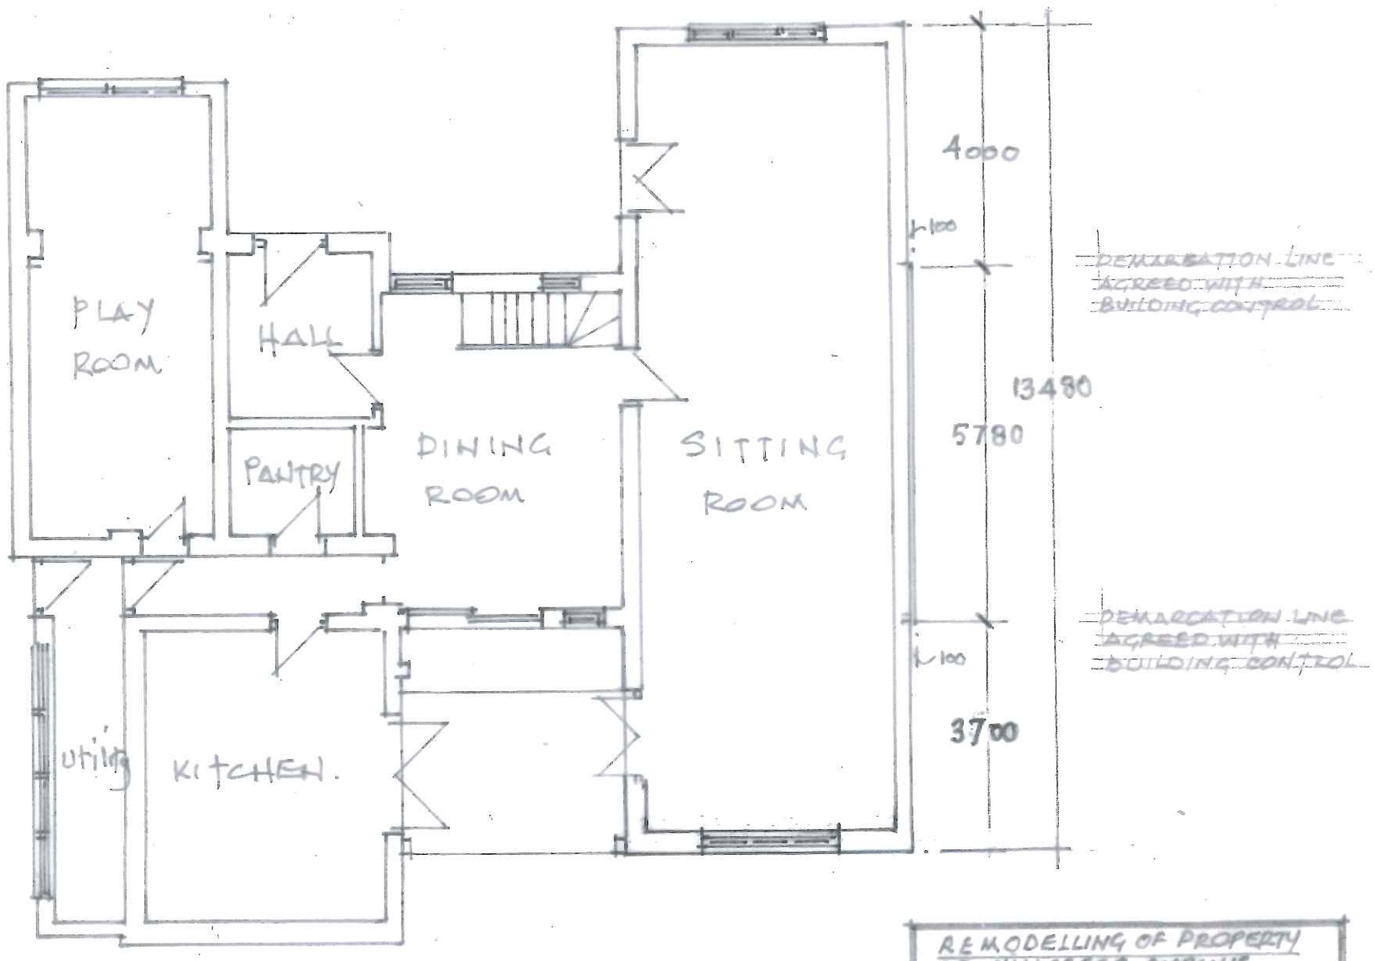

GROUND PLAN.

Applicant: MR. M BEECH

REMODELLING OF PROPERTY
28, HILLCREST AVENUE
KINGSLEY HOLT, STAFFS 1/9/18.