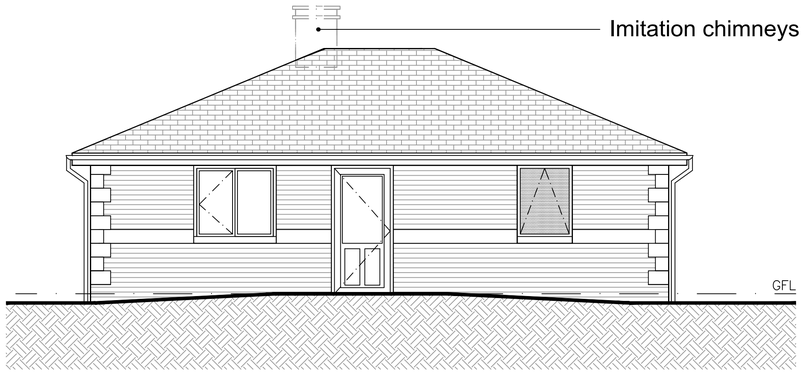

PROPOSED SIDE ELEVATION

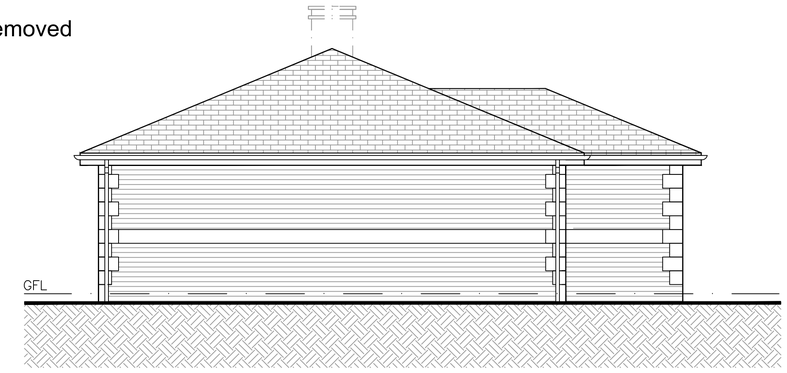

PROPOSED SIDE ELEVATION

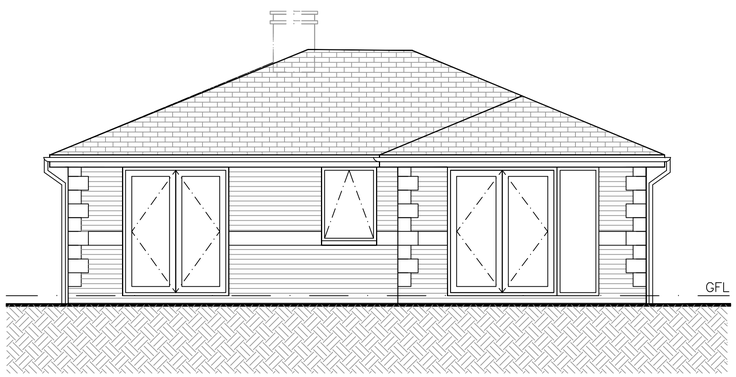

~~PROPOSED SIDE ELEVATION~~

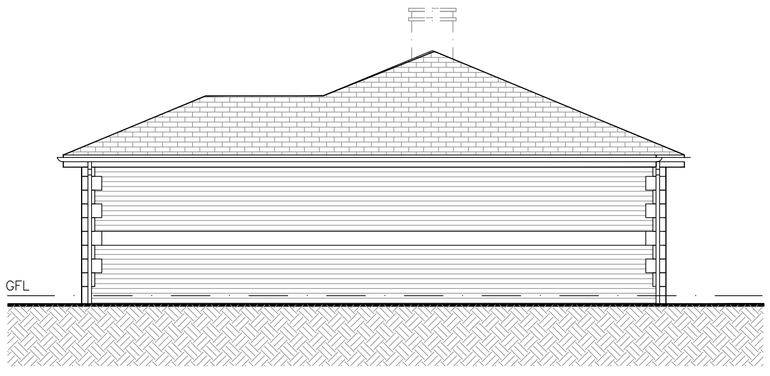

~~PROPOSED SIDE ELEVATION~~



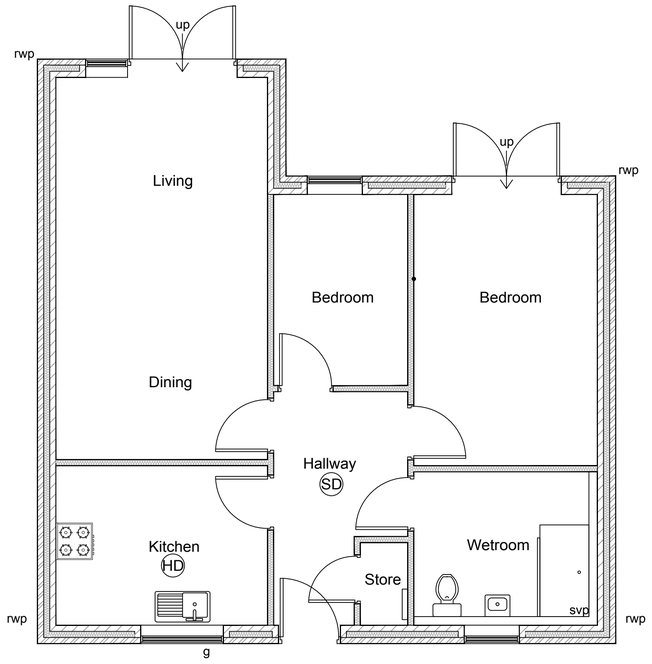

PROPOSED FLOOR PLAN

FOREFRONT
DEVELOPMENT CONSULTING
4 Ridge House, Ridge House Drive, Festival Park, S-O-T. ST1 5SJ
Office 01782 216912 WWW.FOREFRONTDC.UK

CLIENT

CARSON POWELL CONSTRUCTION LTD

PROJECT

Proposed removal of chimneys to new dwellings at Bagnall Heights, Bagnall, Staffs.

TITLE

BLOCK 1 - Plot 1

Proposed Floor Plans and Elevations

SCALE	DRAWN
1:50 @ A1	ATG
DRG NO.	DATE
18-109-23	04 / 12 / 18

REV.	DESCRIPTION	DATE

The contents of this drawing are the copyright of Forefront Development Consultng .