
Copyright: of this drawing is vested in the Architect and it must not be copied or reproduced without consent. **Approval**: *This drawing is issued for Planning purposes only. Please note that paper prints of this drawing may not be an accurate reproduction of the given scale. Key dimensions are noted for reference.* Unless marked as such drawing should not be used for Construction purposes. Detailed setting out drawings will need to be supplied for Tender and Construction purposes. Figured **dimensions only** are to be taken from this drawing.
All Dimensions and Levels are to be checked on site, prior to commencement. All contractors are to be responsible for taking and checking all dimensions relative to their work. Dimensions are in millimetres unless otherwise stated. bpArchitecture are to be advised of any variation between drawings and site conditions. This drawings is to be read in conjunction with all other consultant's drawings, specifications and schedules.....IF IN DOUBT ASK

Rev.	Drawn	Comments	Date
A	MQ	Existing Elevations overlaid with Materials images to show extent of materails construction	4/3/19

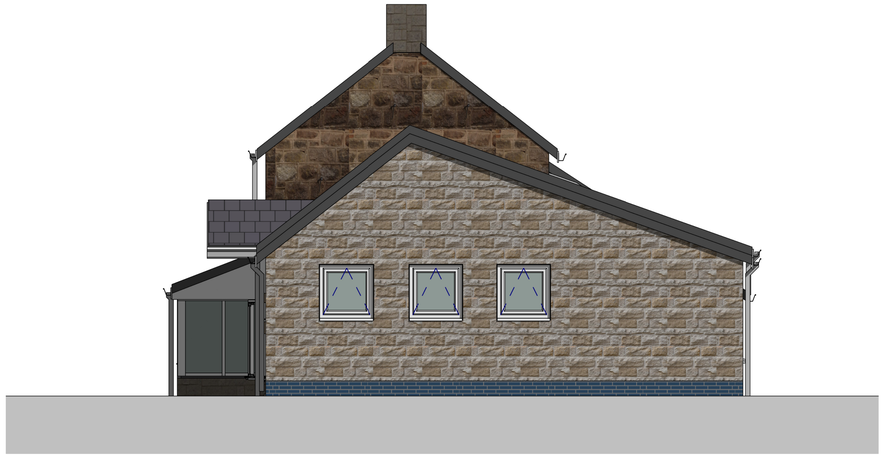

East Elevation as Existing
1 : 50



West Elevation as Existing
1 : 50

0 1 2 3 4 5
GRAPHIC SCALE: 1:50

Approval: This drawing has been prepared soley for the purposes of obtaining either Planning Consent, or Building Regulation Approval.
Do not use this drawing for Construction unless marked 'For Construction' it may be necessary to augment/amend the drawing for Construction purposes.

CDM: Work must not start on site before a Construction Phase Health and Safety Plan is in place (if applicable). Client is responsible for ensuring that a Principal Designer and/or Principal Contractor has been appointed and the Health and Safety executive have been notified (for projects which will involve more than 500 person days and/or will last more than 30 working days on site).

bp Architecture
☎ 01782 515 555
✉ Enquiries@bpArchitecture.co.uk
www.bparchitecture.co.uk
93 High Street Biddulph Staffs ST8 6AB
Architects : Interior Architecture : Conservation : Landscape

Client
Mrs Cuncannon-Edwards

Project
Crickets Farm
Wetley Rocks
ST9 0BN

Title
As Built East & West Elevations

As Currently Built

Status **RIBA Stage 3: Planning**

Date **Mar 2019** Drawn **MJQ**

Scale @A1 **1 : 50** Checked **Checker**

Project No 19-002 Drawing No. AS(0)05 Rev A

A1 File Ref: BPA\

A1