




West Elevation

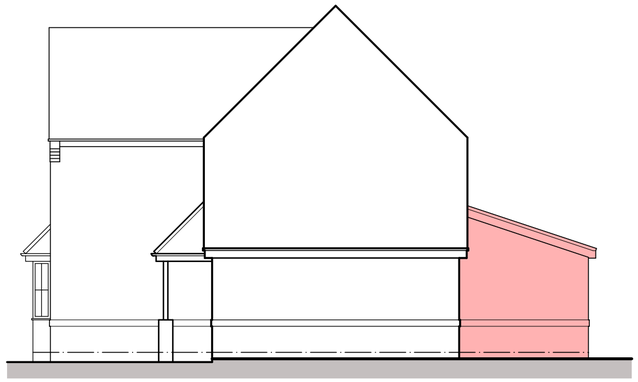

North Elevation

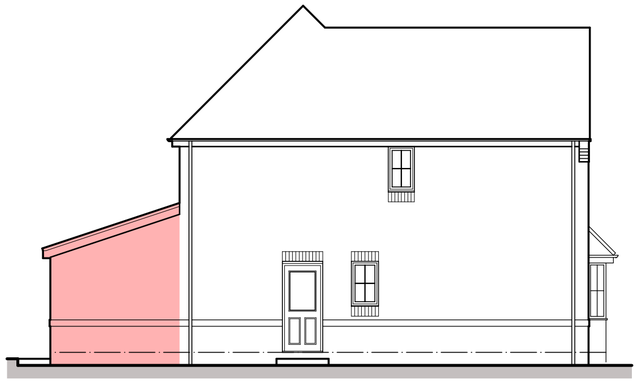

South Elevation

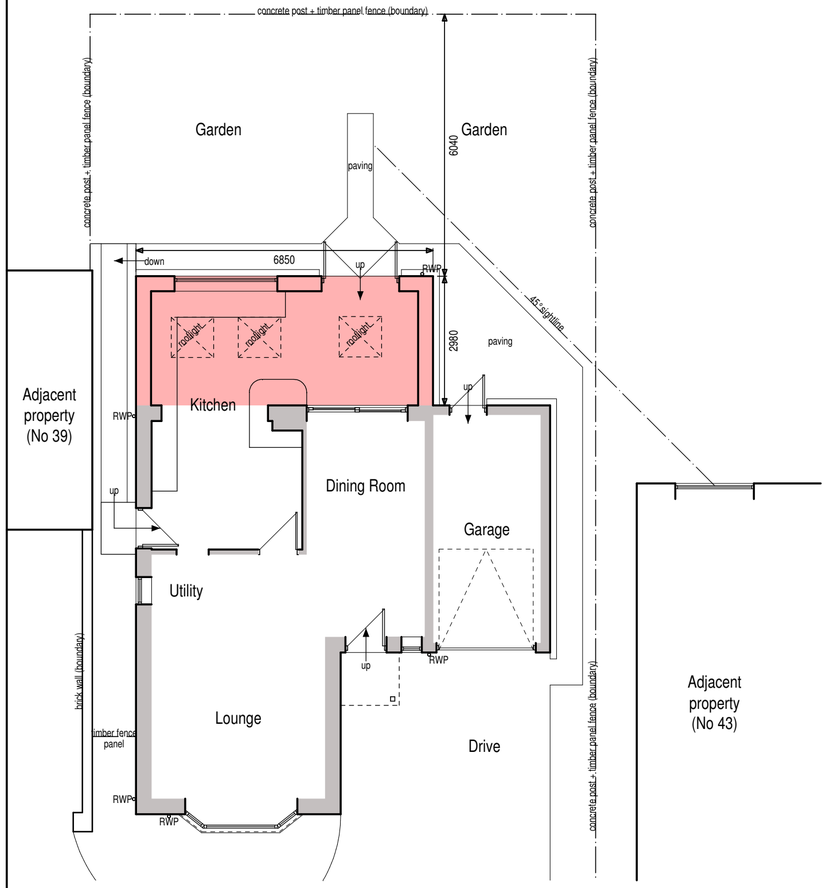

Ground Floor Plan

KEY

CLUD single storey extension



scale bar @ 1:100

Mr & Mrs Fletcher

CLUD APPLICATION FOR SINGLE STOREY REAR EXTENSION AT
41 MILLBROOK GARDENS,
BLYTHE BRIDGE,
STOKE-ON-TRENT, ST11 9JQ

AS-BUILT
FLOOR PLAN + ELEVATIONS

Date	Sheet	Scale
MAY 2019	A2	1:100
Drg No.	Rev.	Drawn
2019-2423-01	A	NAW

A - 22/07/2019 - TITLE SHEET AMENDED. EXTENSION HIGHLIGHTED.

SAMMONS Architectural LIMITED
Chartered Institute of Architectural Technologists Registered Practice
10 Cawdry Buildings, Fountain Street, Leek. ST13 6JP
Telephone: 01538 386002
E-mail: info@sammonsltd.co.uk
Web: www.sammonsltd.co.uk

This drawing is copyright.
All dimensions must be checked prior to commencement.