EXISTING SITE PLAN SHOWING DRAINAGE AS-BUILT

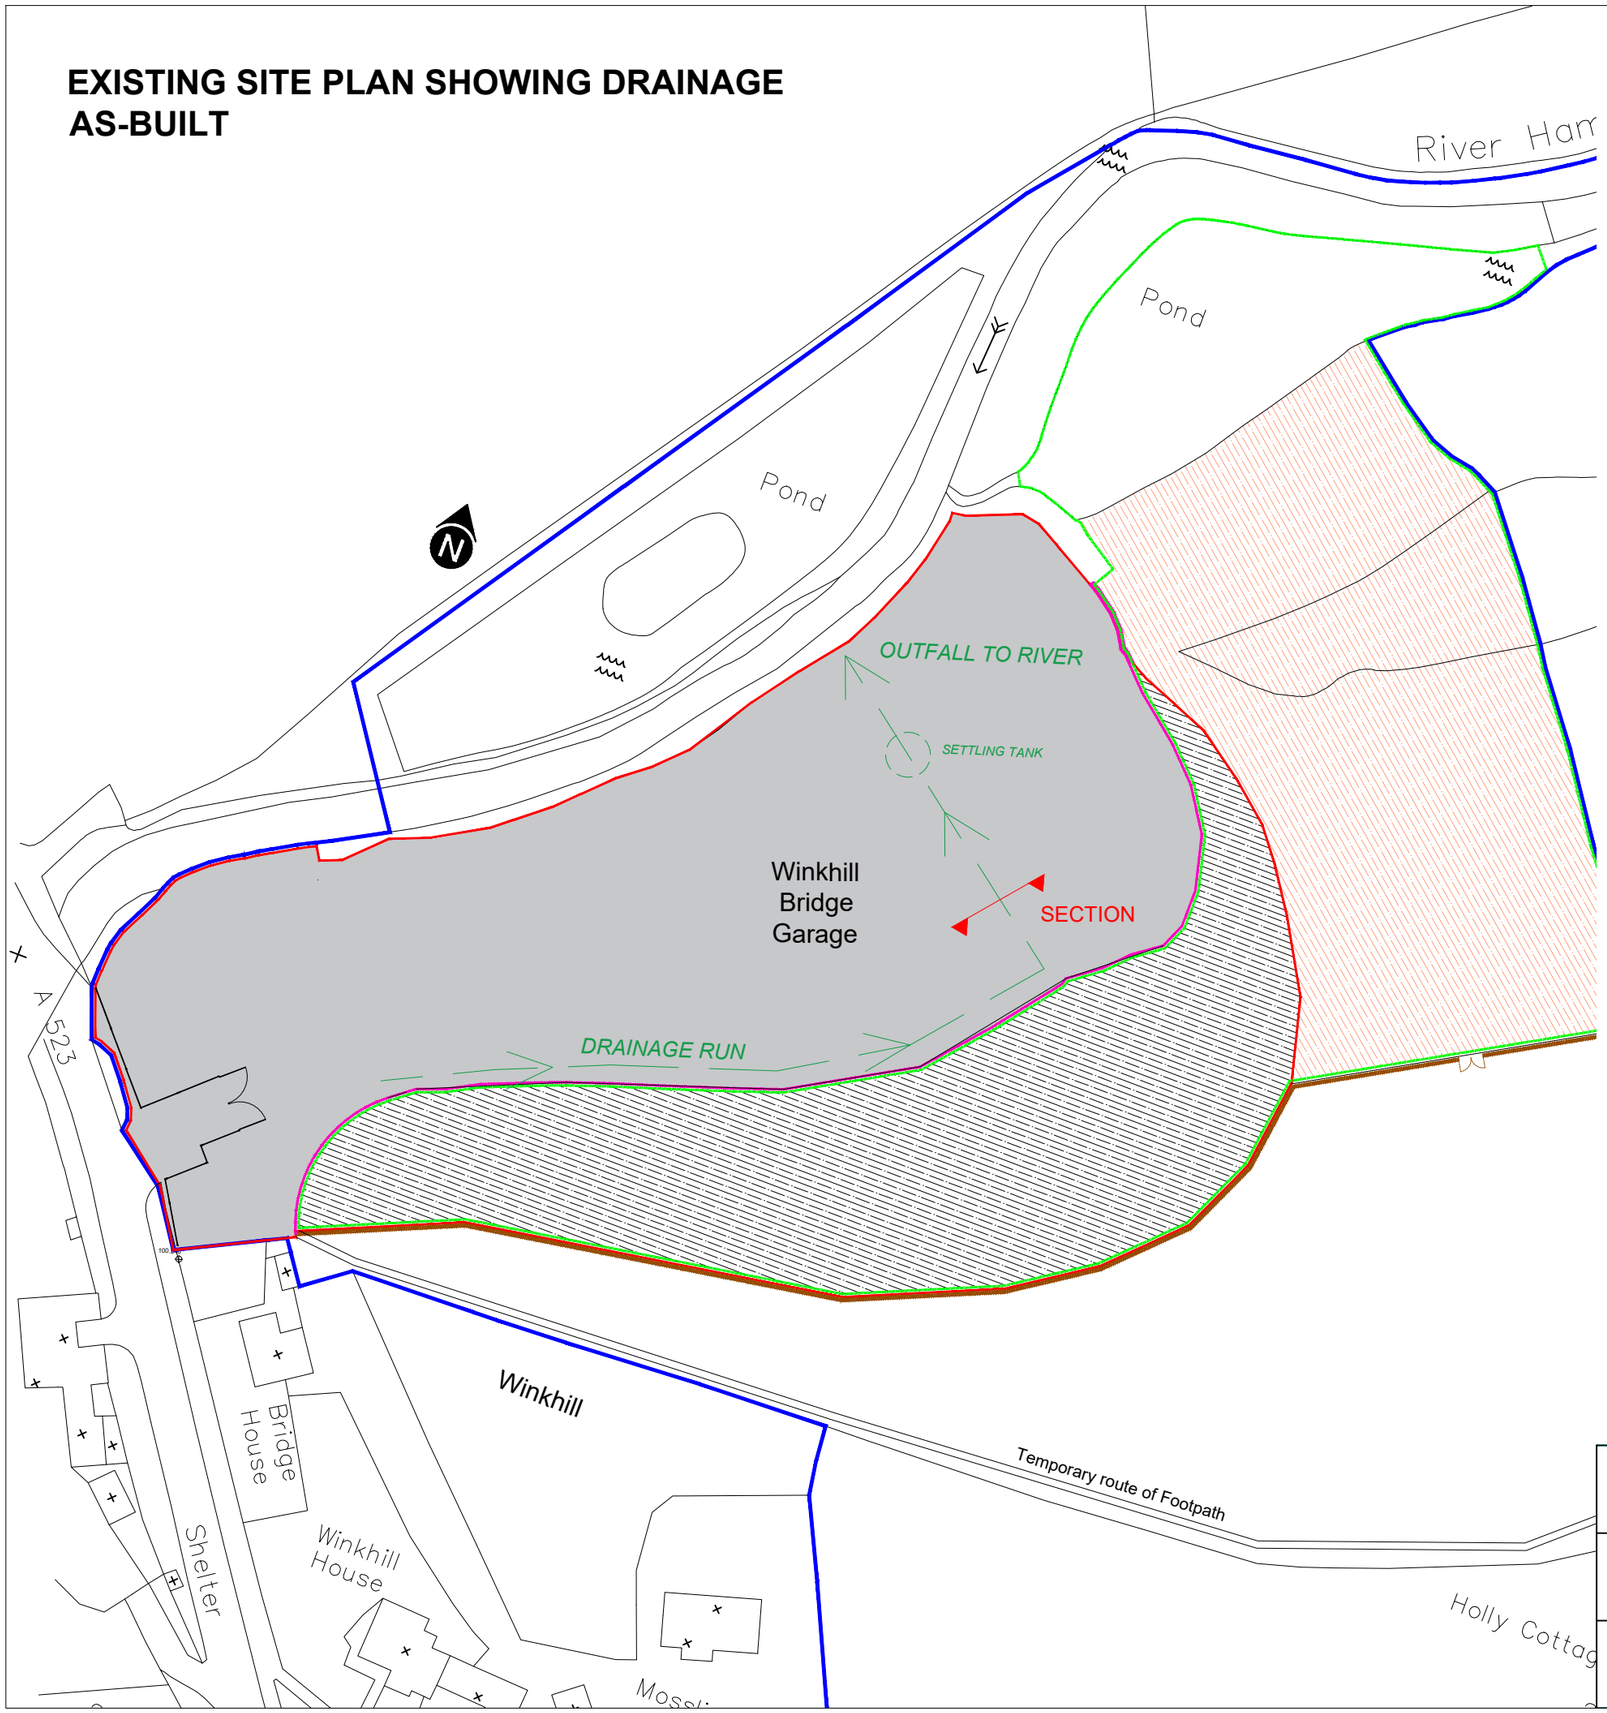

DRAINAGE SECTION (1:10)

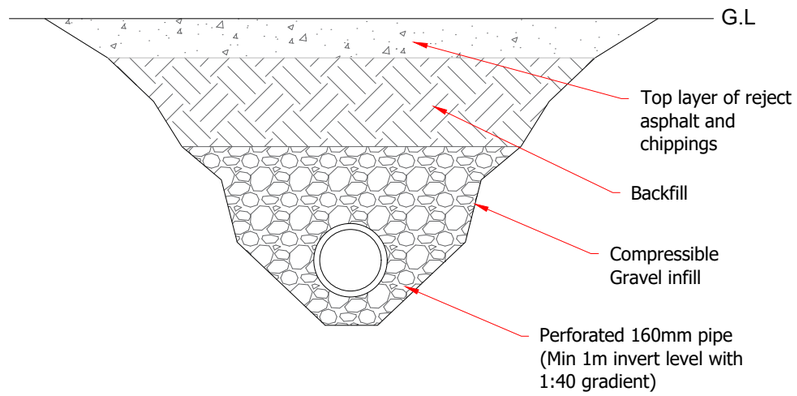



On-site drainage works have been approved by the Environmental Agency.

Client: WG Tanker Group	Drawing No: TWP19-WG-004
	Revision:
Contract: Winkhill New Tanker Depot	Date: July '19
	Scales: 1:1000 @ A3
Drawing: Site Drainage	Drawn: ML
	Checked: SC

the winter partnership
chartered building surveyors
property consultants
7 Alma Field
Castle Cary
BA7 7JD
E: scooper@winterpartnership.co.uk