




SECTIONAL ELEVATION F:F
(SOUTH-WEST)

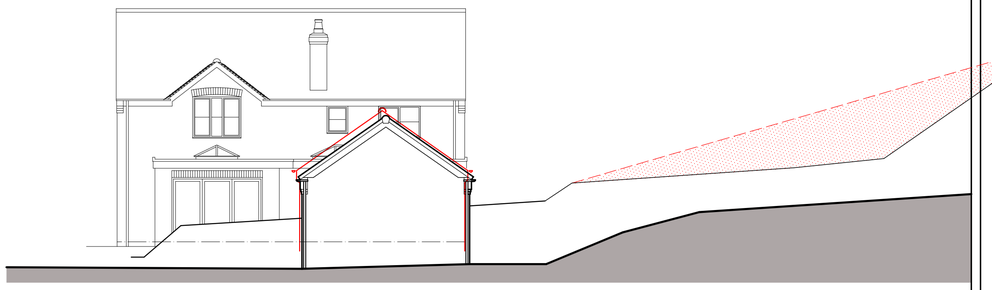


SECTIONAL ELEVATION D:D
(SOUTH EAST)

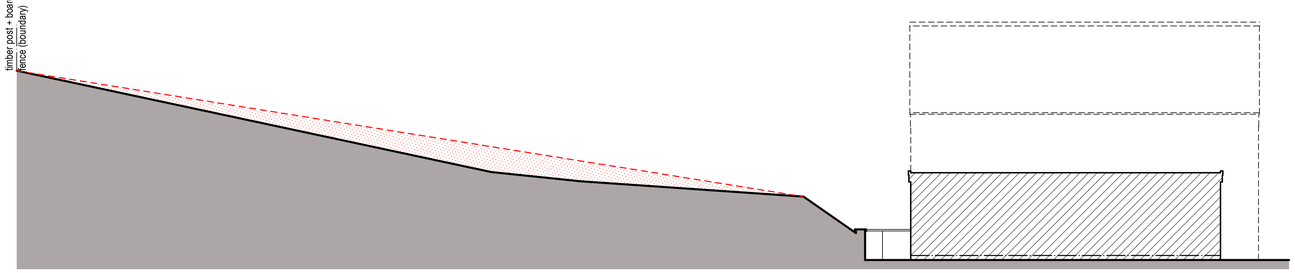


SECTIONAL ELEVATION B:B
(NORTH-WEST)

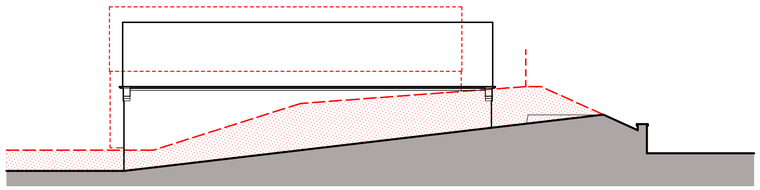


SECTIONAL ELEVATION E:E
(NORTH-EAST)

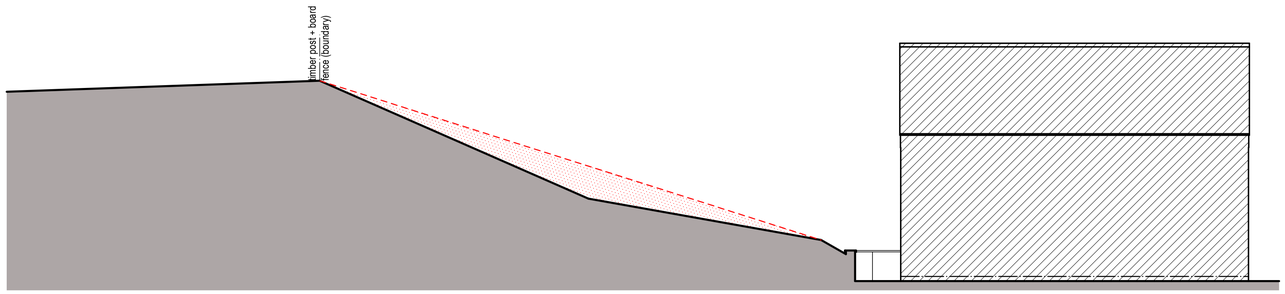

SECTIONAL ELEVATION A:A
(NORTH-WEST)

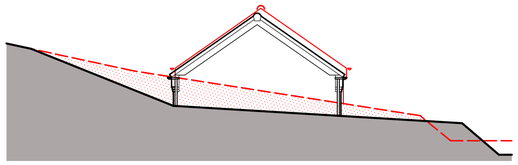

SECTIONAL ELEVATION C:C
(NORTH)

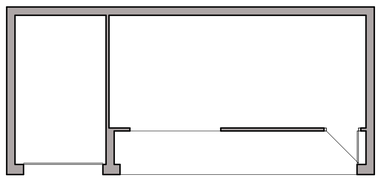

FLOOR PLAN

KEY

Original proposed ground level (long dashed line)

Original proposed building outline (solid line)

0.0m 1.0m 2.0m 3.0m 4.0m 5.0m

scale bar @ 1:100

Mr & Mrs Mellor

RETROSPECTIVE APPLICATION FOR
RETENTION OF STABLE BLOCK +
GROUND LEVEL ALTERATIONS
MOONWOOD, CHEDDLETON ROAD,
BIRCHALL, LEEK,
STAFFS, ST13 5QZ

AS BUILT
FLOOR PLAN + SECTIONAL ELEVATIONS

Date	Sheet	Scale
JANUARY 2020	A1	1:100
Drg No.	Rev.	Drawn
2017-2285-11	A	NAW

A - 03/02/2020 - FLOOR PLAN SHOWN ON DRAWING FOLLOWING VALIDATION COMMENTS.

SAMMONS LIMITED Architectural
Chartered Institute of Architectural Technologists Registered Practice

10 Cawdry Buildings, Fountain Street, Leek. ST13 6JP
Telephone: 01538 386002
E-mail: info@sammonsltd.co.uk
Web: www.sammonsltd.co.uk

This drawing is copyright.
All dimensions must be checked prior to commencement.