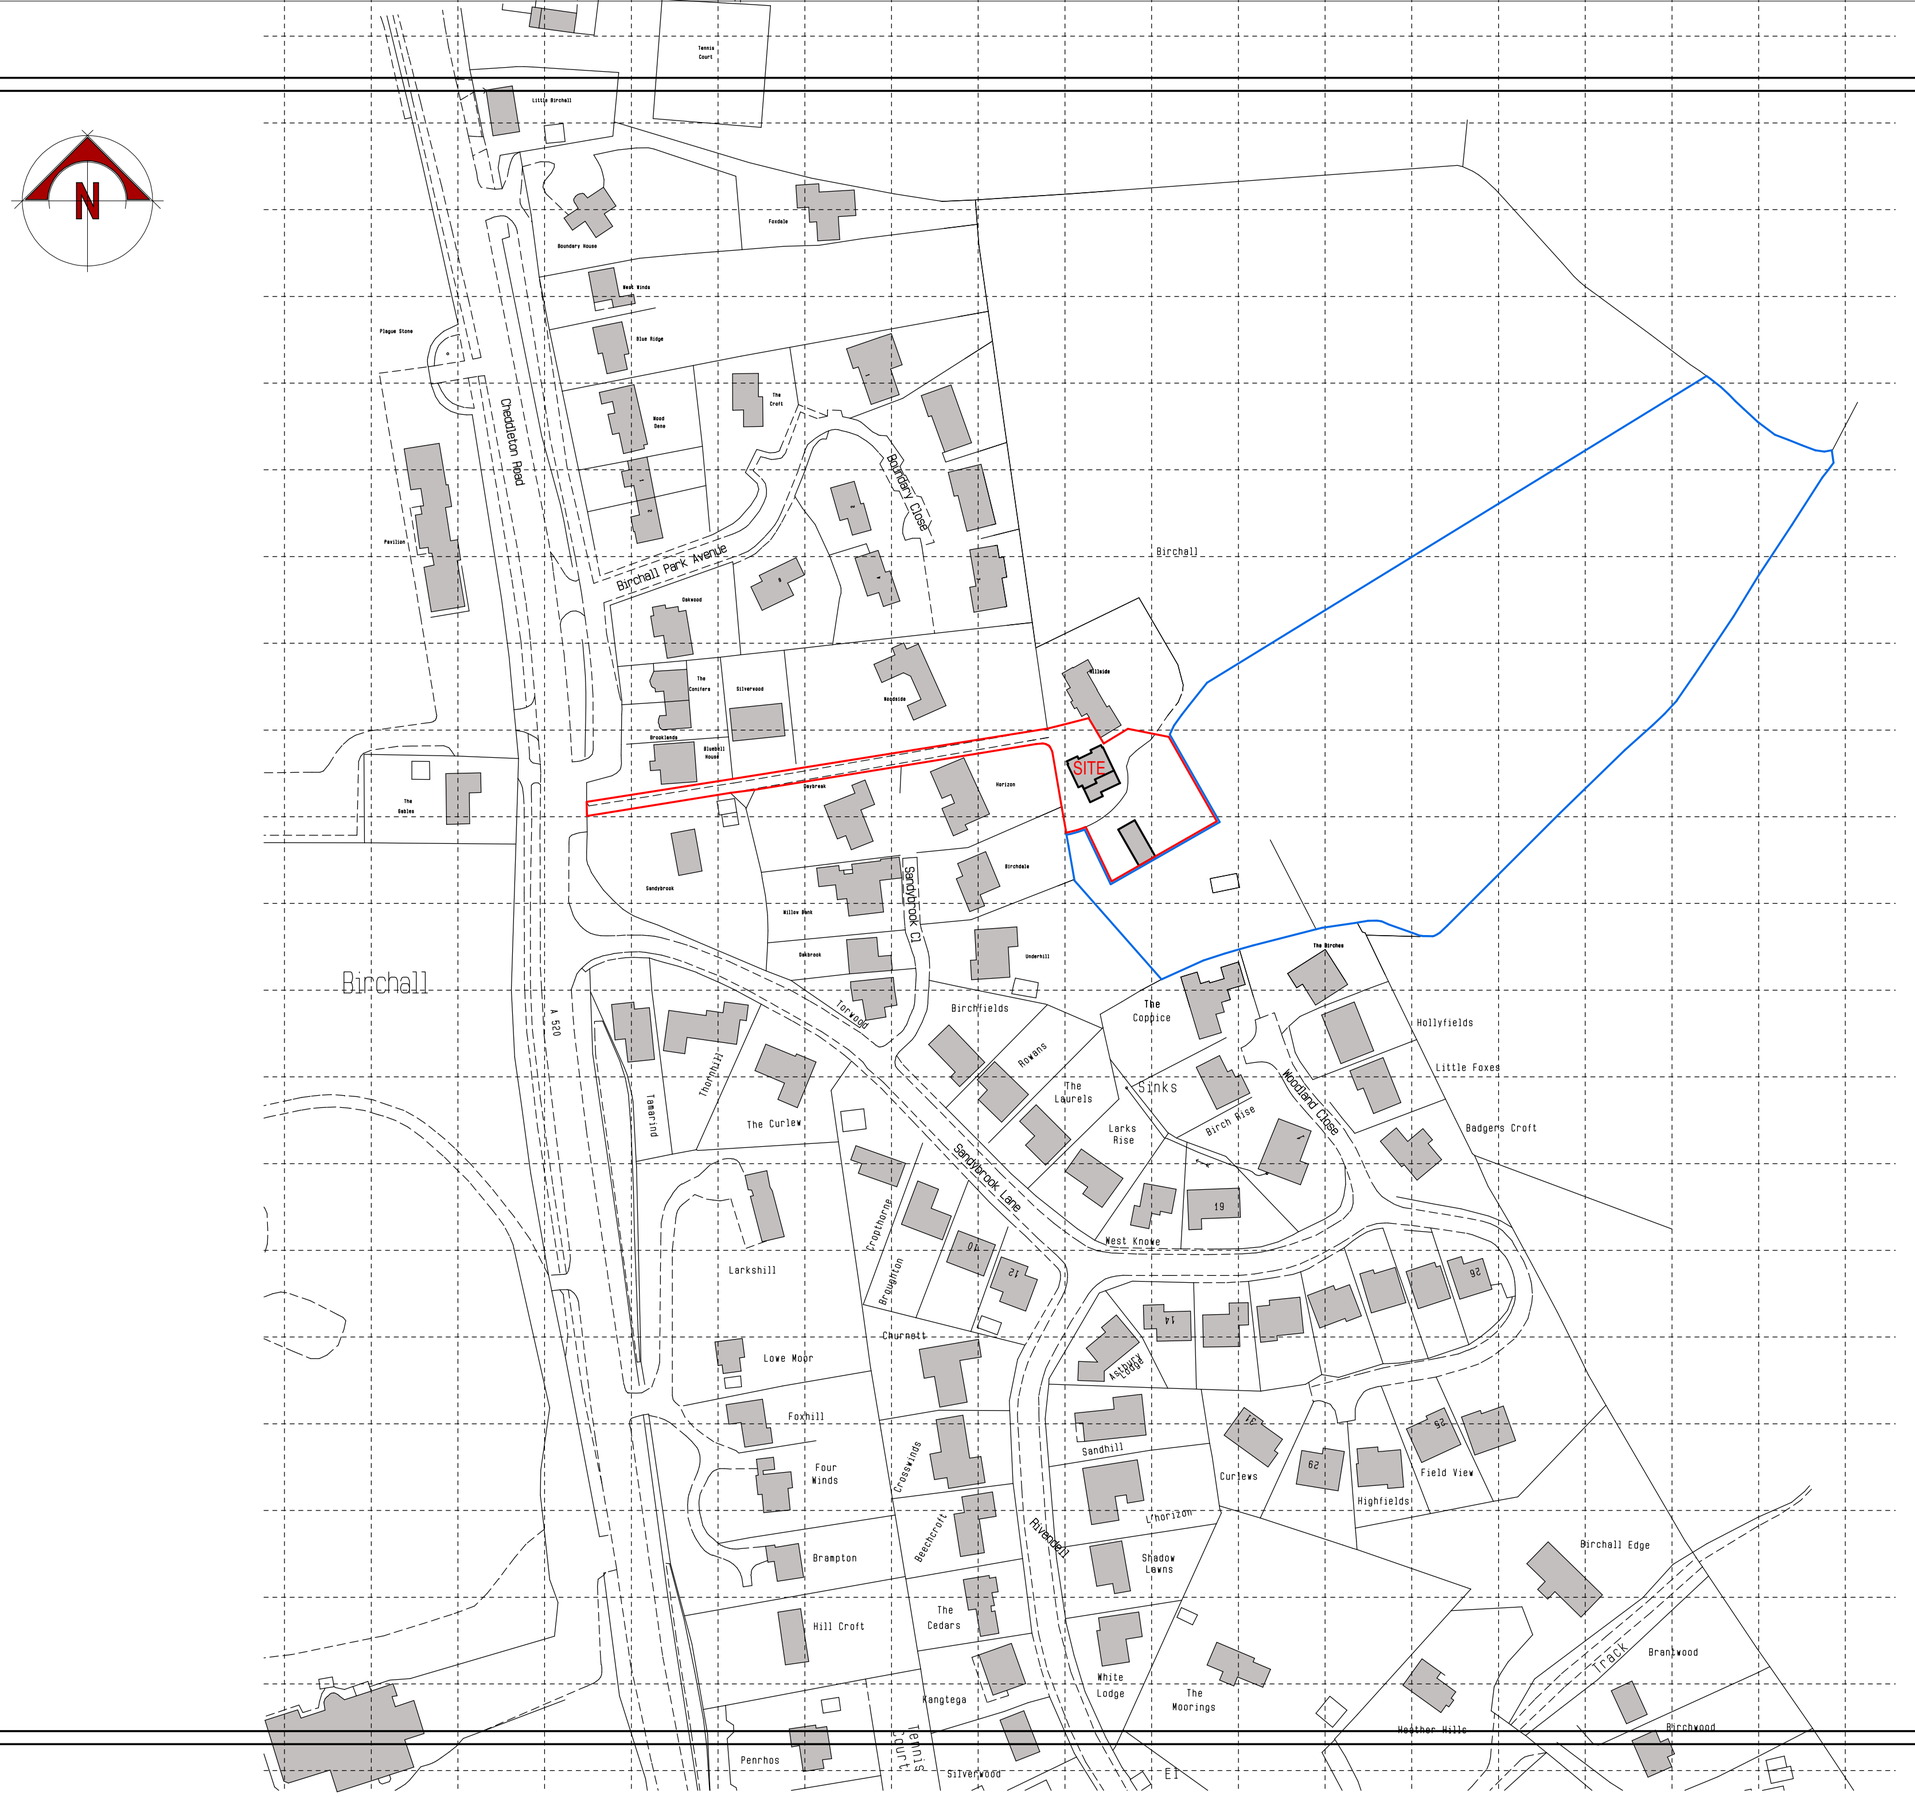


© Crown Copyright 2009. All rights reserved.
Licence number 100020449

0.0m 10.0m 20.0m 30.0m 40.0m 50.0m

scale bar @ 1:1250

Mr & Mrs Mellor

RETROSPECTIVE APPLICATION FOR RETENTION OF STABLE BLOCK + GROUND LEVEL ALTERATIONS
MOONWOOD, CHEDDLETON ROAD, BIRCHALL, LEEK, STAFFS, ST13 5QZ

AS BUILT LOCATION PLAN

Date	Sheet	Scale
JANUARY 2020	A2	1:1250
Drg No.	Rev.	Drawn
2017-2285-12	-	NAW

SAMMONS Architectural LIMITED
Chartered Institute of Architectural Technologists Registered Practice
10 Cawdry Buildings, Fountain Street, Leek. ST13 6JP
Telephone: 01538 386002
E-mail: info@sammonsltd.co.uk
Web: www.sammonsltd.co.uk

This drawing is copyright.
All dimensions must be checked prior to commencement.