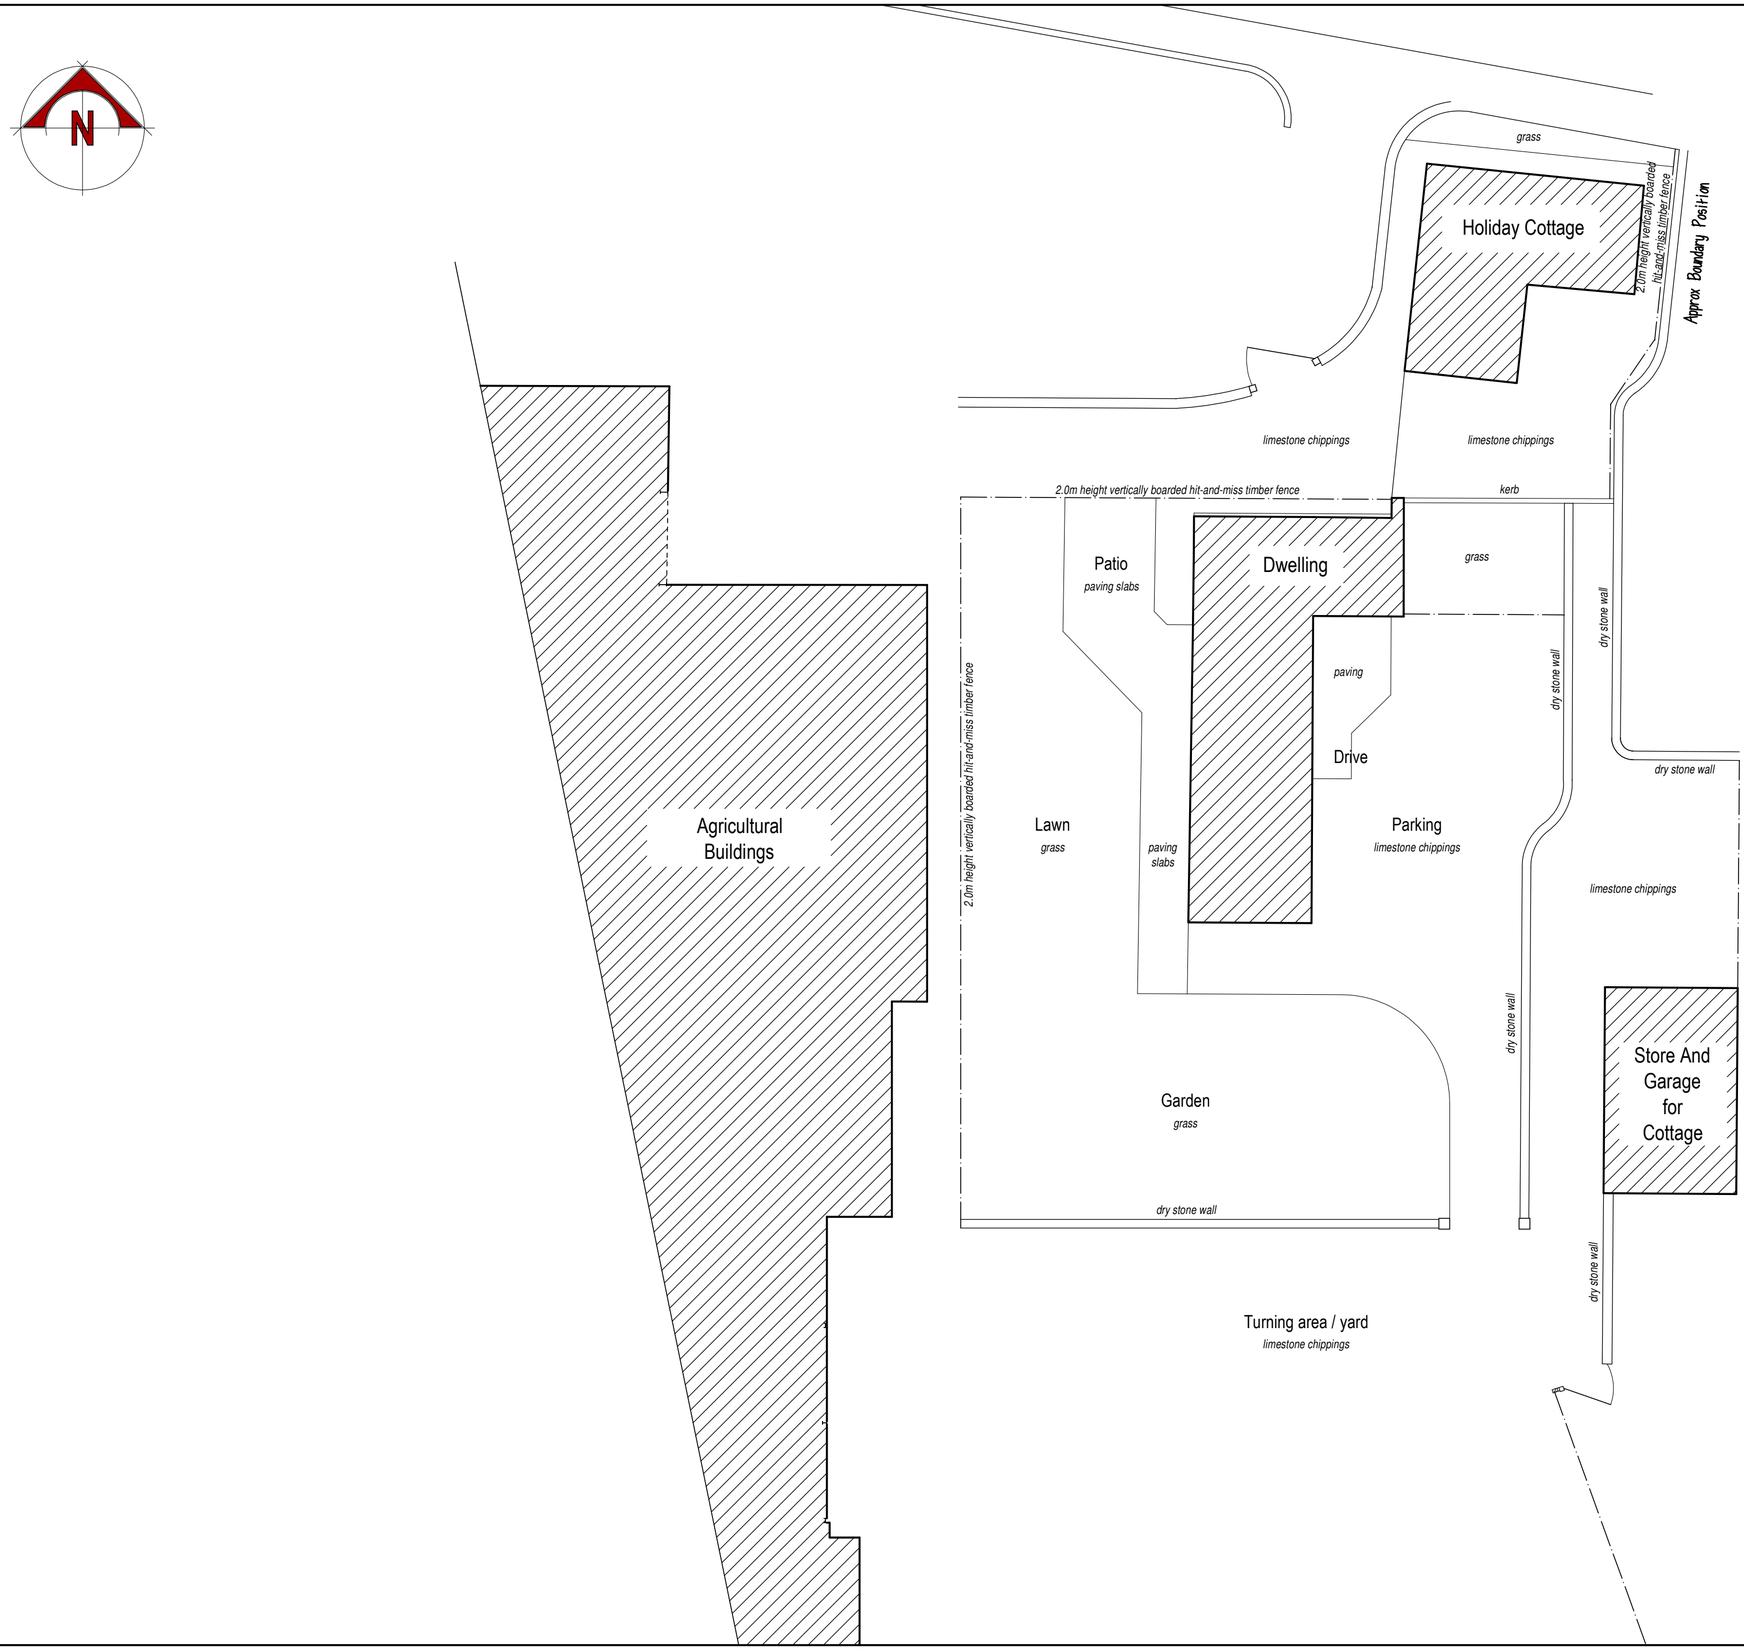

0.0m 5.0m 10.0m

scale bar @ 1:200

Mr D. Salt

CALTONMOOR HOUSE FARM,
SWINSCOE,
NR ASHBOURNE,
STAFFS.

PLANNING CONDITIONS
AS BUILT SITE PLAN

Date	Sheet	Scale
JANUARY 2020	A2	1:200
Drg No.	Rev.	Drawn
2016-2167-06	-	NAW

A -

SAMMONS Architectural LIMITED
Chartered Institute of Architectural Technologists Registered Practice
10 Cawdry Buildings, Fountain Street, Leek. ST13 6JP
Telephone: 01538 386002
E-mail: info@sammonsltd.co.uk
Web: www.sammonsltd.co.uk

This drawing is copyright.
All dimensions must be checked prior to commencement.