


North-East Elevation

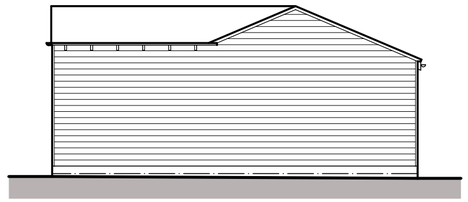

North-West Elevation

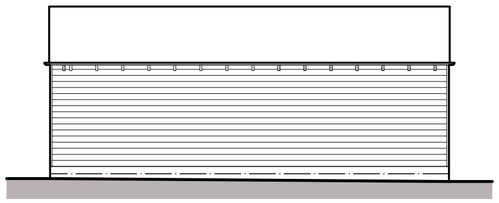

South-West Elevation

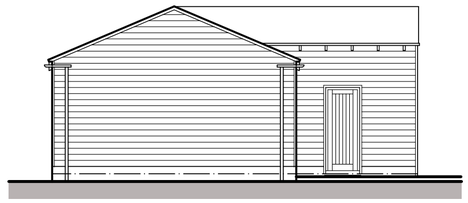

South-East Elevation

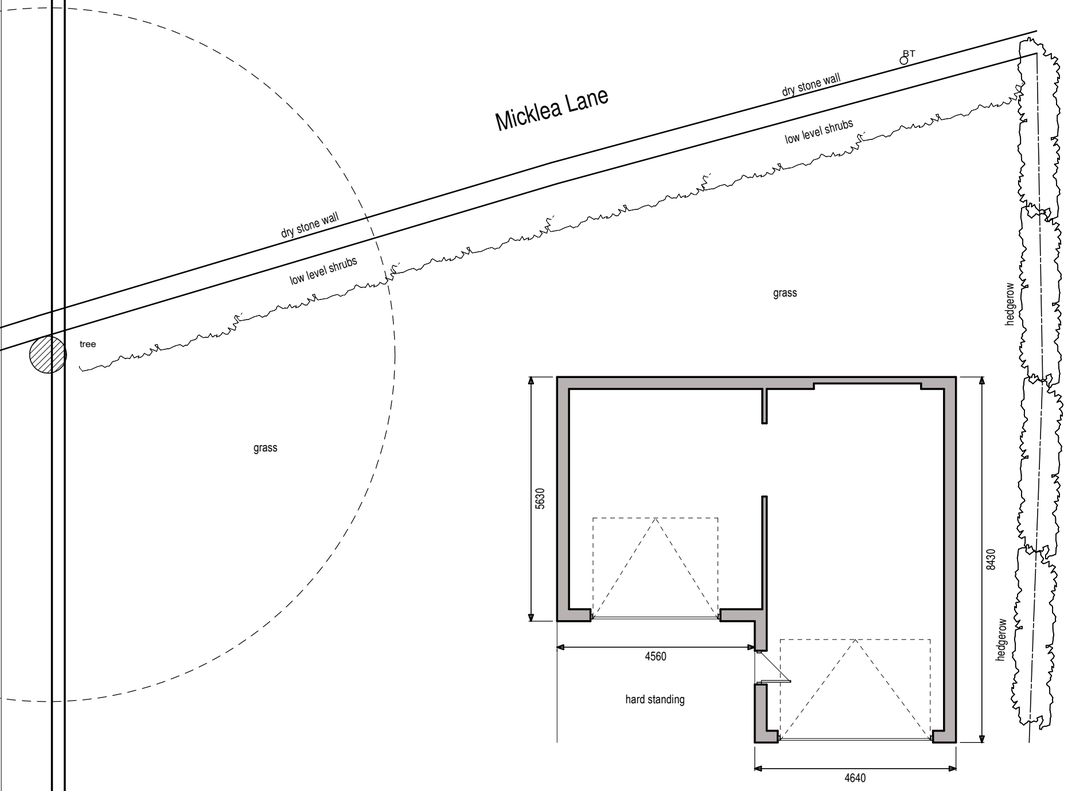


Floor Plan

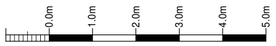


scale bar @ 1:100

# Mr Jones

PROPOSED RETROSPECTIVE PLANNING APPLICATION AT MICKLEA FARM, MICKLEA LANE, LONGSDON STOKE-ON-TRENT, ST9 9QA

PROPOSAL SCHEME - AS BUILT FLOOR PLAN + ELEVATIONS

| Date | Sheet | Scale |
|---|---|---|
| DECEMBER 2019 | A2 | 1:100 |
| Drg No. | Rev. | Drawn |
| 2019-2468-01 | A | NAW |

A 12/2/2020 DRAWING TITLE CHANGED

SAMMONS Architectural LIMITED
Chartered Institute of Architectural Technologists Registered Practice

10 Cawdry Buildings, Fountain Street, Leek. ST13 6JP
Telephone: 01538 386002
E-mail: info@sammonsltd.co.uk
Web: www.sammonsltd.co.uk

This drawing is copyright.
All dimensions must be checked prior to commencement.