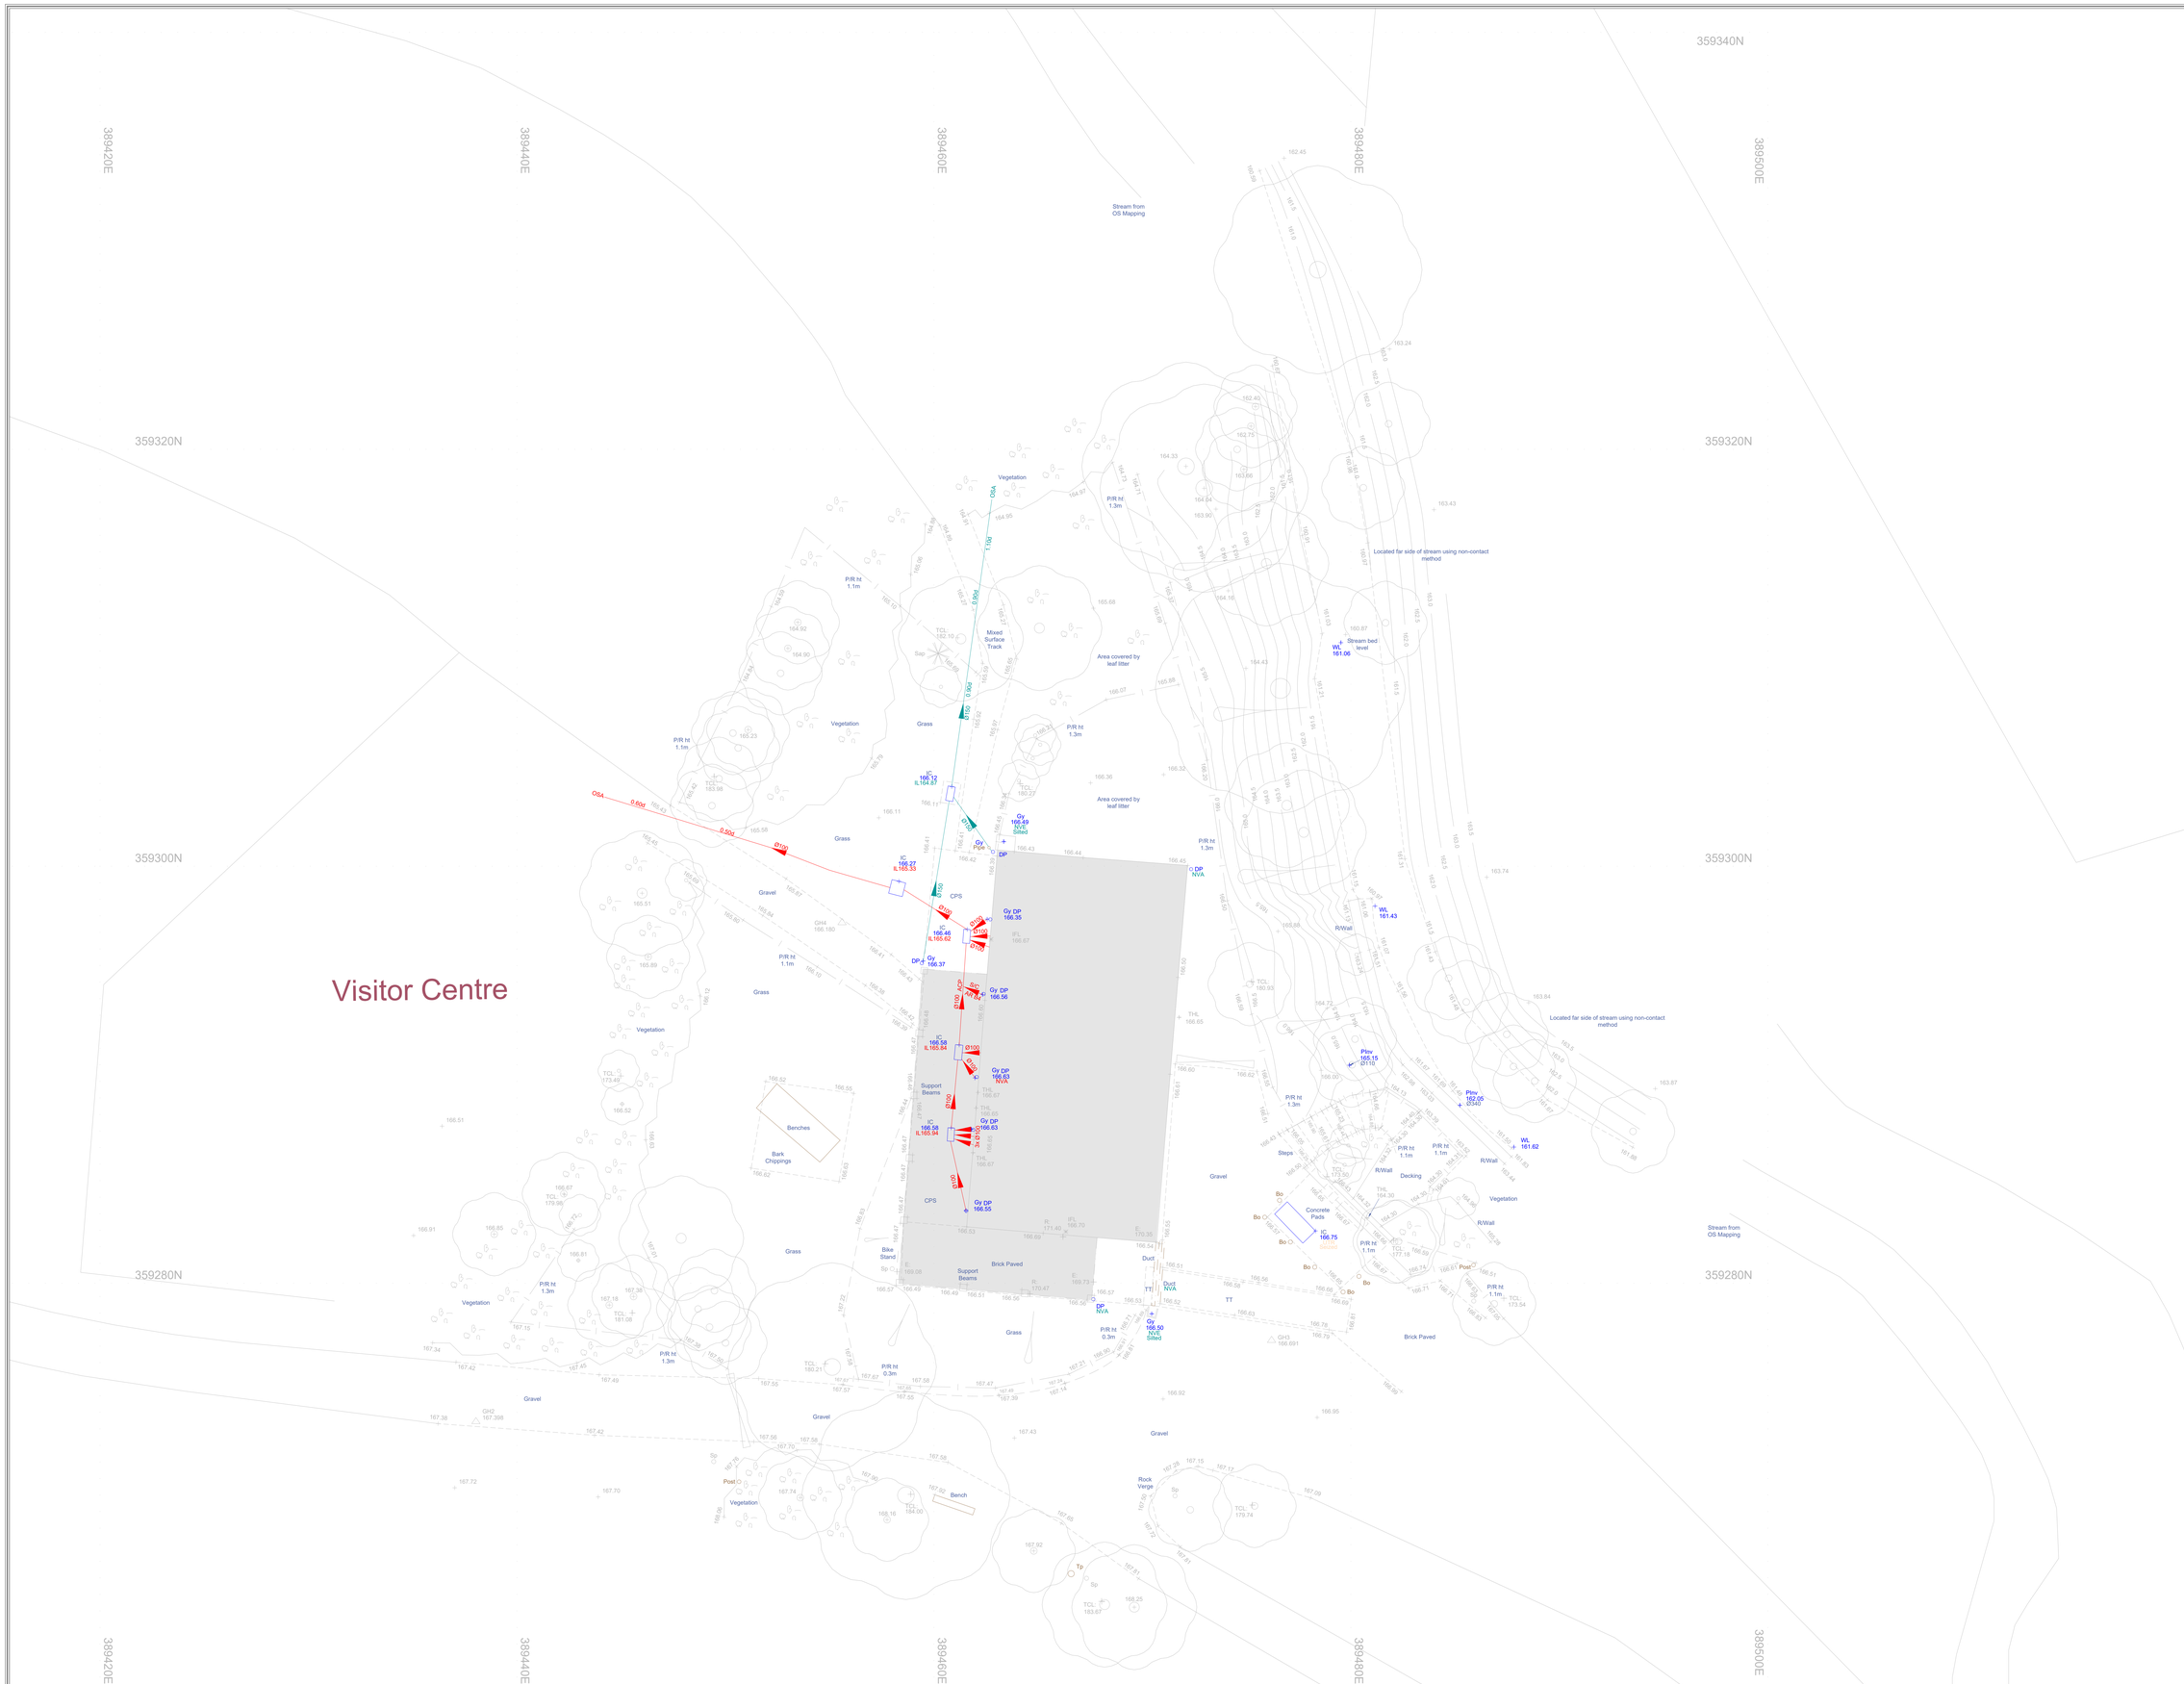

N

NOTES:

1. *In all cases please call the 811 Dial before you dig service to mark their own plant before any site works commence. 0800 917 0890*
   Always consult utility plans
2. *Drainage information provided has been determined without man entry into the chambers. Whilst every effort has been made to correctly identify the duty/assist/overflow/ relief, it is recommended that this information should be checked in areas that are critical to the future pipe/plant/equipment.*
3. *Pipe sizes are to be confirmed but straight line connections between chambers unless proven otherwise by the use of a survey or CCTV survey.*
4. *All desktop information should be treated as historical as the buried assets present might have changed since the drawing/record was last updated.*

UTILITY LINETYPES

BT Line		Electric Low Voltage	
British Telecom		Electric High Voltage	
Electric - Overhead		Electric - Unknown Voltage	
ESTI Cable Television		Fibre Optic Overhead	
Communication Cable		Fibre Optic	
Drainage - Combined Water		Fuel Line	
Drainage - Foul Water		Gas Line	
Drainage - Storm Water		Gaspipe Line	
Drainage - Unknown Water		GPO Line	
Drainage - Combined Water - Abandoned		Heating Pipe	
Drainage - Combined Water - Approved PTR		Mains Water	
Drainage - Foul Water - Abandoned PTR		Oil Pipe	
Drainage - Storm Water - Abandoned PTR		Rising Main	
Drainage - Unknown Water - Abandoned PTR		Telecom	
Drainage - Combined Water - Approved PTR		Traffic Light Signals	
Drainage - Approved Rain Run-Off Drainage		Vacuum	
Earth Cable		Vehicular	
Empty Duct		Vapour Recovery	
Electric to Ground		Vent Line	
		Water	

UTILITY SURVEY INFORMATION

Contractor Survey Area		Assumed Route	AR
Credit for Trial Hole Not Dug	C.H.N.D.	Bend/Change of Direction	BCD
Area of Trace / Beyond	EOT	Buried Connection	BC
Head of Run	HoR	Buried Stopcock	BVS
Road Signal	RSI	No Visible Access	BVA
Trial Hole Records	THR	No Visible Fuel	NVF
Off Survey Area	OSA	No Visible Services	NVS
Bank Drop	BD	No Visible Water	NVW
Kill Level	TL	No Depth Indicated	NDI
Pole Cable	PL	Water Level	WL
Visible Overhead	OHL	High Level	HL
Visible Ground	VG	Low Level / Top of Valve	TL of V / T.o.V.
Visible in Survey	VIS	Liquid Level	LL
Visible in Survey (Water)	VISW	Rubble Level	RL
Visible in Trace	VIT	No Signal	NVS
		Assumed Water	AW
Visible in Survey		Approximate Location	~
		GPR Anomaly	
Chamber Exterior		Multiple Services Route	

LEGEND

Buildings	Overhead Cable	IC	Inspection chamber	Bo	Bollard
Wall	Concrete edge	Pinv	Pipe invert	Bl	Illuminated bollard
Kerb line	Tarmac edge	Gy	Gully	Bin	Rubbish bin
Line marking	Grass verge	Rg	Back gully	Vp	Vent pipe
Drop kerb	Unpaved/Gravel	Dp	Down pipe	Gri	Ground light
Centre line	Verge	Pipe	Pipe above ground	Ldox	Letter box
Top of bank	Bottom of bank	MH	Manhole	Strap	Tree Stump
100.000	Station and Name	WL	Water level	Sty	Stile
	Station Level	Fl	Flood light	IFL	Internal floor level
	Tree / Bush / Sapling	Lp	Lamp post	THL	Threshold level
	Area of Underground	Tp	Telegraph post	Sp	Sign post
	Woodland	Ep	Electricity post	TH	Traphole
R	Ridge Level	Tl	Traffic light	BH	Borehole
E	Eaves Level	Bus	Bus stop	ELC	Electric
F	Flat Roof Level	Sv	Stop valve	BT	British Telecom
	Gate	Sl	Stop tap	Chse	Cranked bus
Fence types:	Intersection	Er	Earth rod	TT	Tactile
HH	Iron Railings	Wm	Water meter	BP	Brick paved
WM	Wire Mesh	Gas	Gas valve	CPS	Concrete paving slabs
PAR	Post & Rail	Av	Air valve	CVR	Cover
PW	Post & Wire	IDJ	Unidentified inspection	Kwall	Retaining wall
CL	Chain Link	Wo	Wash out	THL	Top of Wall Level
WP	Wooden Panels	Re	Rodding eye	TCL	Tree canopy level
CB	Close Boarded	BB	Bedine beacon	G	Gate
RIP	Steel Palisade	CTV	Cables to	MQ	Multi gate
		Mkr	Marker post	IC	Inspection Chamber
		Gmkr	Gas marker post	CL	Cover level
		Sn	Soffit	IL	Invert level
		Fh	Fire hydrant	UTL	Unable to locate

PAS 128 : 2022 LEVEL B SURVEY

QUALITY LEVEL	CRITERIA USED IN THE DETERMINATION OF QUALITY LEVEL	LOCATION ACCURACY
QL-D	A UTILITY SEGMENT WHICH IS SUSPECTED TO EXIST, EITHER ON AS-BUILT RECORDS OR FROM THE INTERPRETATION OF TRACES OF SUCH AS-BUILT RECORDS. **OR DETECTED ELSEWHERE**	**UNKNOWN**
QL-C(VERT)	HORIZONTAL LOCATION ONLY OF THE UTILITY SEGMENT DETERMINED BY SURVEY, PARTIAL OR COMPLETE (+/-) **(HSE, DN GPR DETECTION WITH LIMITED CONFIDENCE IN DEPTH)**	**+/- 500mm HORIZONTAL LOCATE UNKNOWN VERTICAL LOCATE**
QL-B(VERT)	HORIZONTAL & VERTICAL LOCATION OF THE UTILITY SEGMENT BY SURVEY **(HSE, DN GPR DETECTION WITH CONFIDENCE IN DEPTH)**	**+/- 500mm HORIZONTAL LOCATE +/- 50% VERTICAL LOCATE**
QL-B(SVD)	POSITION AND DEPTH OF THE UTILITY DETECTED BY SURVEY, PARTIAL OR COMPLETE (+/-) **(HSE, + GPR DETECTION)**	**+/- 100mm HORIZONTAL LOCATE +/- 10% VERTICAL LOCATE**

DISCLAIMER

Whilst every effort has been taken in the preparation of this drawing, the original land marks/apparatus configuration may have been altered since the survey/drawing was produced. The user shall make further enquiries and investigations to satisfy himself as to the accuracy of this drawing and position of the apparatus. The exact positions of the apparatus should be verified by the use of suitable detection devices and safe digging practices in accordance with HSG47, further advice on the location of apparatus should be recommended by the owner. No representation is made by Greenhatch Group, its agents or servants as to the accuracy, completeness, and correctness or otherwise of this drawing and the position of the apparatus.
All apparatus shall be treated as live unless proved otherwise by the owner. It is the users responsibility to ensure that the information on the location of apparatus is provided to all persons (either direct labour or contractors) working in proximity to the apparatus.

Rev.	Date	Description	Drawn	Q. Rev.

greenhatch group

- Topographical Surveys
- Site Engineering
- Utility / CCTV Surveys
- Measured Building Surveys
- 3D Laser Scanning
- Revit & BIM Models

Rowan House
Duffield Road
Little Eaton
Derby
DE21 5DR
Tel (01332) 830044 Fax (01332) 830055
admin@greenhatch-group.co.uk
www.greenhatch-group.co.uk

St Albans	Newcastle	London
Unit B, The Courtyard, Alban Park, St Albans, Hertfordshire, AL4 0LA	24 Riverside Studios, Amethyst Road, Newcastle Bus. Park, Newcastle-Upon-Tyne, NE4 7YL	27, Cornwall Terrace Mews, Regents Park, London, NW1 5LL
t. (01727) 854481	t. (01912) 736391	t. (02072) 241806

CLIENT
T.A.D Architects

PROJECT
Biddulph Country Park Cafe
ST8 7TZ

TITLE
Utility Survey

SCALE	DATE
A0@ 1: 100	02.11.23
DRAWN	QUALITY REF
JR	

Level datum	See OS Note
Grid orientation	See OS Note
Job number	48933
Drawing No.	Rev.
48933_T_UG	0

Comments
This plan should only be used for its original purpose. Greenhatch Group accepts no responsibility for this plan if supplied to any party other than the original client.
All dimensions should be checked on site prior to design and construction.
Drainage information (where applicable) has been visually inspected from the surface and therefore should be treated as approximate only.

Notes:

Copyright Greenhatch Group. 06/07/13