STAFFORDSHIRE
moorlands
DISTRICT COUNCIL
ACHIEVING · EXCELLENCE

Planning Service

MOORLANDS HOUSE, STOCKWELL STREET, LEEK, STAFFORDSHIRE
MOORLANDS. ST13 6HQ TEL: (01538) 483550 FAX: (01538) 483586

APR 2008

Householder Planning Application

Part 1

Please use this form if you intend to extend your house or to erect any other buildings or structures for domestic purposes within the boundary of your property.

Please read the notes on the reverse of this form before you complete it.

1. APPLICANT Name: Mr & Mrs D. Woolliscroft Address: 30 Green Lane Blythe Bridge Tel. No.: 01782 396311	**2. AGENT** Name: ..... Address: .... Tel. No.: .....
3. Address or location of proposed development.	30 GREEN LANE
4. Description of proposed development and the purpose for which it will be used.	CAR PORT TWO STORY EXTENSION TO SIDE AND REAR
5. Type and colour of external materials to be used for walls and roof.	TO MATCH EXISTING

6. Do you propose to: (Delete as appropriate)

i)	Demolish any buildings or structures?	YES/~~NO~~)	(If 'YES' show their position on your plans)	
ii)	Fell any trees or shrubs?	~~YES~~/NO)		
iii)	Construct a new access to a highway?	Vehicular ~~YES~~/NO	Pedestrian	YES/NO
iv)	Alter an existing access to a highway?	Vehicular ~~YES~~/NO	Pedestrian	YES/NO

7. Have there been any previous extensions to the dwelling since it was built? ~~YES~~/NO If 'YES' please give brief details:-

8. FORMAL APPLICATION
I/We hereby apply for planning permission to carry out the development described in this application and the accompanying plans.


Signed: D. Woolliscroft Date: 07-04-08

TOWN AND COUNTRY PLANNING ACT, 1990 : CERTIFICATE UNDER SECTION 65
CERTIFICATE A

I hereby certify that:-

1. No person other than the applicant was an owner of any part of the land to which the application relates at the beginning of the period 20 days before the date of this application.
2. None of the land to which the application relates is, or forms part of, an agricultural holding.
(Delete the whole of 2 if the site is an agricultural holding)
3. Signed: D. Woolliscroft Date: 07-04-08

Search Address: 30 Green Lane, Blythe Bridge, Stoke on Trent,

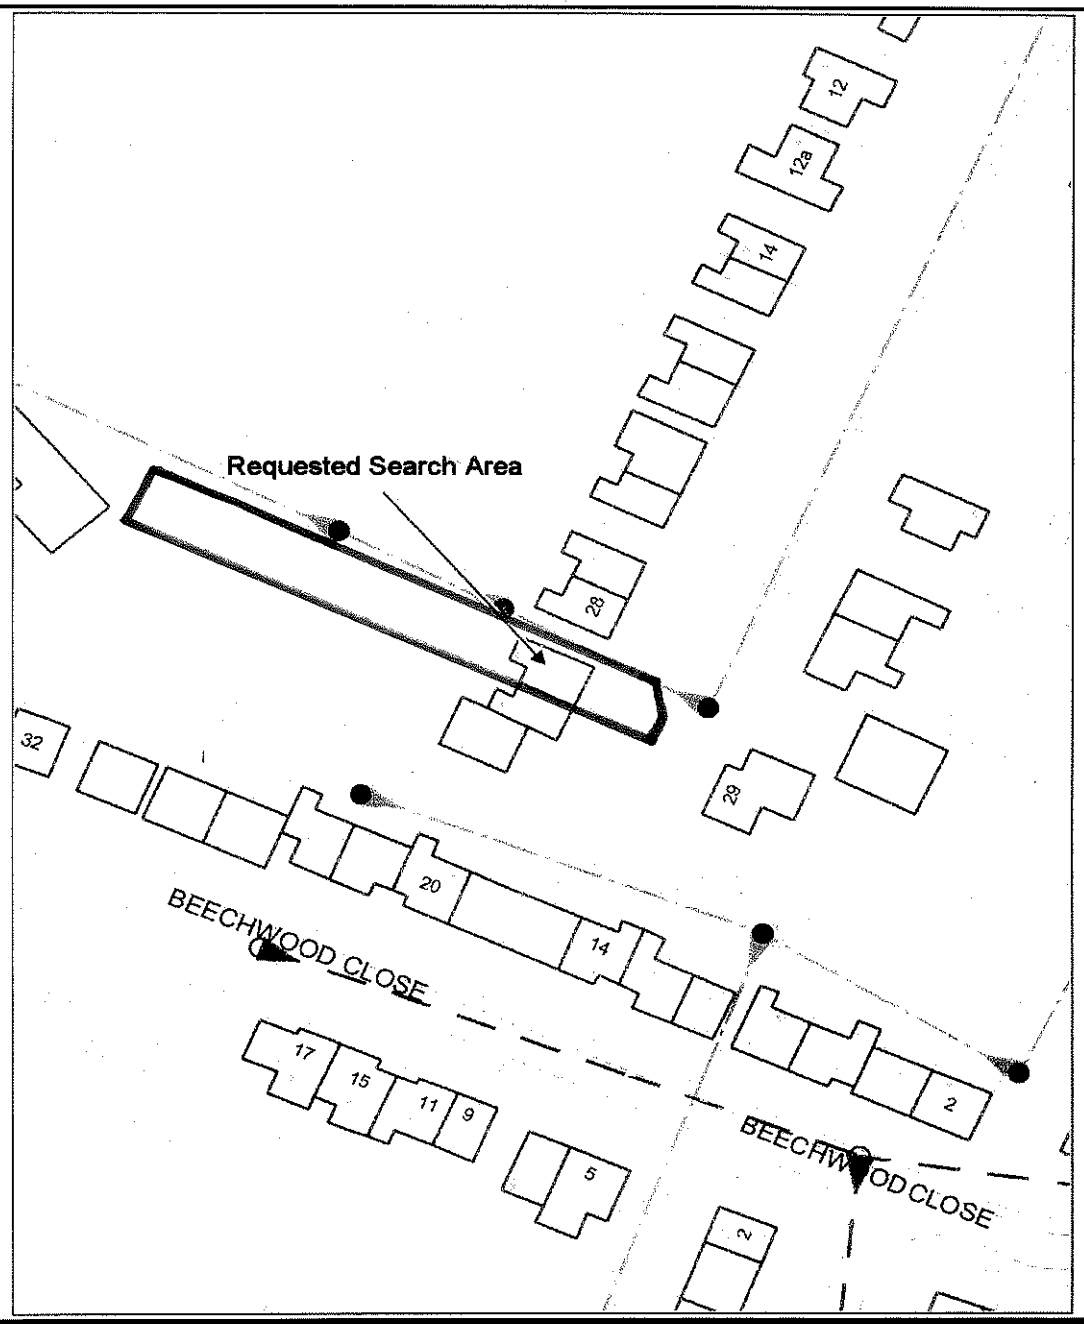

- Abandoned Gravity Sewer
- Private Combined Gravity Sewer
- Private Foul Gravity Sewer
- Private Surface Water Gravity Sewer
- Public Combined Water Gravity Sewer
- Public Foul Gravity Sewer
- Public Surface Water Gravity Sewer
- Trunk Combined Gravity Sewer
- Trunk Foul Use Gravity Sewer
- Trunk Surface Water Gravity Sewer
- Abandoned Pressurised Sewer
- Combined Use Pressurised Sewer
- Foul Use Pressurised Sewer
- Surface Water Pressurised Sewer
- Highway Drain
- Blind Shaft
- Combined Use Manhole
- Disposal Site
- Flushing Chamber
- Foul Use Manhole
- Grease Trap
- Head Node
- Hydrobrake
- Lamphole
- Outfall
- Overflow
- Penstock
- Petrol Interceptor
- Sewage Treatment Works
- Sewer Blockage
- Sewer Chemical Injection Point
- Sewer Collapse
- Sewer Junction
- Sewerage Air Valve
- Sewerage Hatch Box Point
- Sewerage Isolation Valve
- Soakaway
- Surface Water Manhole
- Vent Column
- Waste Water Storage
- Culverted Watercourse
- Access Right
- Sewer Pumping Facility
- Sewer Facility Connection *(Sewer Pumping Facility Inlet/Outlet Sewer Treatment Works Inlet/Outlet)*

All Private Sewers are shown in magenta
All Section 104 sewers are shown in green, using the same line style as private sewers

Severn Trent Water

Severn Trent Water Limited
Waterworks Road
Edgbaston
Birmingham B16 9DD
Telephone: 0121 452 3306

SEWER RECORD

Date of Issue: 22.11.2007 for **30 Green Lane, Blythe Bridge, Stoke on Trent,**

1. **Do not scale off drawing:** This plan is furnished as a general guide and no warranty as to its correctness is given or implied. This plan must not be relied upon in the event of excavations or other works in the vicinity of the company's assets.
2. The material contained in this drawing has been based upon the Ordnance Survey Map by SEVERN TRENT WATER Ltd. by permission of Ordnance Survey on behalf of the Controller of Her Majesty's Stationery Office. © Crown Copyright - SEVERN TRENT WATER Ltd. - **WU298522**
3. Document users other than SEVERN TRENT WATER business users are advised that this document is provided for reference purpose only and no further copies should be made from it.

Reference:	08/00898/FUL Forsbrook



Scale : 1:1250

© Crown copyright. All rights reserved.
Staffordshire Moorlands District Council.
Licence no. 100018384. 2007.

Organisation	SMDC
Department	Planning
Comments	